


SITE PLAN

for : A. D. SIDLEY INC.
CLIENT

20 WATERFORD LN. FAIRBURNVILLE
ADDRESS STREET CITY

A2 RIVERSIDE COURT

SUBLOT No. SUBDIVISION NAME VOL. PAGE
LOT, TRACT OHIO

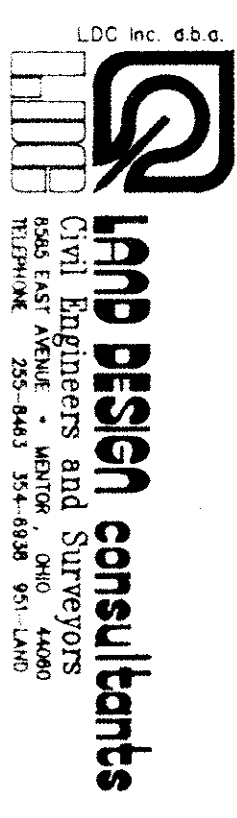


DESIGN CERTIFICATION

THIS PLAT WAS PREPARED BY ME AND IS CORRECT TO THE BEST OF MY KNOWLEDGE AND BELIEF.

W. J. K. K.
NAME

CHECK LIST

LOT DIMENSIONS & BEARINGS
TO NEAREST STREET
SUBLOT No. (PARCEL No.)
SURROUNDING OWNERS
STREET DIMENSIONS, REAR YARD
FINISHED GRADES
DRIVE & APRON TYPE, WIDTH, THICKNESS
SIDEWALK TYPE, DIAM., LENGTH
CULVERT TYPE, DIAM., LENGTH
WATER MAIN SIZE, LOCATION
SAN. MAIN SIZE, LOCATION
SAN. MAIN CAST ELEV., INV. ELEV.
SAN. COUL. SIZE, & GRADE, LOC.
STORM SEWER SIZE, & GRADE, LOC.
STORM MH. CAST ELEV., INV. ELEV.
PAV'T TYPE, GRADE, CURBS
SEPTIC SYSTEM & DUPLICATION
WELL LOCATION & ISOLATION RADIUS

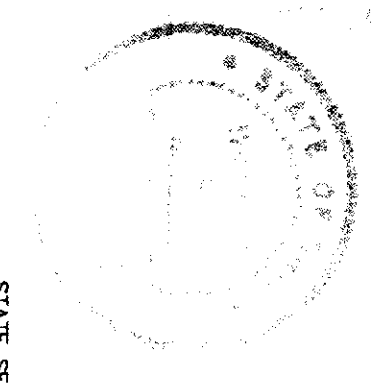

"AS BUILT" CERTIFICATION

I HEREBY CERTIFY THAT THE CIRCLED INFORMATION IS EXISTING AS OBTAINED ON THE SITE
19 AND IS CORRECT TO THE BEST OF MY KNOWLEDGE AND BELIEF.

NAME

LEGEND


STORM MANHOLE
SANITARY MANHOLE
EXISTING CONTOURS
PROPOSED CONTOURS
EXST. ELEV. 100.0
DIR. OF SURFACE DRAINAGE

DRAWN BY	SCALE
CHKD BY	DATE
DATE	DATE
1	2


ACCEPTED: CLIENT DATE

BENCHMARK: ELEV. 544.11 + 20 ELEV. 709.72

NOTE: DRIVE APRON TO BE 6" THICK CONC.

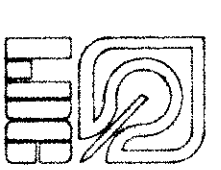

DRAWING No. 90-046

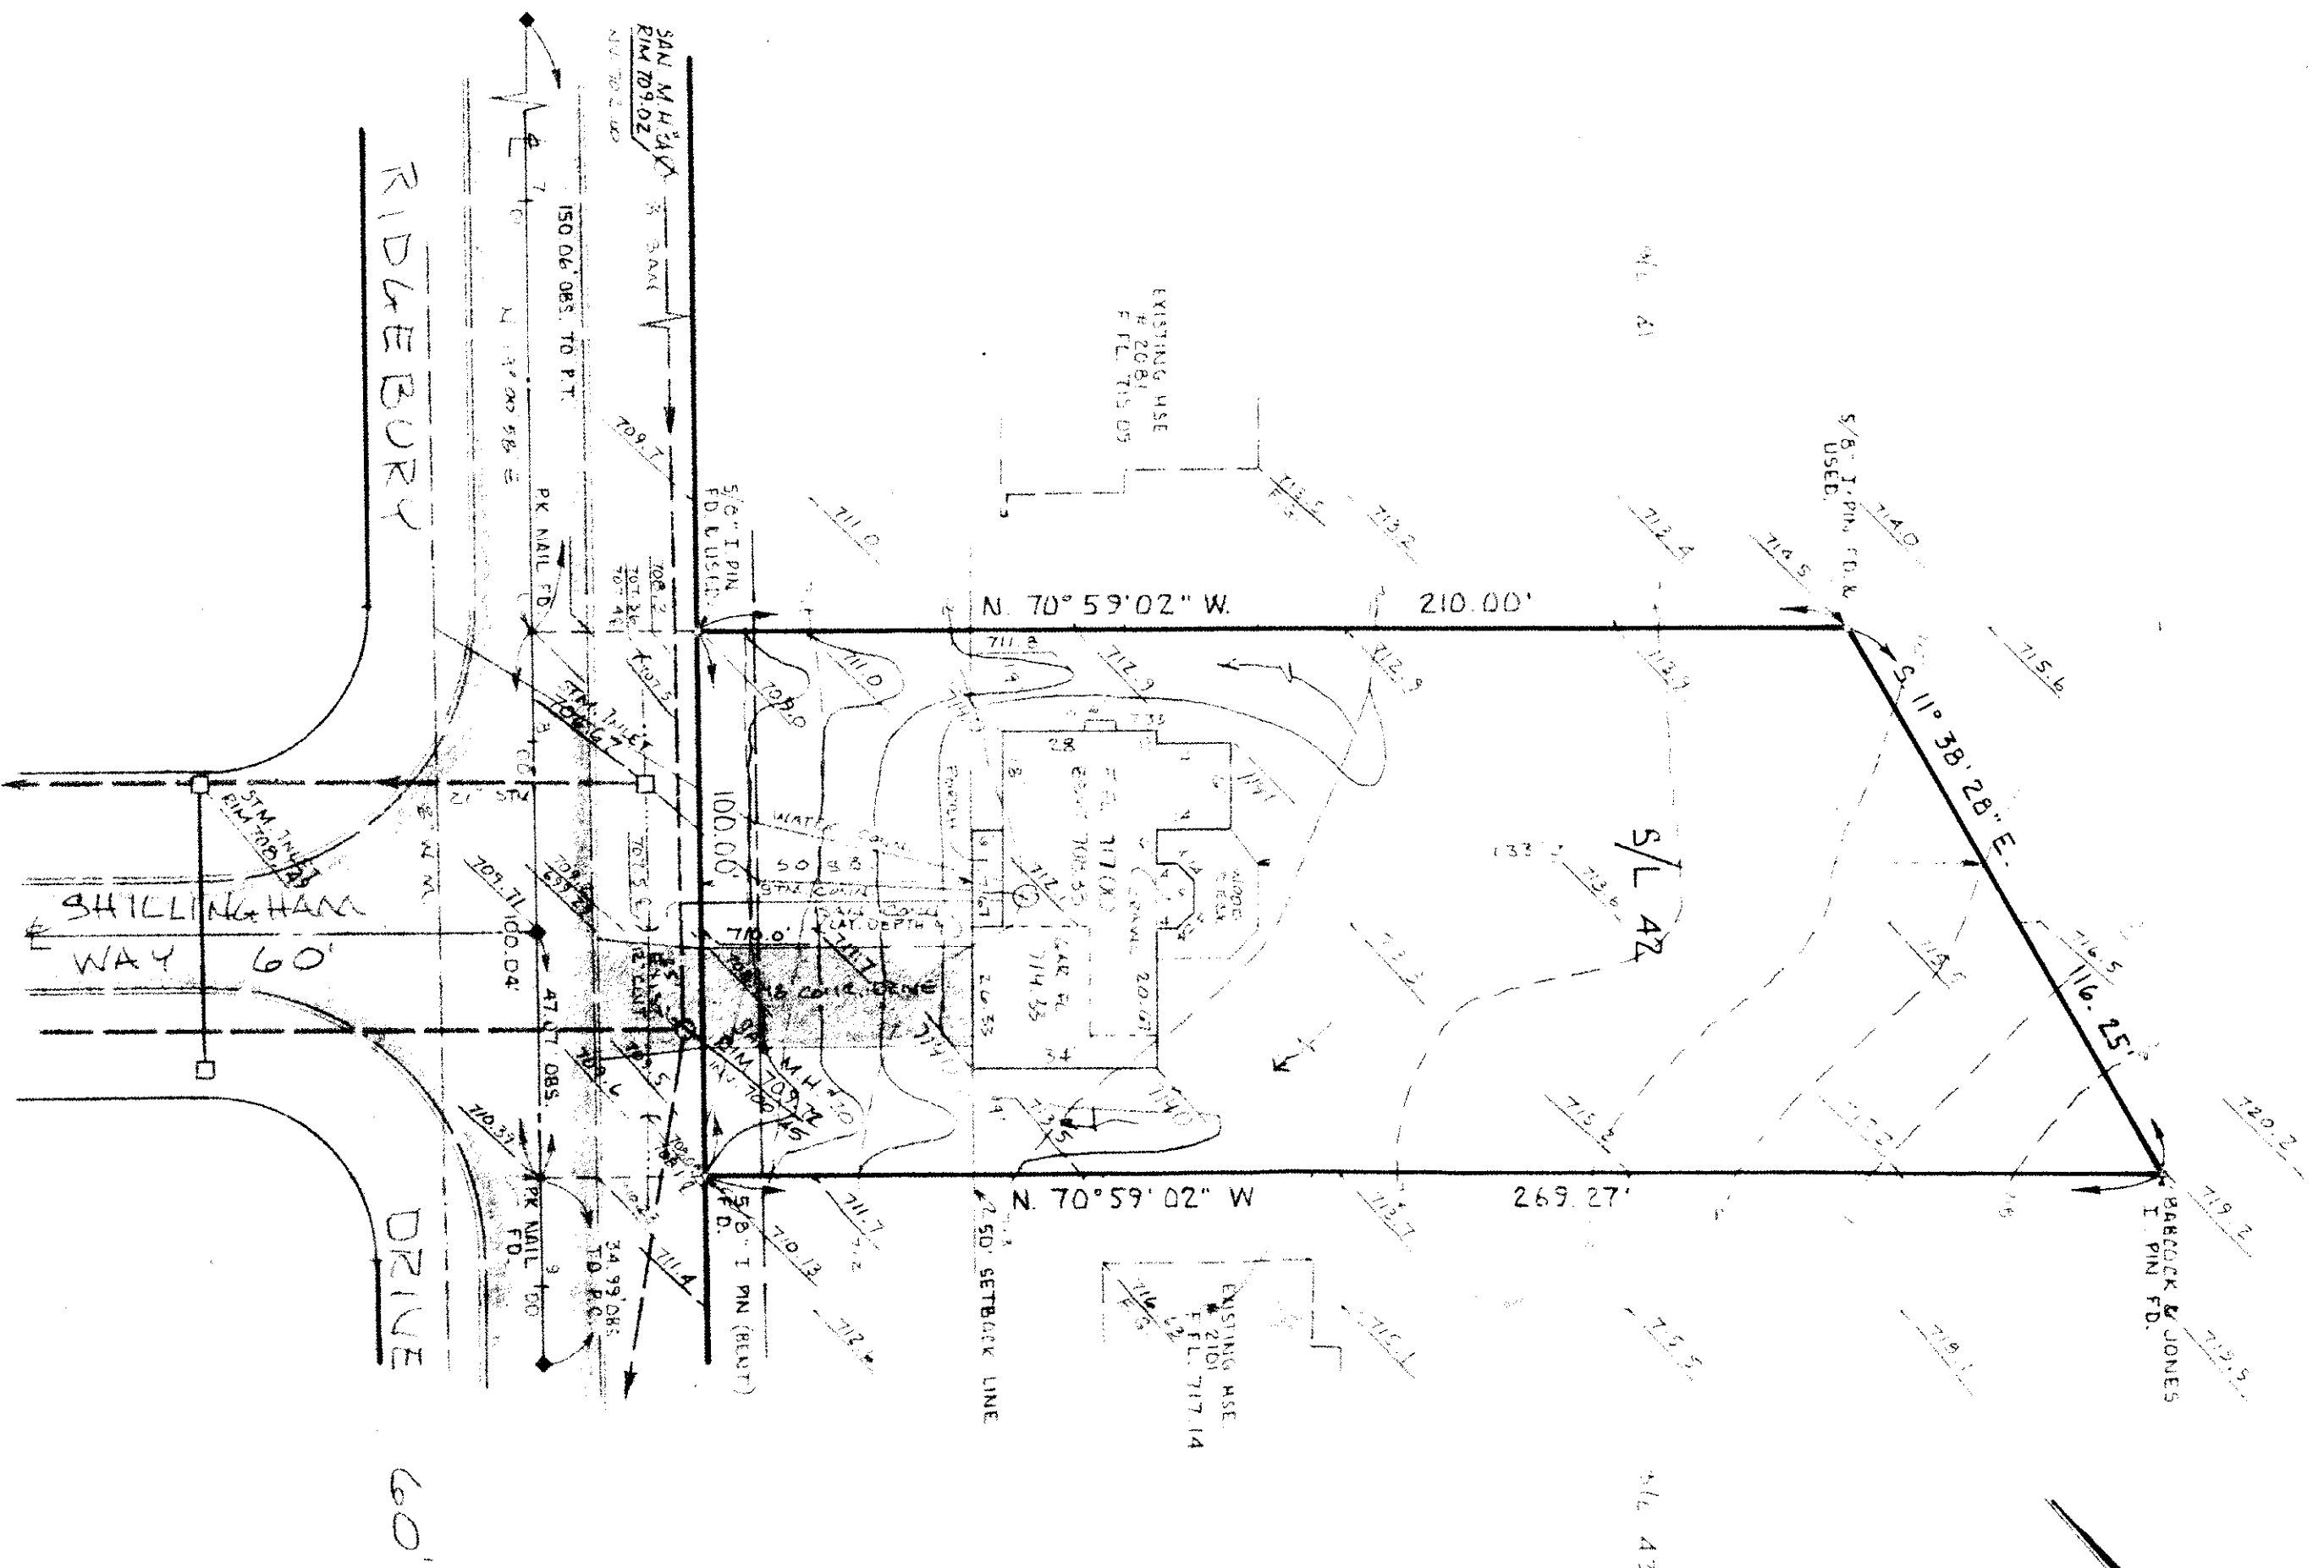

Grading Plan Approved
as shown and/or noted
THOMAS P. GILLES, P.E.
Lake County Engineer
By Date

1. CONDUCT SWAMP PUMP TO
2. DOWN STAIRS TO SPLASH BLOCKS.

41891

71485