

I, the undersigned hereby certify that this topography, indicated by 1" contours, and elevations shown hereon represent an actual field survey made by me on Oct 26, 1914 and that the elevations were taken at appropriate intervals and that as of that date they existed as indicated hereon.

J.W. Coffey, Jr.



OCT 27, 1914

SCALE: 1" = 20'




AS-BUILT

TOM REED

FOR

SITE PLAN

BEING S/L 54 IN THE KINGSBOROUGH SUBDIVISION
PAINESVILLE TOWNSHIP, LAKE COUNTY, OHIO.

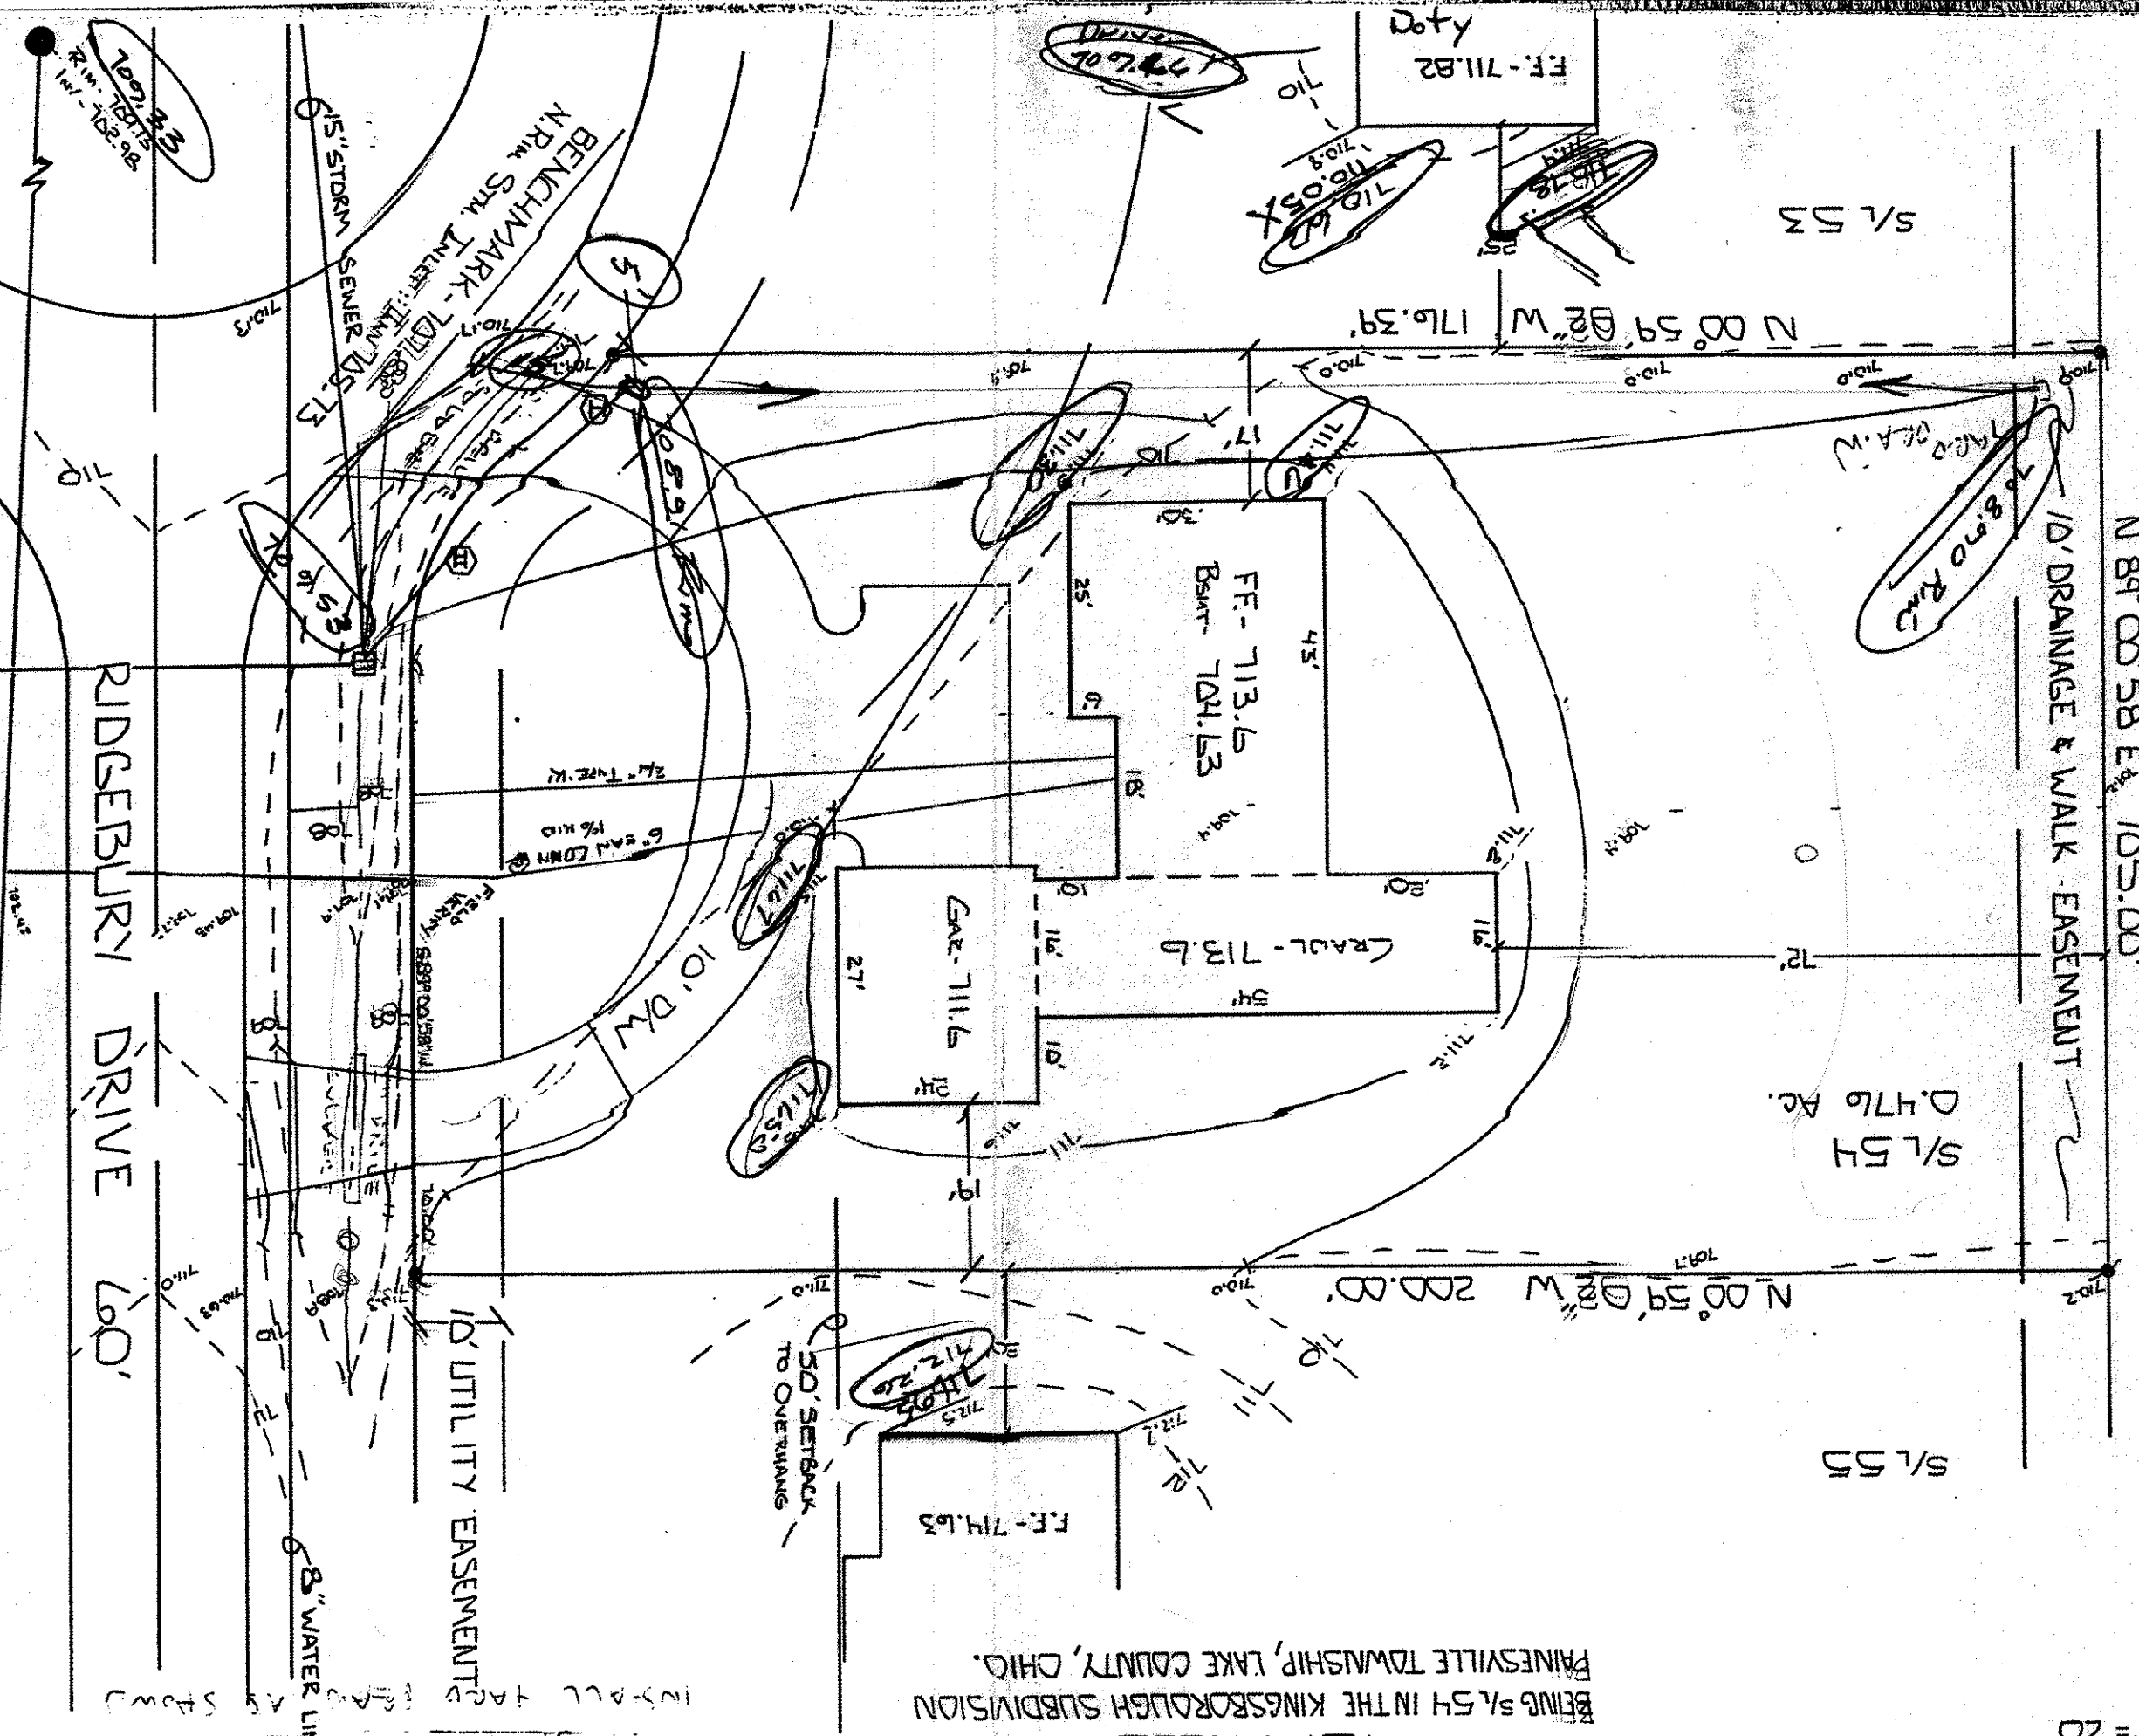

CURVE DATA
I R=70.00'
A=16.03'
C=16.00'
B=N 44° 24' 58" W
II R=30.00'
A=27.82'
C=26.83'
B=N 64° 25' 08" W

APPROVED
PAINESVILLE TOWNSHIP
ZONING DEPARTMENT

11/1/14

VILLAGE SURVEYING CO.
P.O. BOX 10916 FAIRPORT HARBOR, OHIO 44071
(216) 357-1359