


I, the undersigned hereby certify that this topography, indicated by 1' contours and elevations shown hereon represent an actual field survey made by me on Oct 26, 1994 and that the elevations were taken at appropriate intervals and that as of that date they existed as indicated hereon.


J.M. Coffey, P.E.

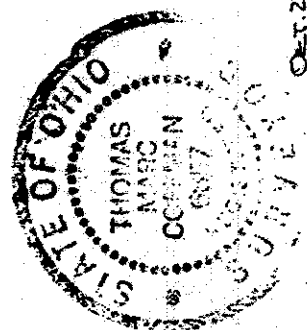

SCALE: 1"=20'

SITE PLAN FOR TOM REED BEING S/L 54 IN THE KINGSBOROUGH SUBDIVISION PAINESVILLE TOWNSHIP, LAKE COUNTY, OHIO.

6/14 11/5/94
INSTALL TARP DRAW AS SHOWN

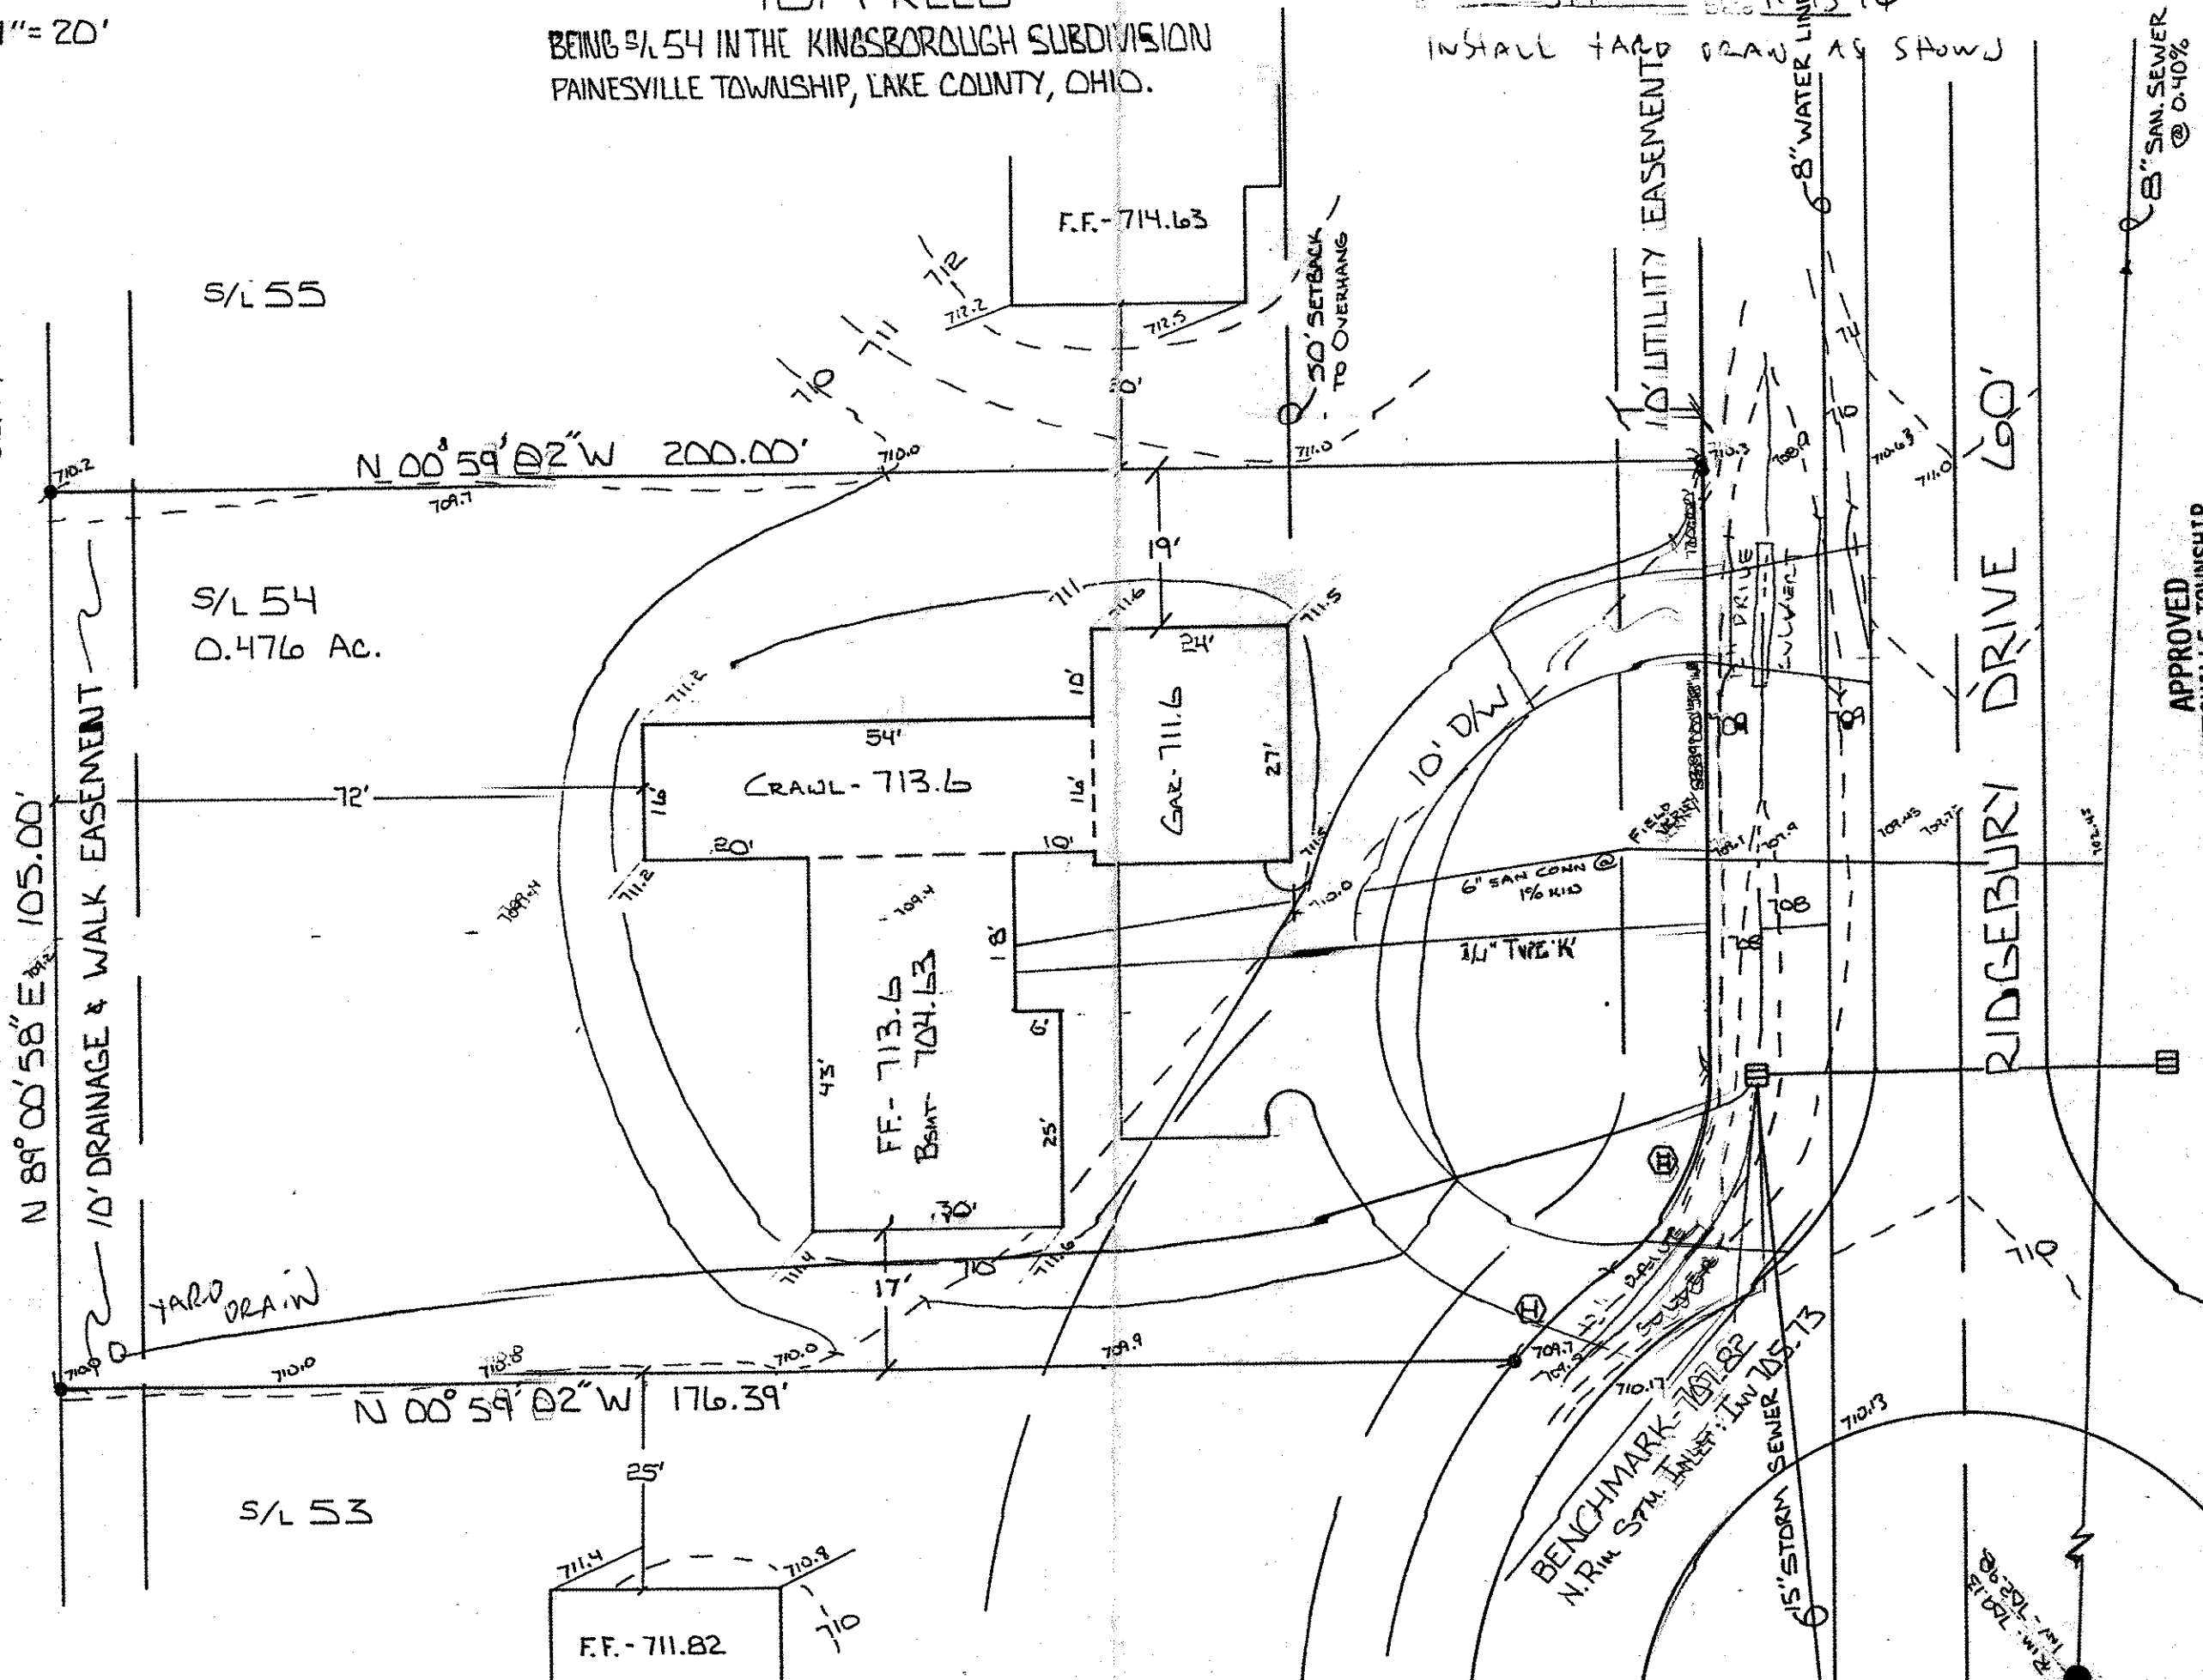

APPROVED
PAINESVILLE TOWNSHIP
ZONING DEPARTMENT

11/1/94

VILLAGE SURVEYING CO.
P.O. BOX 10916 FAIRPORT HARBOR, OHIO 44077
419-357-1359

CURVE DATA

①	R=70.00'	②	R=30.00'
	A=16.03'		A=27.82'
	C=16.00'		C=26.83'
	B=N 44° 24' 58" W		B=N 164° 25' 08" W