


ORIGINAL SURVEY	SURVEYED	DATE
NOTE BOOK	PILOTED	
NO.	TEMPLATE	
RE	AREAS	
	AREAS CHECKED	

FINAL SURVEY	SURVEYED	DATE
NOTE BOOK	PILOTED	
NO.	TEMPLATE	
	AREAS	
	AREAS CHECKED	

BRIDGECREST DRIVE

PRO RESIDENCE NO. 20
FF 802.00
GAGE 744.00

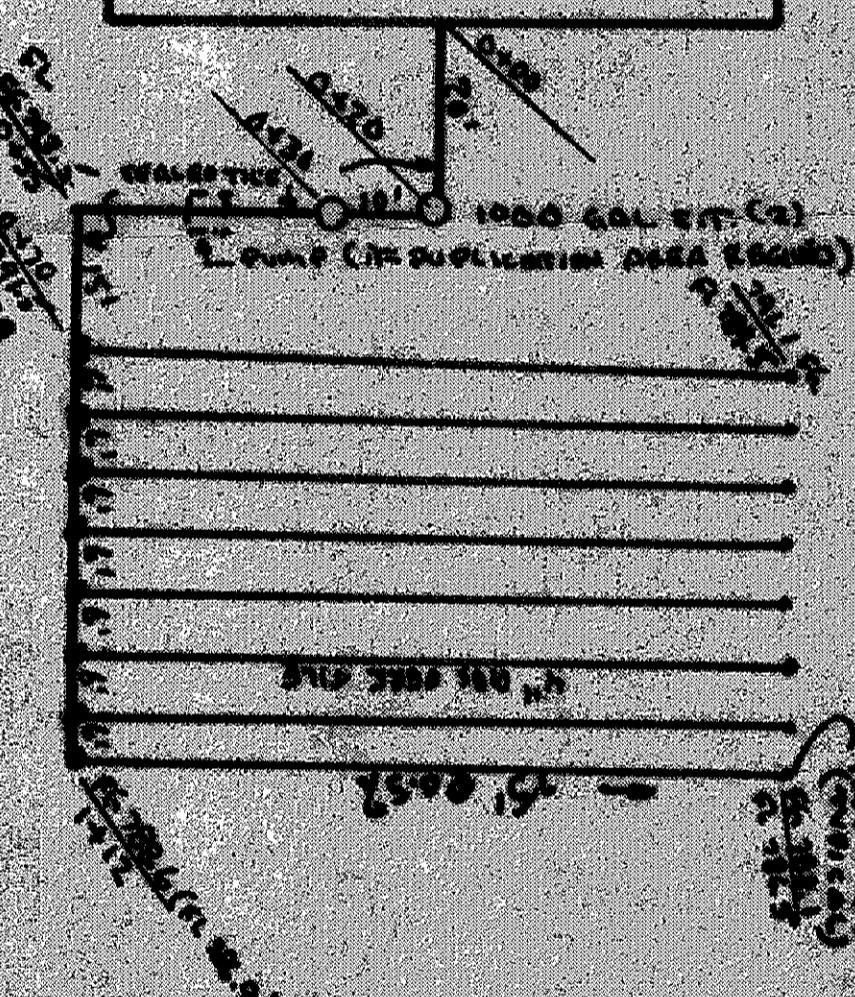

SCALES
1:100
1972-11-11