

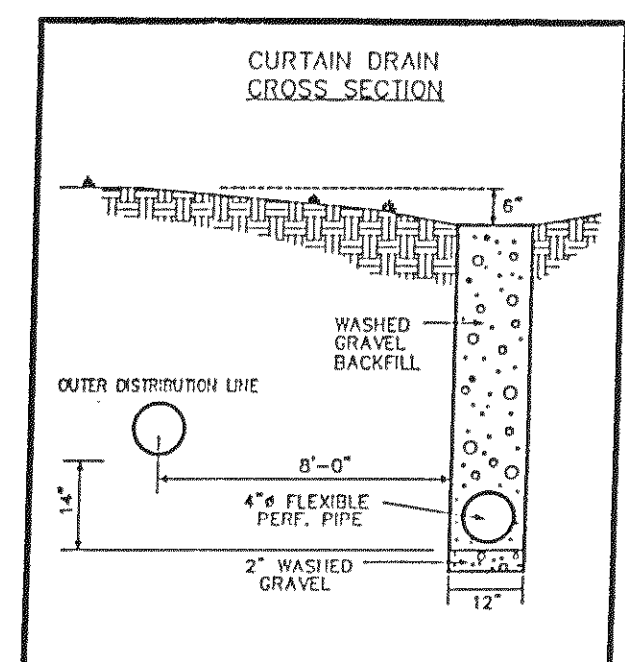
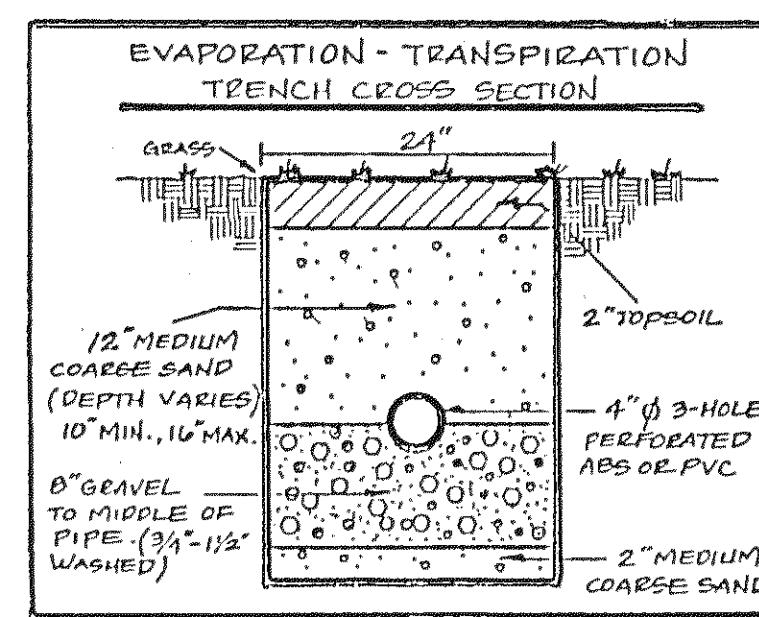


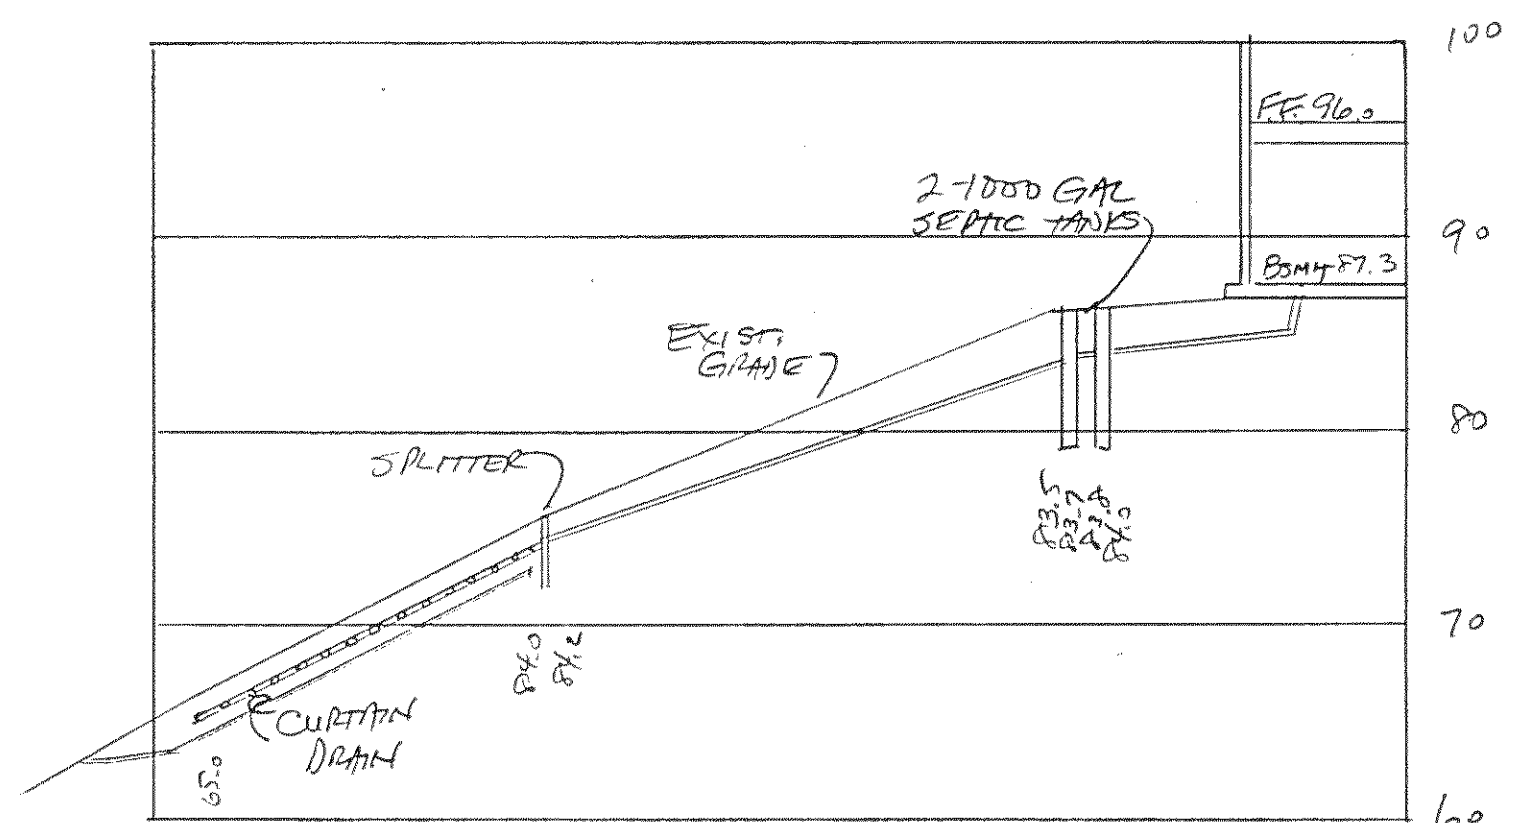

REVIEWED AND ACCEPTED
LAKE COUNTY GENERAL
HEALTH DISTRICT

DATE 7-9-02
Natalie B. Norris

SEWER/STORMWATER/UTILITY/STRUCTURE
(CONTAINED AND EXISTING UTILITIES)
AND THEREFORE FOR INSTALLATION AS
SHOWN

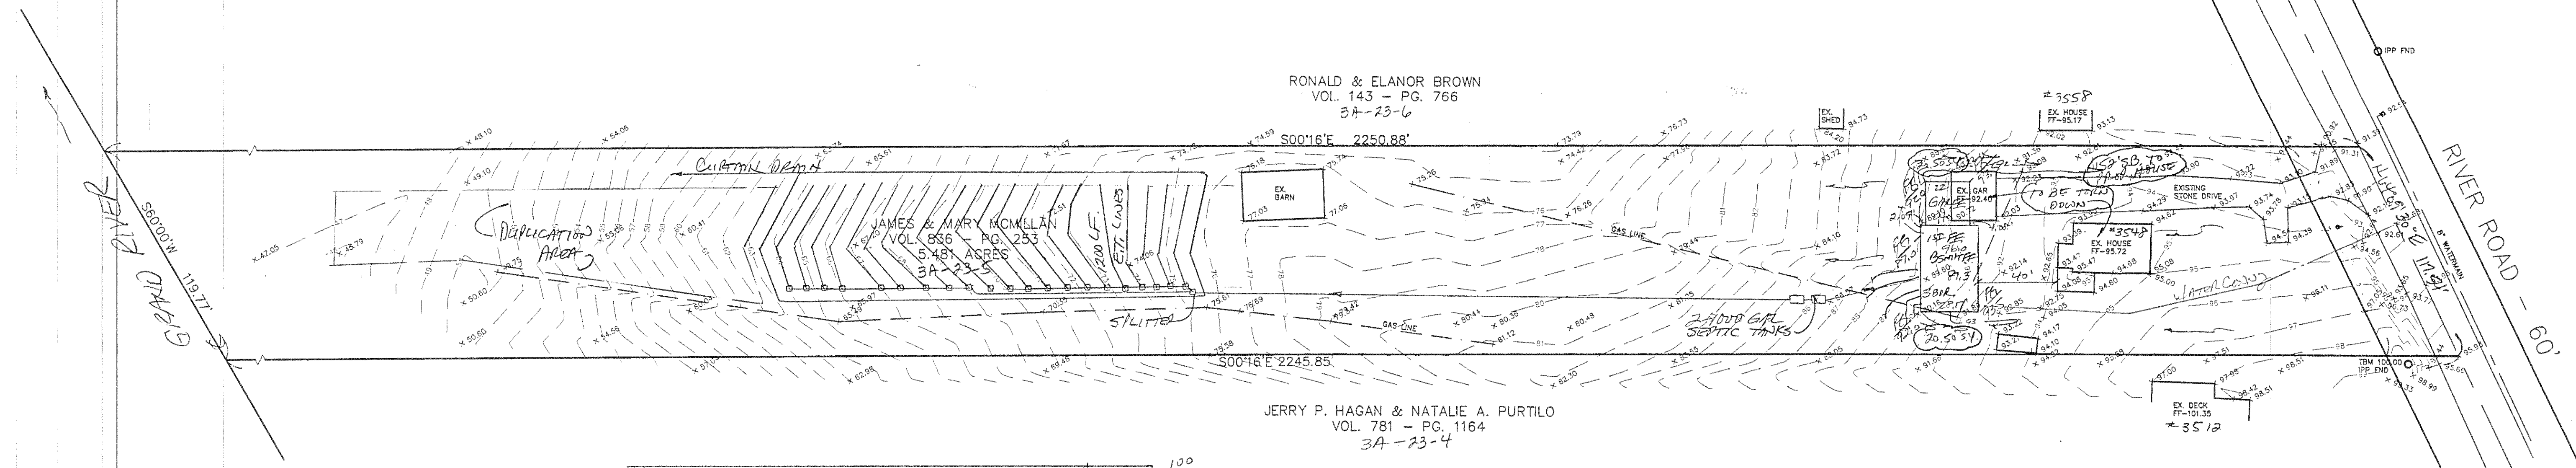

HYDRAULIC PROFILE
HORIZ: 1"=40' VERT: 1"=10'

APPROVED
SIDE LINES & SET BACK
PERRY TOWNSHIP ZONING
PERMIT NO. 7293
ZONING INSPECTOR

Grading Plan Approved
as shown and/or noted
JAMES R. GILLIS, P.E.
Lake County Engineer
By 614 Date 8/7/02


"I, the undersigned hereby certify that
the size and location, both horizontal and vertical,
of the underground utilities shown hereon,
represent an actual field survey made by
me on the 7th day of June, 2002,
and that the elevations were taken at
appropriate intervals and that as of that
date they existed as indicated hereon."

Name: Harry Jones #6343 Reg. No.

TBM IRON PIPE
ELEV=100.00

EXISTING UTILITIES NOTE:
THE SIZE AND LOCATION, BOTH HORIZONTAL AND VERTICAL,
OF THE UNDERGROUND UTILITIES SHOWN HEREON, HAVE BEEN
OBTAINED BY A SEARCH OF AVAILABLE RECORDS.
VERIFICATION BY FIELD OBSERVATION HAS BEEN CONDUCTED
WHERE PRACTICAL, HOWEVER, BABCOCK, JONES AND ASSOCIATES
INC. DOES NOT GUARANTEE THE COMPLETENESS NOR ACCURACY
THEREOF.

Approved
File #PESL20168
Date 8/1/02
Lake SWCD

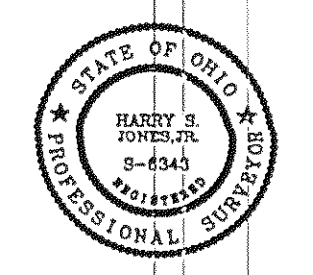

REV NO.	DESCRIPTION	DATE	BY	CHK'D

babcock, jones and associates, inc
CIVIL ENGINEERS - SURVEYORS - LAND PLANNERS
PAINESVILLE OHIO 44077

DATE 6/13/02
DESIGN BY HJ
DRAWN BY NS
APPROVED BY HJ

SITE PLAN
FOR
JAMES MCMILLAN
PERRY TOWNSHIP LAKE COUNTY

SCALE 1"=40'
JOB NO 02-129
SHEET 1 OF 1
HJ HJ