



SITE PLAN
FOR
R. C. REED CONST.
BEING A PART OF LOT 25, IN THE
TOWNSHIP OF PERRY COUNTY OF LAKE
STATE OF OHIO (SOUTH RIVER RD.)

1" = 30'
EXIST
PROP
ELEV
VAND

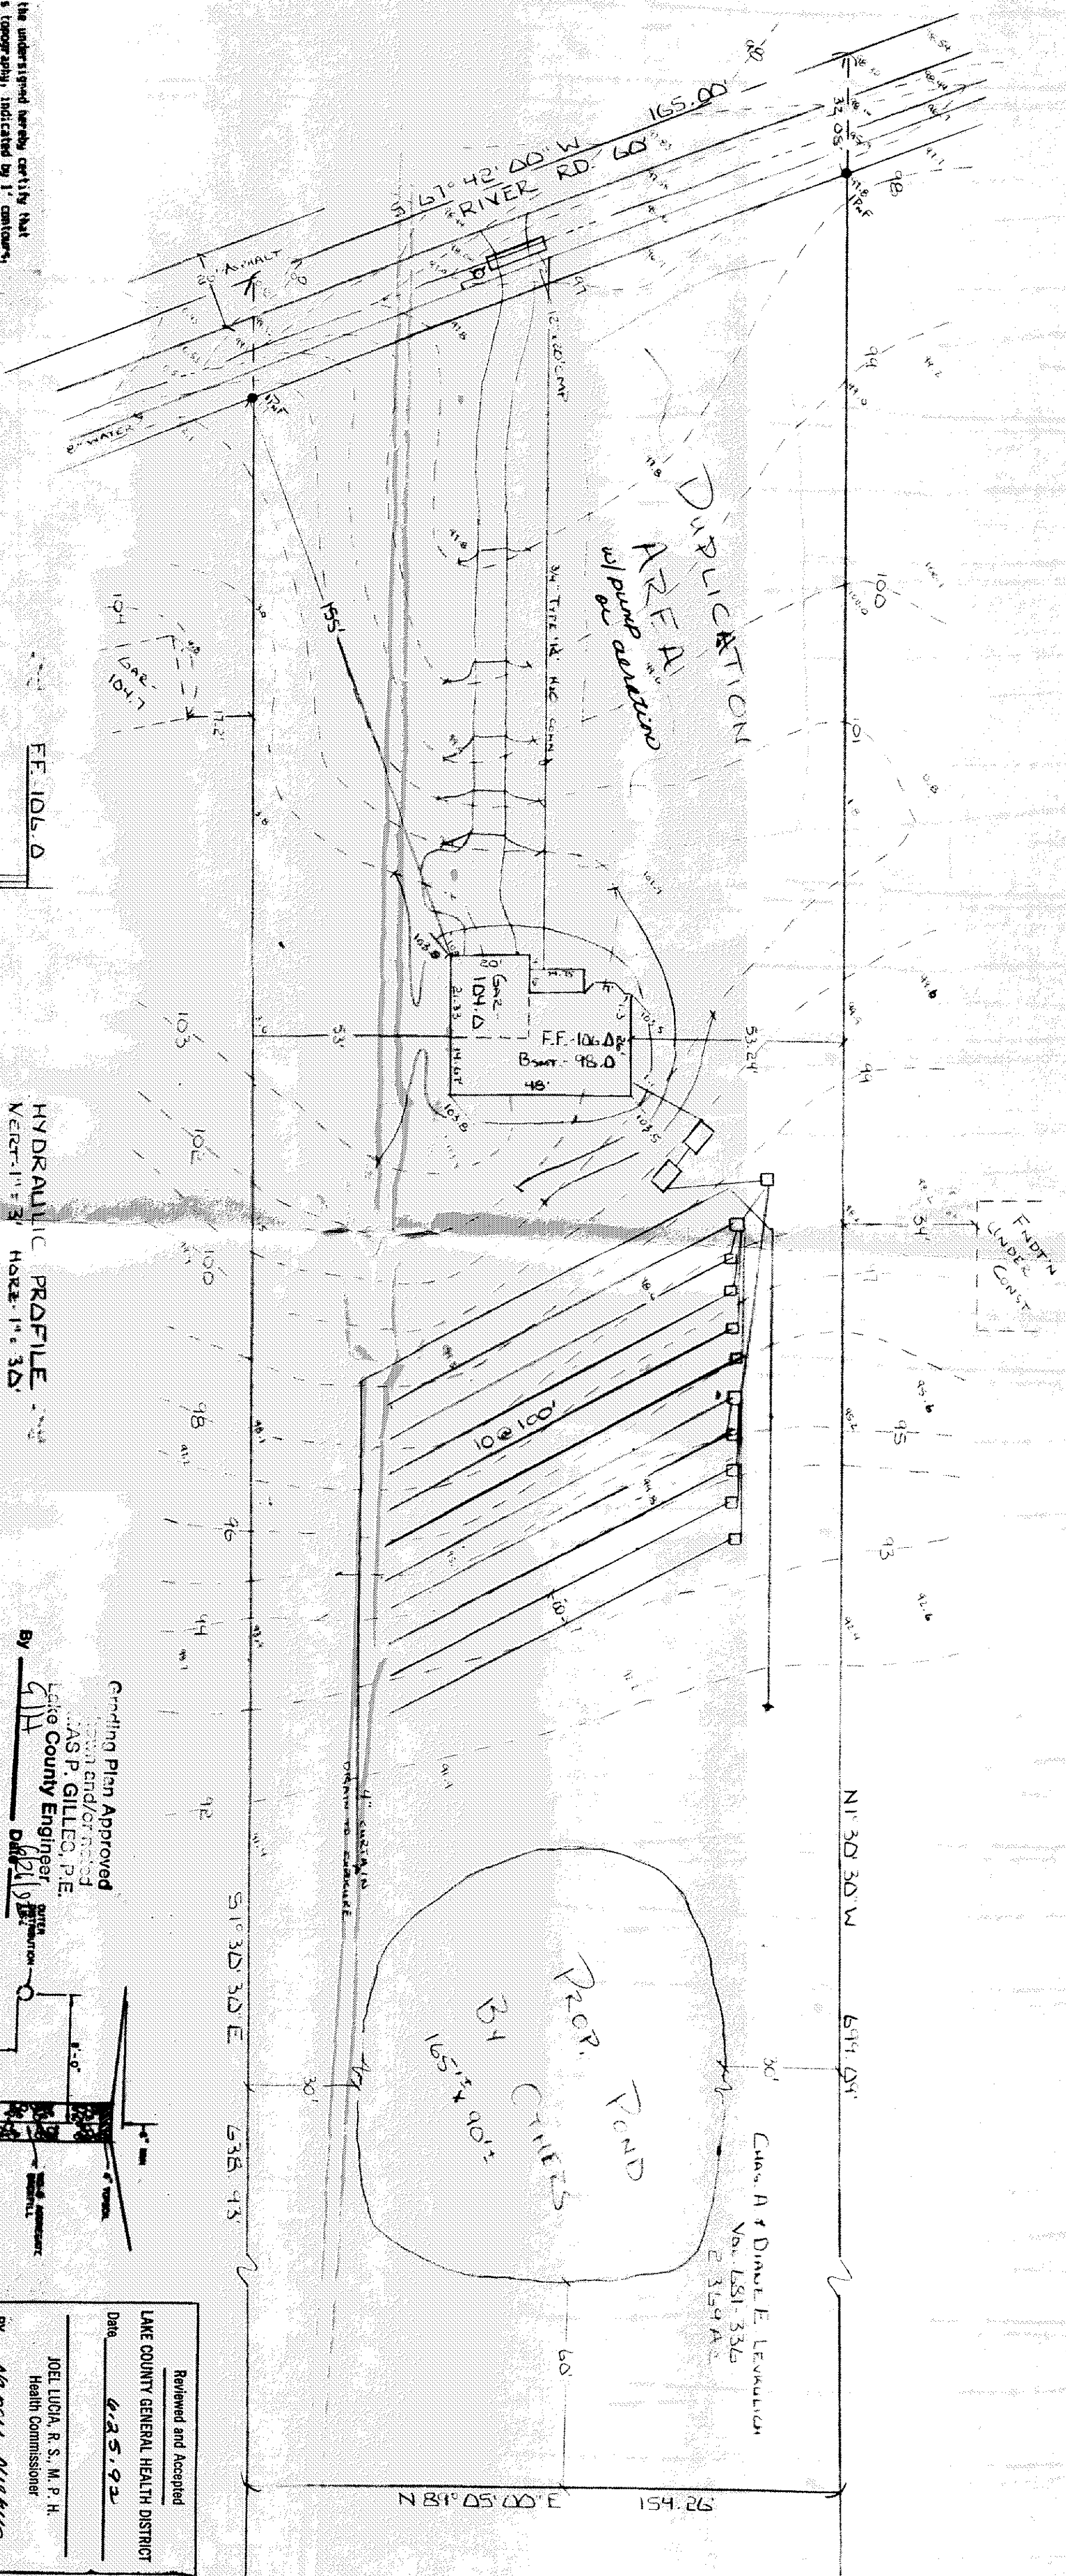

I, the undersigned hereby certify that this topography, indicated by 'I' contours, and elevations shown herein represent an actual field survey made by me on June 2, 1992, and that the elevations were taken at appropriate intervals and that as of that date they existed as indicated herein.


J. M. O'Connell
No. 6857

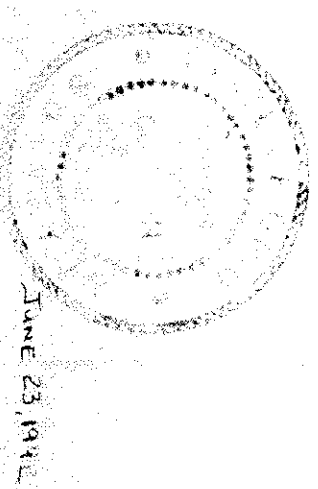

HYDRAULIC PROFILE
VERT. 1" = 3' HORIZ. 1" = 30'
3 BEDROOM HOME

APPROVED
SIDE LINES & SET BACK
PERRY TOWNSHIP ZONING
PERMIT NO. 4633
ZONING INSPECTOR *Don King*


Grading Plan Approved
AS P. GILLES, P.E.
Lake County Engineer
Date 6/21/92

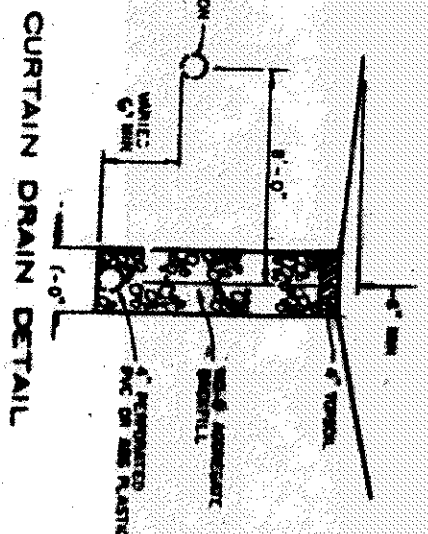

Reviewed and Accepted
LAKE COUNTY GENERAL HEALTH DISTRICT
Date 6-25-92
JOEL LUCIA, R.S., M.P.H.
Health Commissioner
By Nancy Nunnus

- A. To be brought to finished grade
1. Septic tank manhole covers
2. Splitter box cover
3. Distribution box cover
- B. No footer drains or downspouts
-to be discharged into septic tanks
- C. All waste water to be discharged into septic tanks

LOW YIELD WATER
FIXTURES REQUIRED
ON ALL:
Shower Head
Toilet

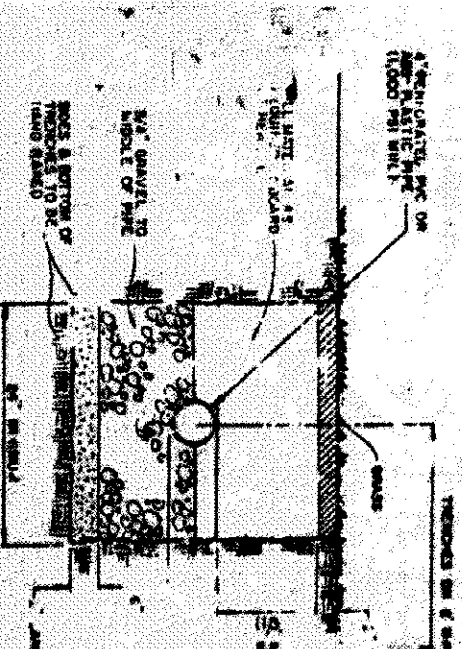

EVAPORATION-TRANSPARATION
TRENCH DETAIL

- ① water ET lines
on contour
- ② A grade is
measured over the
top of the curtain
down - high side

VILLAGE SURVEYING CO
202 THIRD ST., FAIRPORT HBR., OH 44137
(216) 357-1359

SEWAGE DISPOSAL PERMIT MUST BE
OBTAINED BY A LAKE COUNTY LICENSED
INSTALLER BEFORE INSTALLATION IS
STARTED