

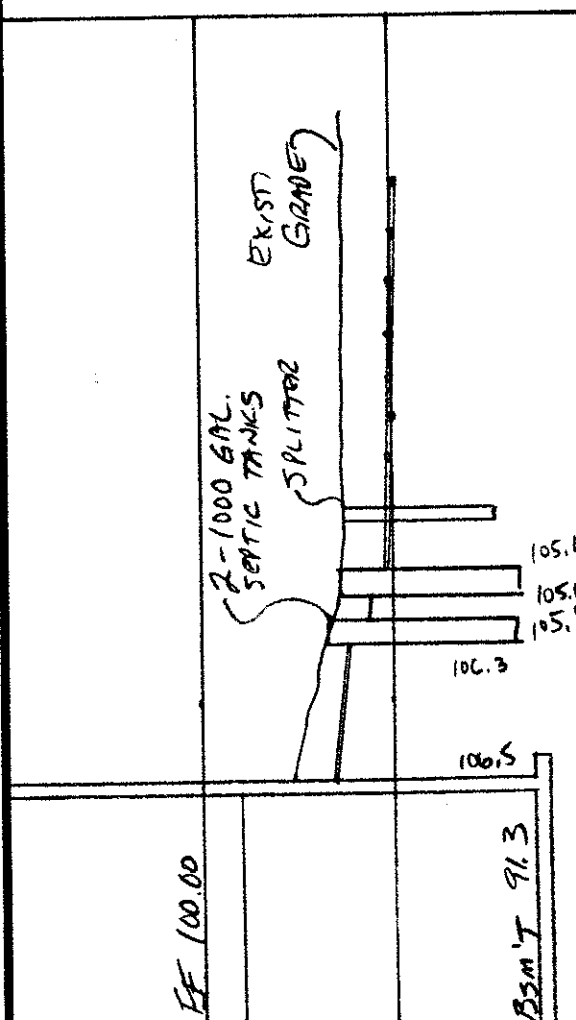
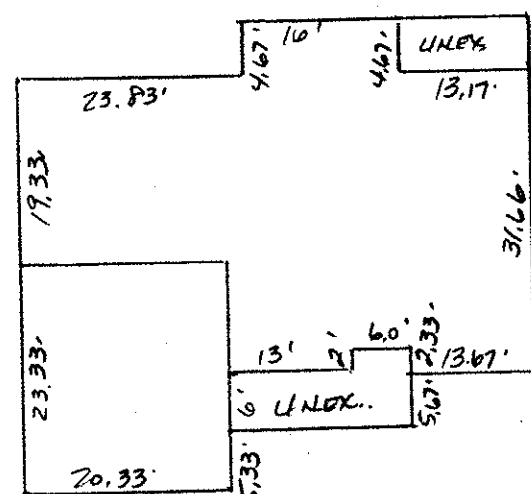


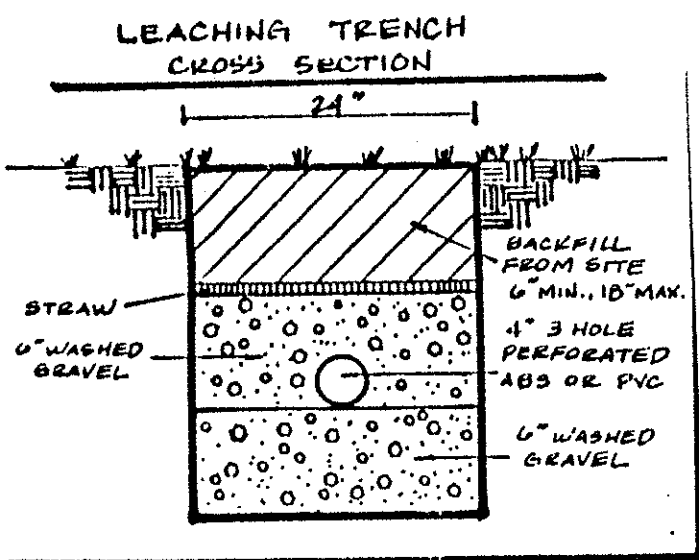

HYDRAULIC PROFILE
SCALE: HORIZ 1"=40'
VERT 1"=5'

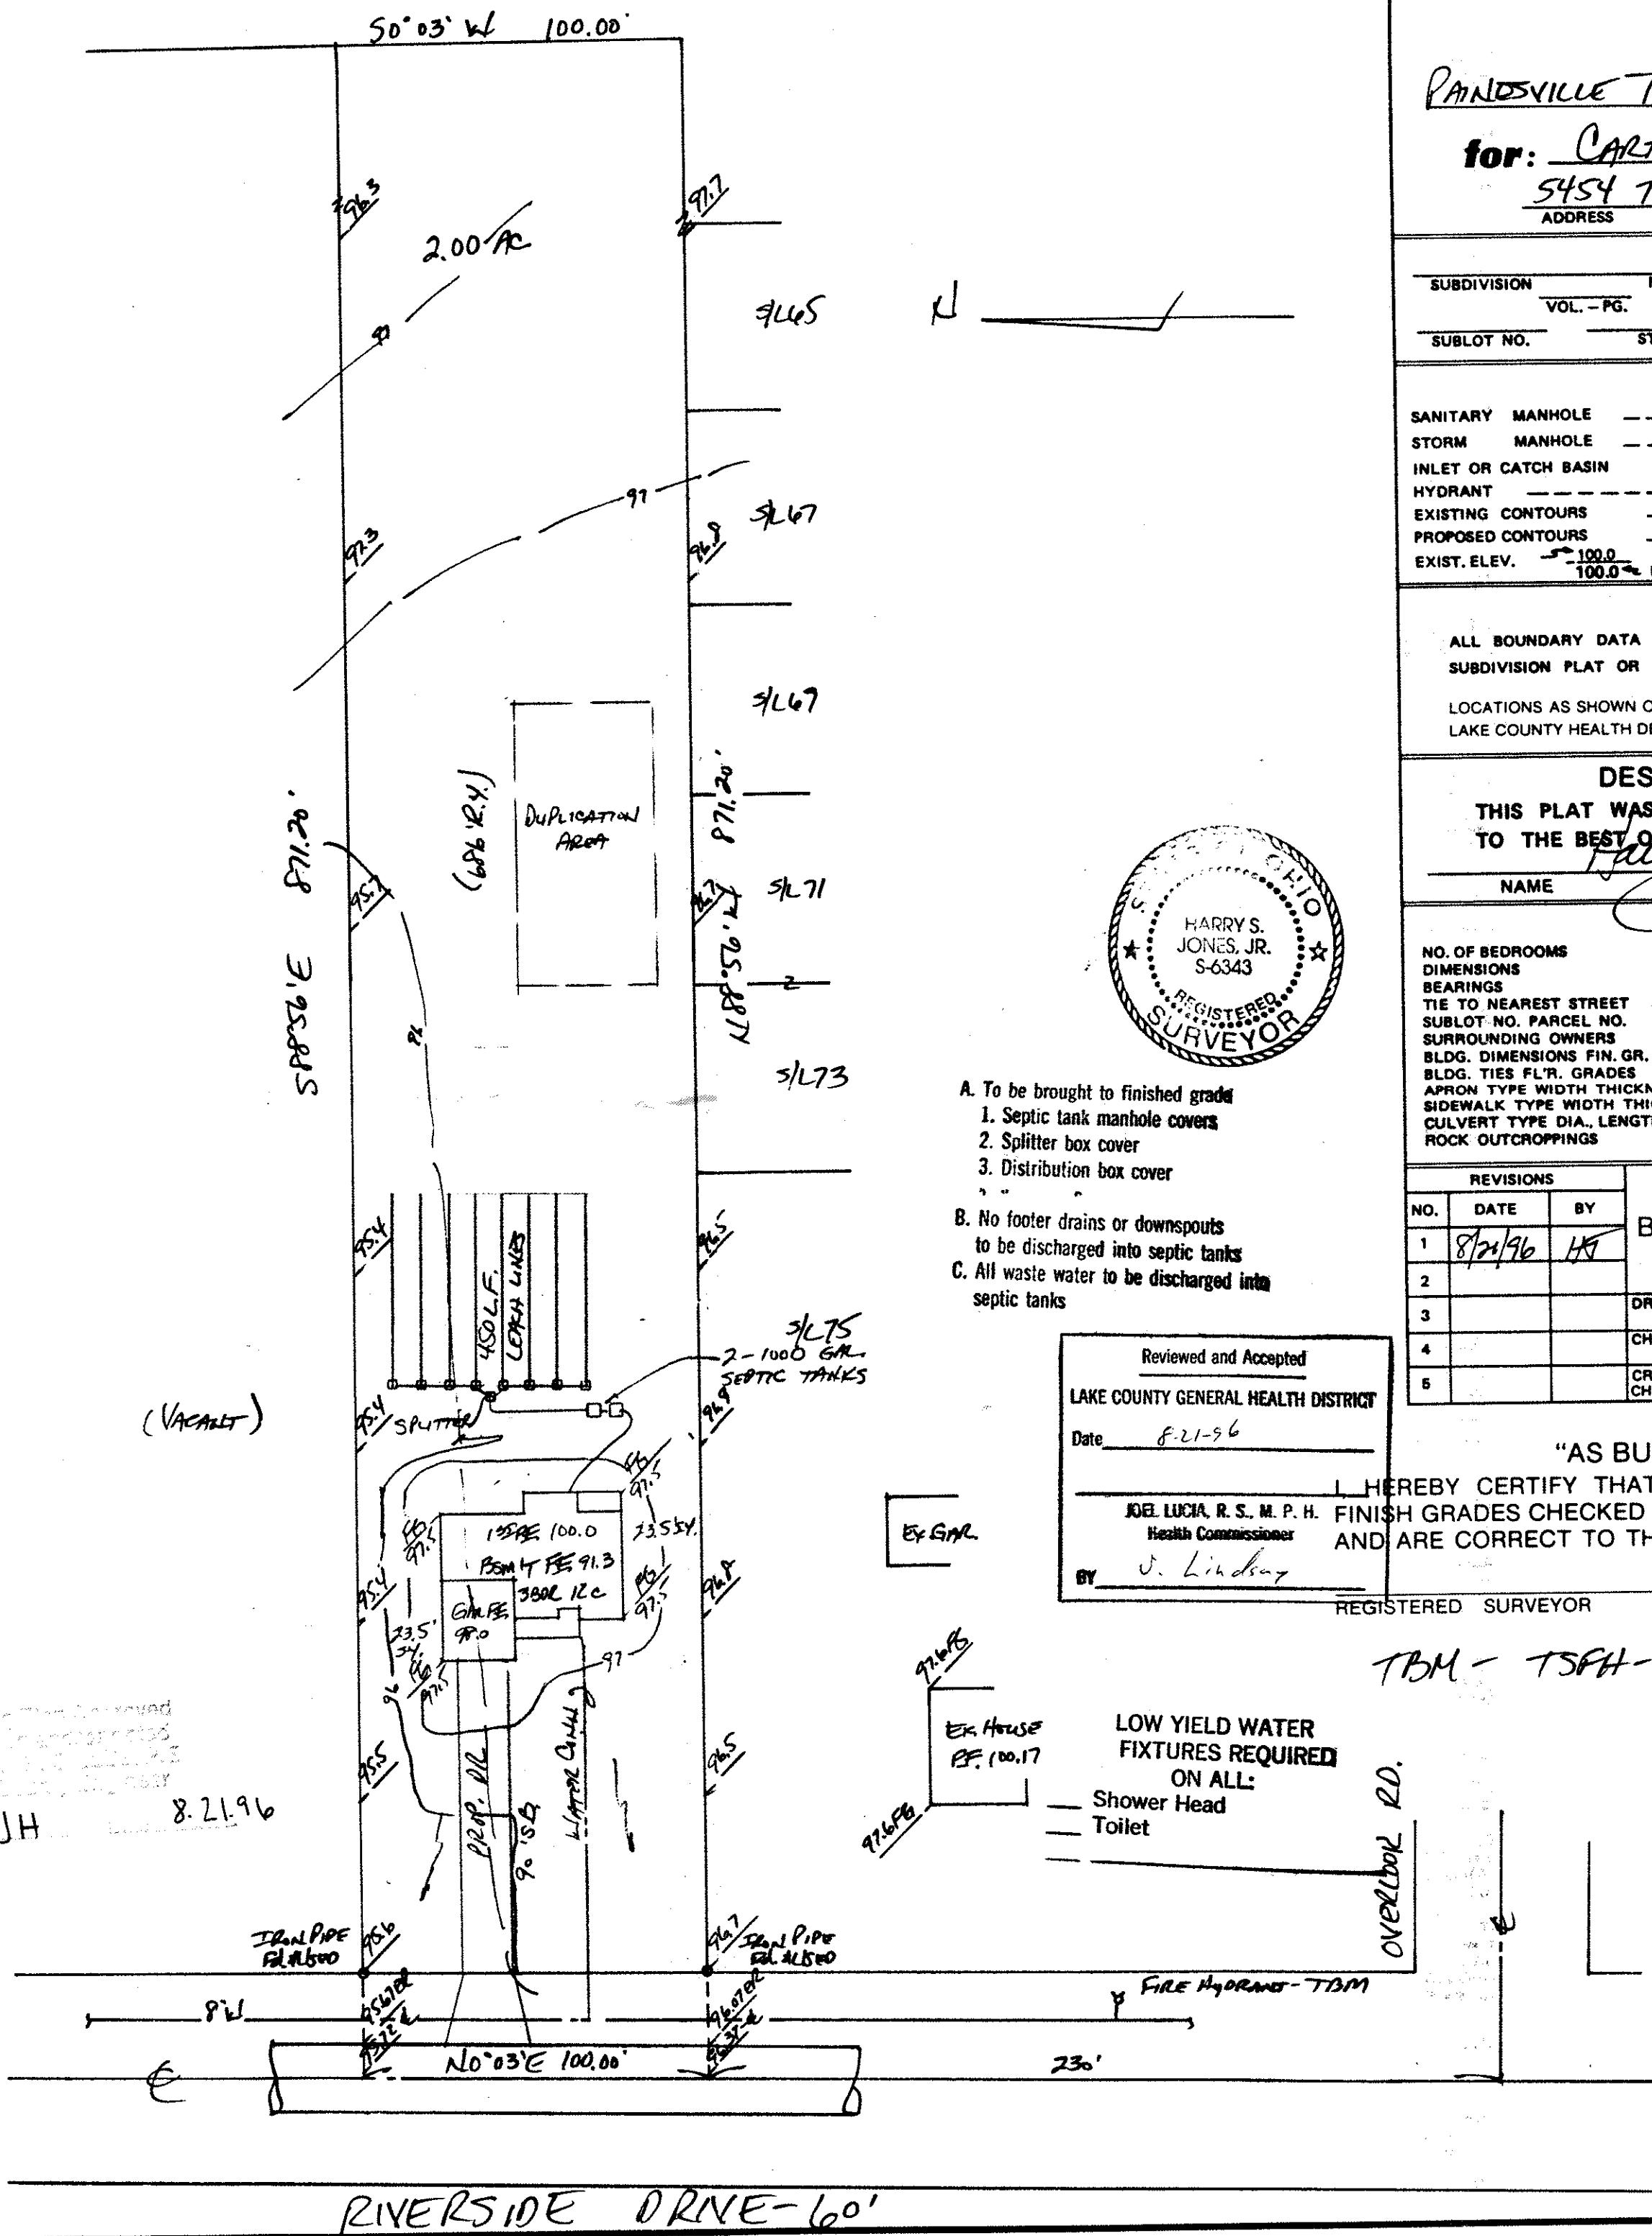

SITE PLAN
PAINESVILLE TOWNSHIP, LAKE COUNTY, OHIO
for: CAROL WAITE 350-1435
CLIENT OWNER
5454 TRASK ROAD, MADISON 44057
ADDRESS STREET CITY ZIP

SUBDIVISION NAME LOT 13 TRACT 891
VOL. - PG. 1187
SUBLOT NO. STREET VOLUME 11A-20F-25 PAGE 26200-01
PERM. PARCEL NO. STREET

LEGEND
SANITARY MANHOLE --- (circle with cross)
STORM MANHOLE --- (circle with dot)
INLET OR CATCH BASIN --- (square)
HYDRANT --- (circle with cross)
EXISTING CONTOURS --- (dashed line)
PROPOSED CONTOURS --- (solid line)
EXIST. ELEV. --- (number)
100.0
100.0 PROP. ELEV.
WATER VALVE (GAS) --- (circle with cross)
WATER METER (GAS) --- (circle with cross)
AS BUILT ELEVATION --- (number)
100.0
INDICATES DIRECTION OF SURFACE DRAINAGE

REMARKS
ALL BOUNDARY DATA SHOWN WAS OBTAINED FROM (DEEDS, RECORDED SUBDIVISION PLAT OR OTHER PUBLIC RECORDS)
LOCATIONS AS SHOWN OF ADJACENT WELLS AND SEPTIC TANKS OBTAINED FROM LAKE COUNTY HEALTH DEPARTMENT

DESIGN CERTIFICATION
THIS PLAT WAS PREPARED BY ME, AND IS CORRECT TO THE BEST OF MY KNOWLEDGE AND BELIEF.
NAME Tally Jones SURVEYOR REGISTRATION NO. 6343

CHECK LIST
NO. OF BEDROOMS
DIMENSIONS
BEARINGS
TIE TO NEAREST STREET
SUBLOT NO. PARCEL NO.
SURROUNDING OWNERS
BLDG. DIMENSIONS FIN. GR.
BLDG. TIES FL'R. GRADES
APRON TYPE WIDTH THICKNESS
SIDEWALK TYPE WIDTH THICKNESS
CULVERT TYPE DIA. LENGTH
ROCK OUTCROPPINGS
WATER MAIN SIZE, LOCATION
SAN. SEWER SIZE % GR. LOC.
SAN. MH. CAST. ELEV. INV. ELEV.
SAN. CONN. SIZE, LOC. DEPTH
STORM SEWER SIZE % GR. LOC.
STORM MH. CAST. ELEV. INV. ELEV.
PAV'T TYPE GRADE CURBS
GAS LINE LOC. SIZE PRESSURE
SEPTIC TANK LOCATION & DUPLICATION AREA
WELL LOCATION
ISOLATION RADIUS FROM WELL

REVISIONS			PLAN PREPARED BY:	
NO.	DATE	BY	BABCOCK • JONES & ASSOCIATES, INC.	
1	8/21/96	HT	PAINESVILLE, OHIO	
2				
3			DRAWN BY HT	SCALE 1"=40'
4			CHK'D. HT	DATE 3/18/96
5			CREW CHIEF WS	APP'D. HT
			PHONE NO. 357-1811	
			DRAWING NO. 96-054	

"AS BUILT" CERTIFICATION
I HEREBY CERTIFY THAT THE CIRCLED GRADES ARE EXISTING FINISH GRADES CHECKED IN THE FIELD ON 8-21-96, 1996 AND ARE CORRECT TO THE BEST OF MY KNOWLEDGE AND BELIEF.
JOEL LUCIA, R. S., M. P. H. Health Commissioner
BY J. Lindsey REGISTERED SURVEYOR REG. NO.

TBM - TSFH - ELEV = 100.00

SEWAGE DISPOSAL PERMIT MUST BE OBTAINED BY A LAKE COUNTY LICENSED INSTALLER BEFORE INSTALLATION IS STARTED.

"I, the undersigned hereby certify that this topography indicated by 6", 1" or 2" contours, and elevations shown hereon represent an actual field survey made by me on the 15th day of March, 1996 and that the elevations were taken at appropriate intervals and that as of that date they existed as indicated hereon."
Tally Jones 6343
Reg. No.

- A. To be brought to finished grade
1. Septic tank manhole covers
2. Splitter box cover
3. Distribution box cover
B. No footer drains or downspouts to be discharged into septic tanks
C. All waste water to be discharged into septic tanks

Reviewed and Accepted
LAKE COUNTY GENERAL HEALTH DISTRICT
Date 8-21-96
JOEL LUCIA, R. S., M. P. H. Health Commissioner
BY J. Lindsey

LOW YIELD WATER FIXTURES REQUIRED ON ALL:
Shower Head
Toilet

RIVERSIDE DRIVE-60'