



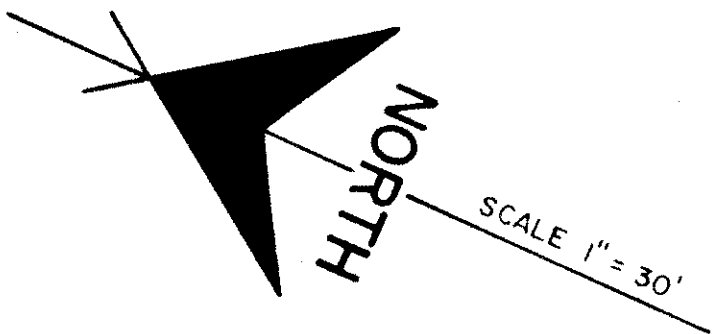

RIVERSIDE DRIVE (S. R. 84) 60'

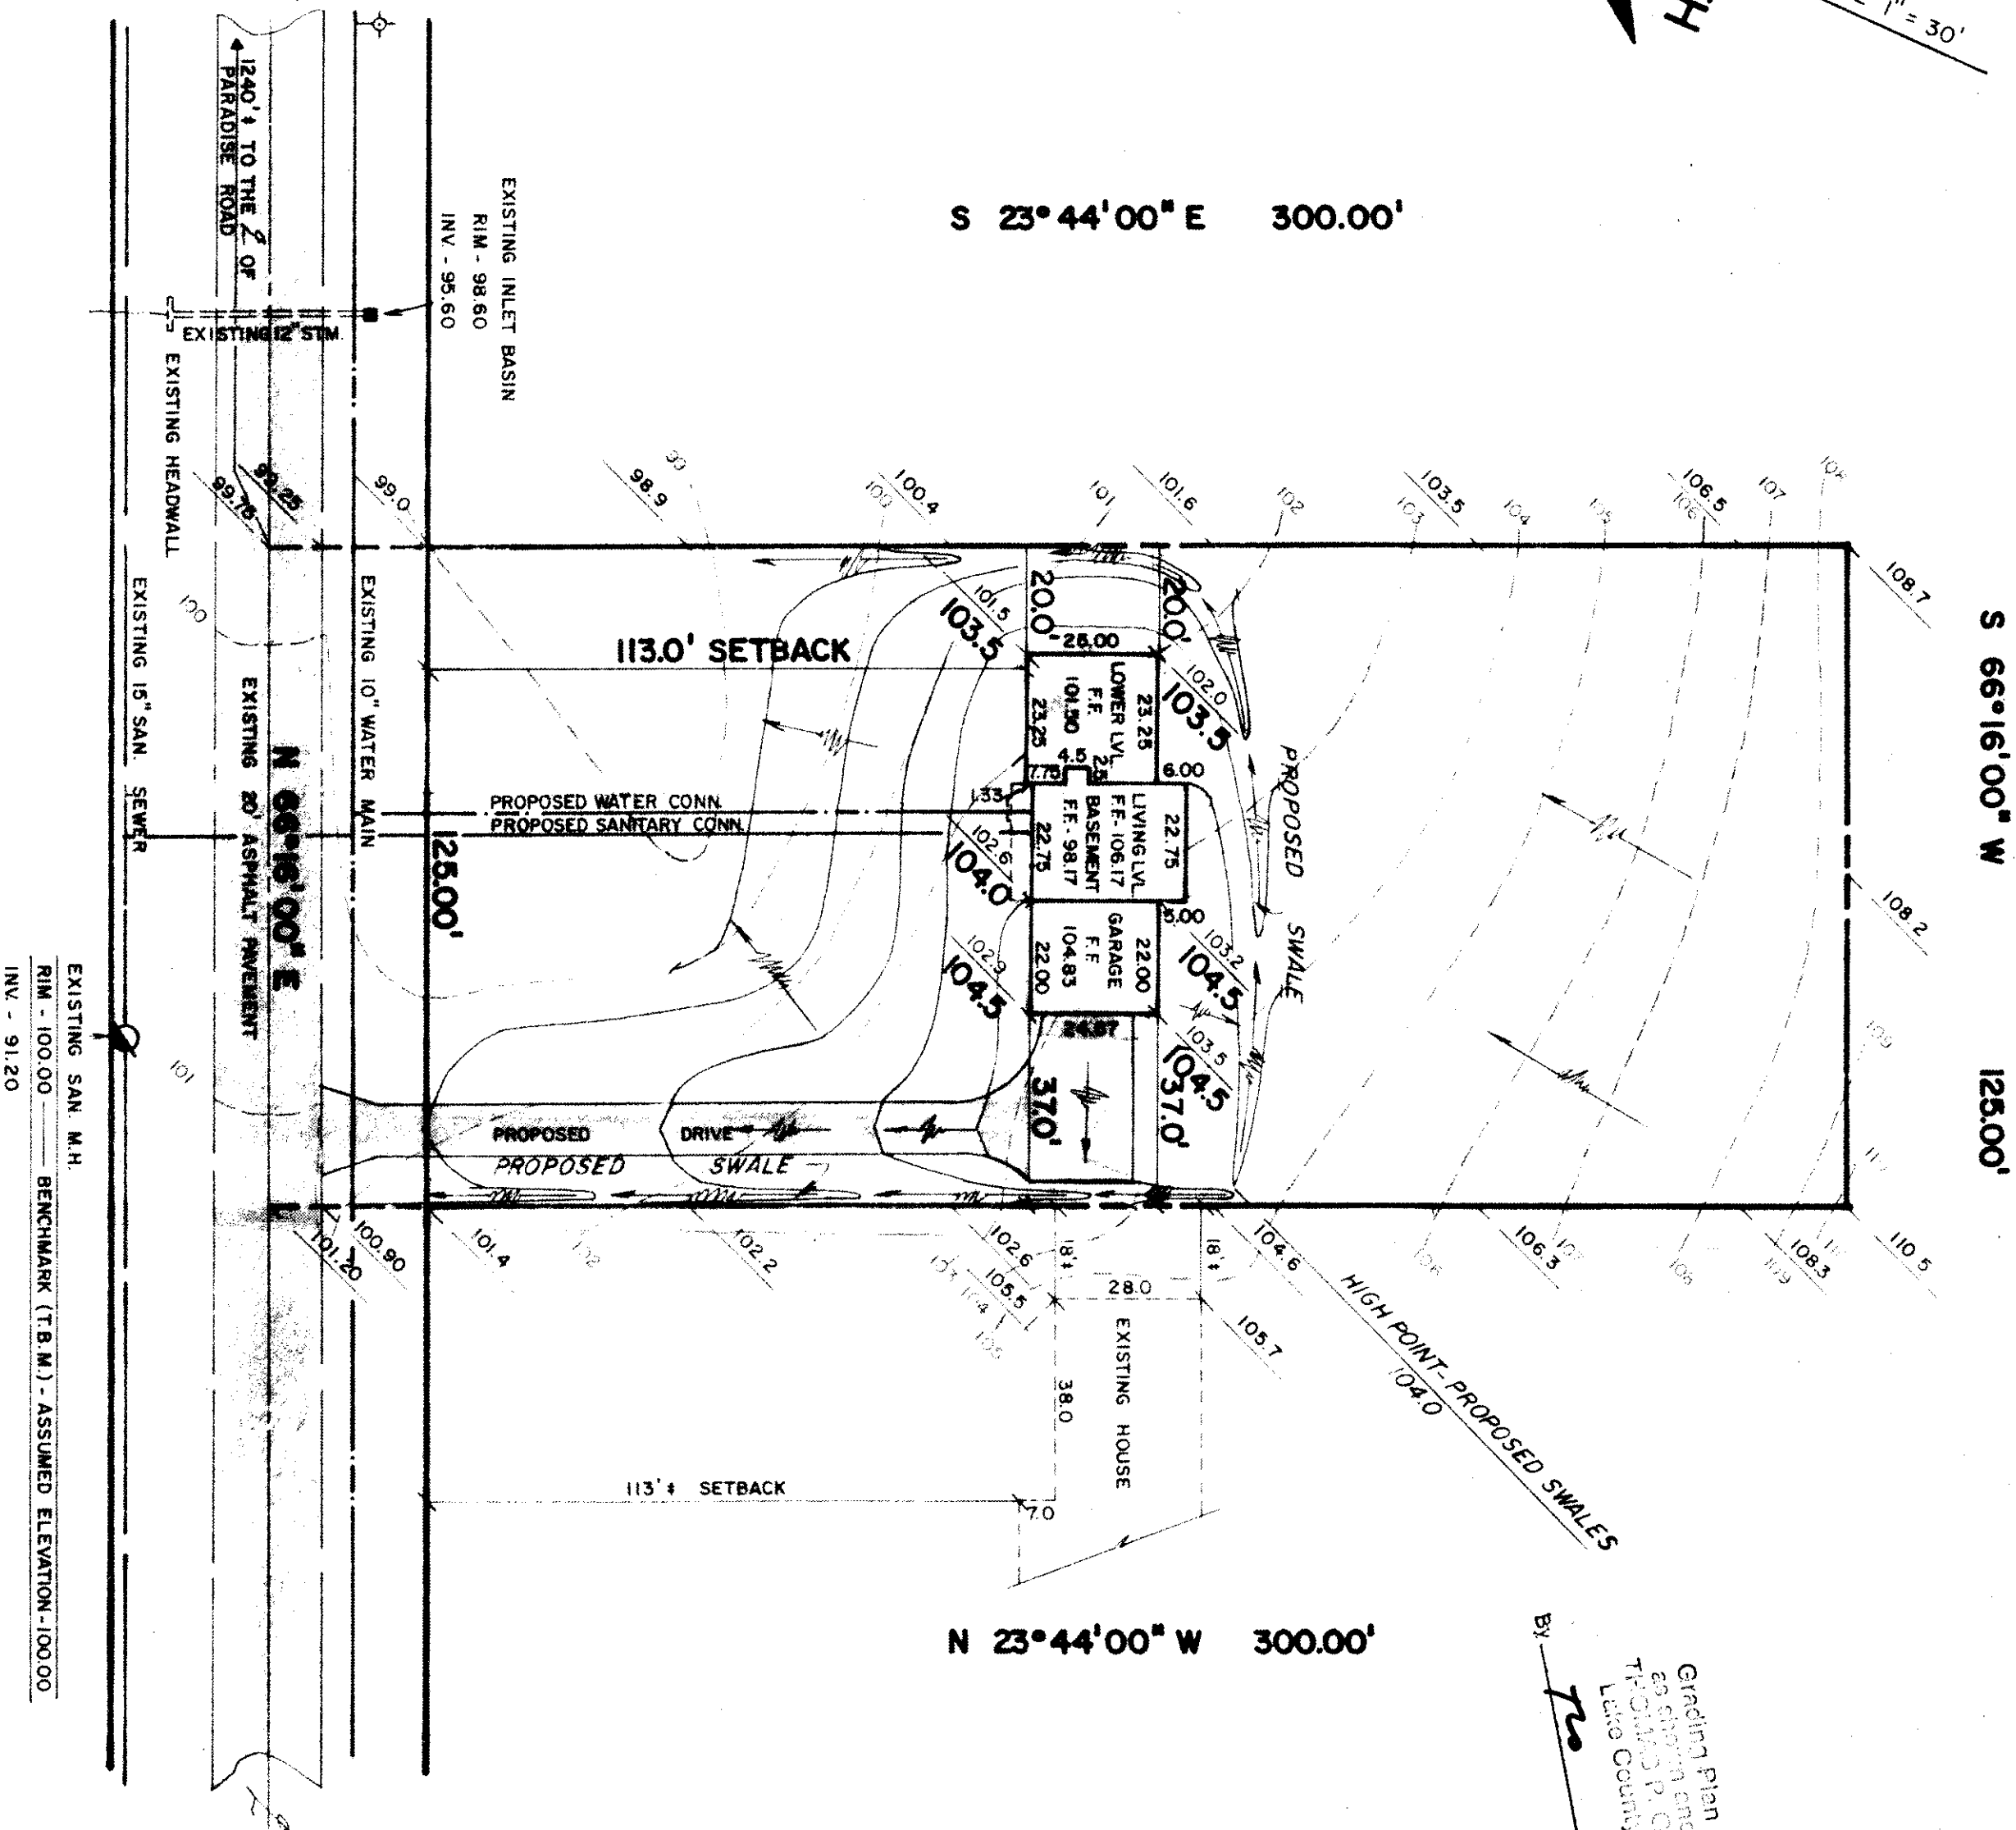

Grading plan Approved
as shown and/or noted
by THOMAS P. GILLES, P.E.
Lake County Engineer
2814
By 72 Date 2814

SITE PLAN

PAINESVILLE, OHIO LAKE COUNTY, OHIO

for: **TED JOHNSON**

912 RIVERSIDE DRIVE, PAINESVILLE 44077

SUBDIVISION NAME LOT TRACT
VOL. - PG. VOLUME PAGE
SUBLOT NO. STREET PERM. PARCEL NO. STREET

LEGEND
SANITARY MANHOLE
STORM MANHOLE
INLET OR CATCH BASIN
HYDRANT
EXISTING CONTOURS
PROPOSED CONTOURS
EXIST. ELEV. 100.0
PROP. ELEV. 100.0
WATER VALVE (GAS)
WATER METER (GAS)
AS BUILT ELEVATION
INDICATES DIRECTION OF SURFACE DRAINAGE

REMARKS
ALL BOUNDARY DATA SHOWN WAS OBTAINED FROM IDEEDS, RECORDED
SUBDIVISION PLAT OR OTHER PUBLIC RECORDS)
LOCATIONS AS SHOWN OF ADJACENT WELLS AND SEPTIC TANKS OBTAINED FROM
LAKE COUNTY HEALTH DEPARTMENT

DESIGN CERTIFICATION
THIS PLAT WAS PREPARED BY ME, AND IS CORRECT
TO THE BEST OF MY KNOWLEDGE AND BELIEF.

CHECK LIST

NO. OF BEDROOMS
DIMENSIONS
BEARINGS
TIE TO NEAREST STREET
SUBLOT NO. PARCEL NO.
SURROUNDING OWNERS
BLOG. DIMENSIONS FIN. GR.
BLOG. TIES FIN. GR.
APPROX. TYPE WIDTH THICKNESS
SIDEWALK TYPE WIDTH THICKNESS
CULVERT TYPE DIA. LENGTH
ROCK OUTCROPPINGS

PLAN PREPARED BY:

NO.	DATE	BY
1	HOUSE LOC.	L.L.
2	3/15/84	L.L.
3	DRAWN BY	SCALE 1" = 30'
4	CHKD.	DATE FEB 3, 1984
5	CREW	APP'D.
6	CHIEF	5937

"AS BUILT" CERTIFICATION

I, HEREBY CERTIFY THAT THE CIRCLED GRADES ARE EXISTING
FINISH GRADES CHECKED IN THE FIELD ON 19
AND ARE CORRECT TO THE BEST OF MY KNOWLEDGE AND BELIEF.

REGISTERED SURVEYOR

REG. NO.

Grading Plan Approved
as shown and/or noted
by THOMAS P. GILLES, P.E.
Lake County Engineer

This Permit Expires

MAY 17 1989
PAINESVILLE TOWNSHIP
ZONING APPROVED

5917

By R.M. Hulse
Zoning Inspector 3/17/84