
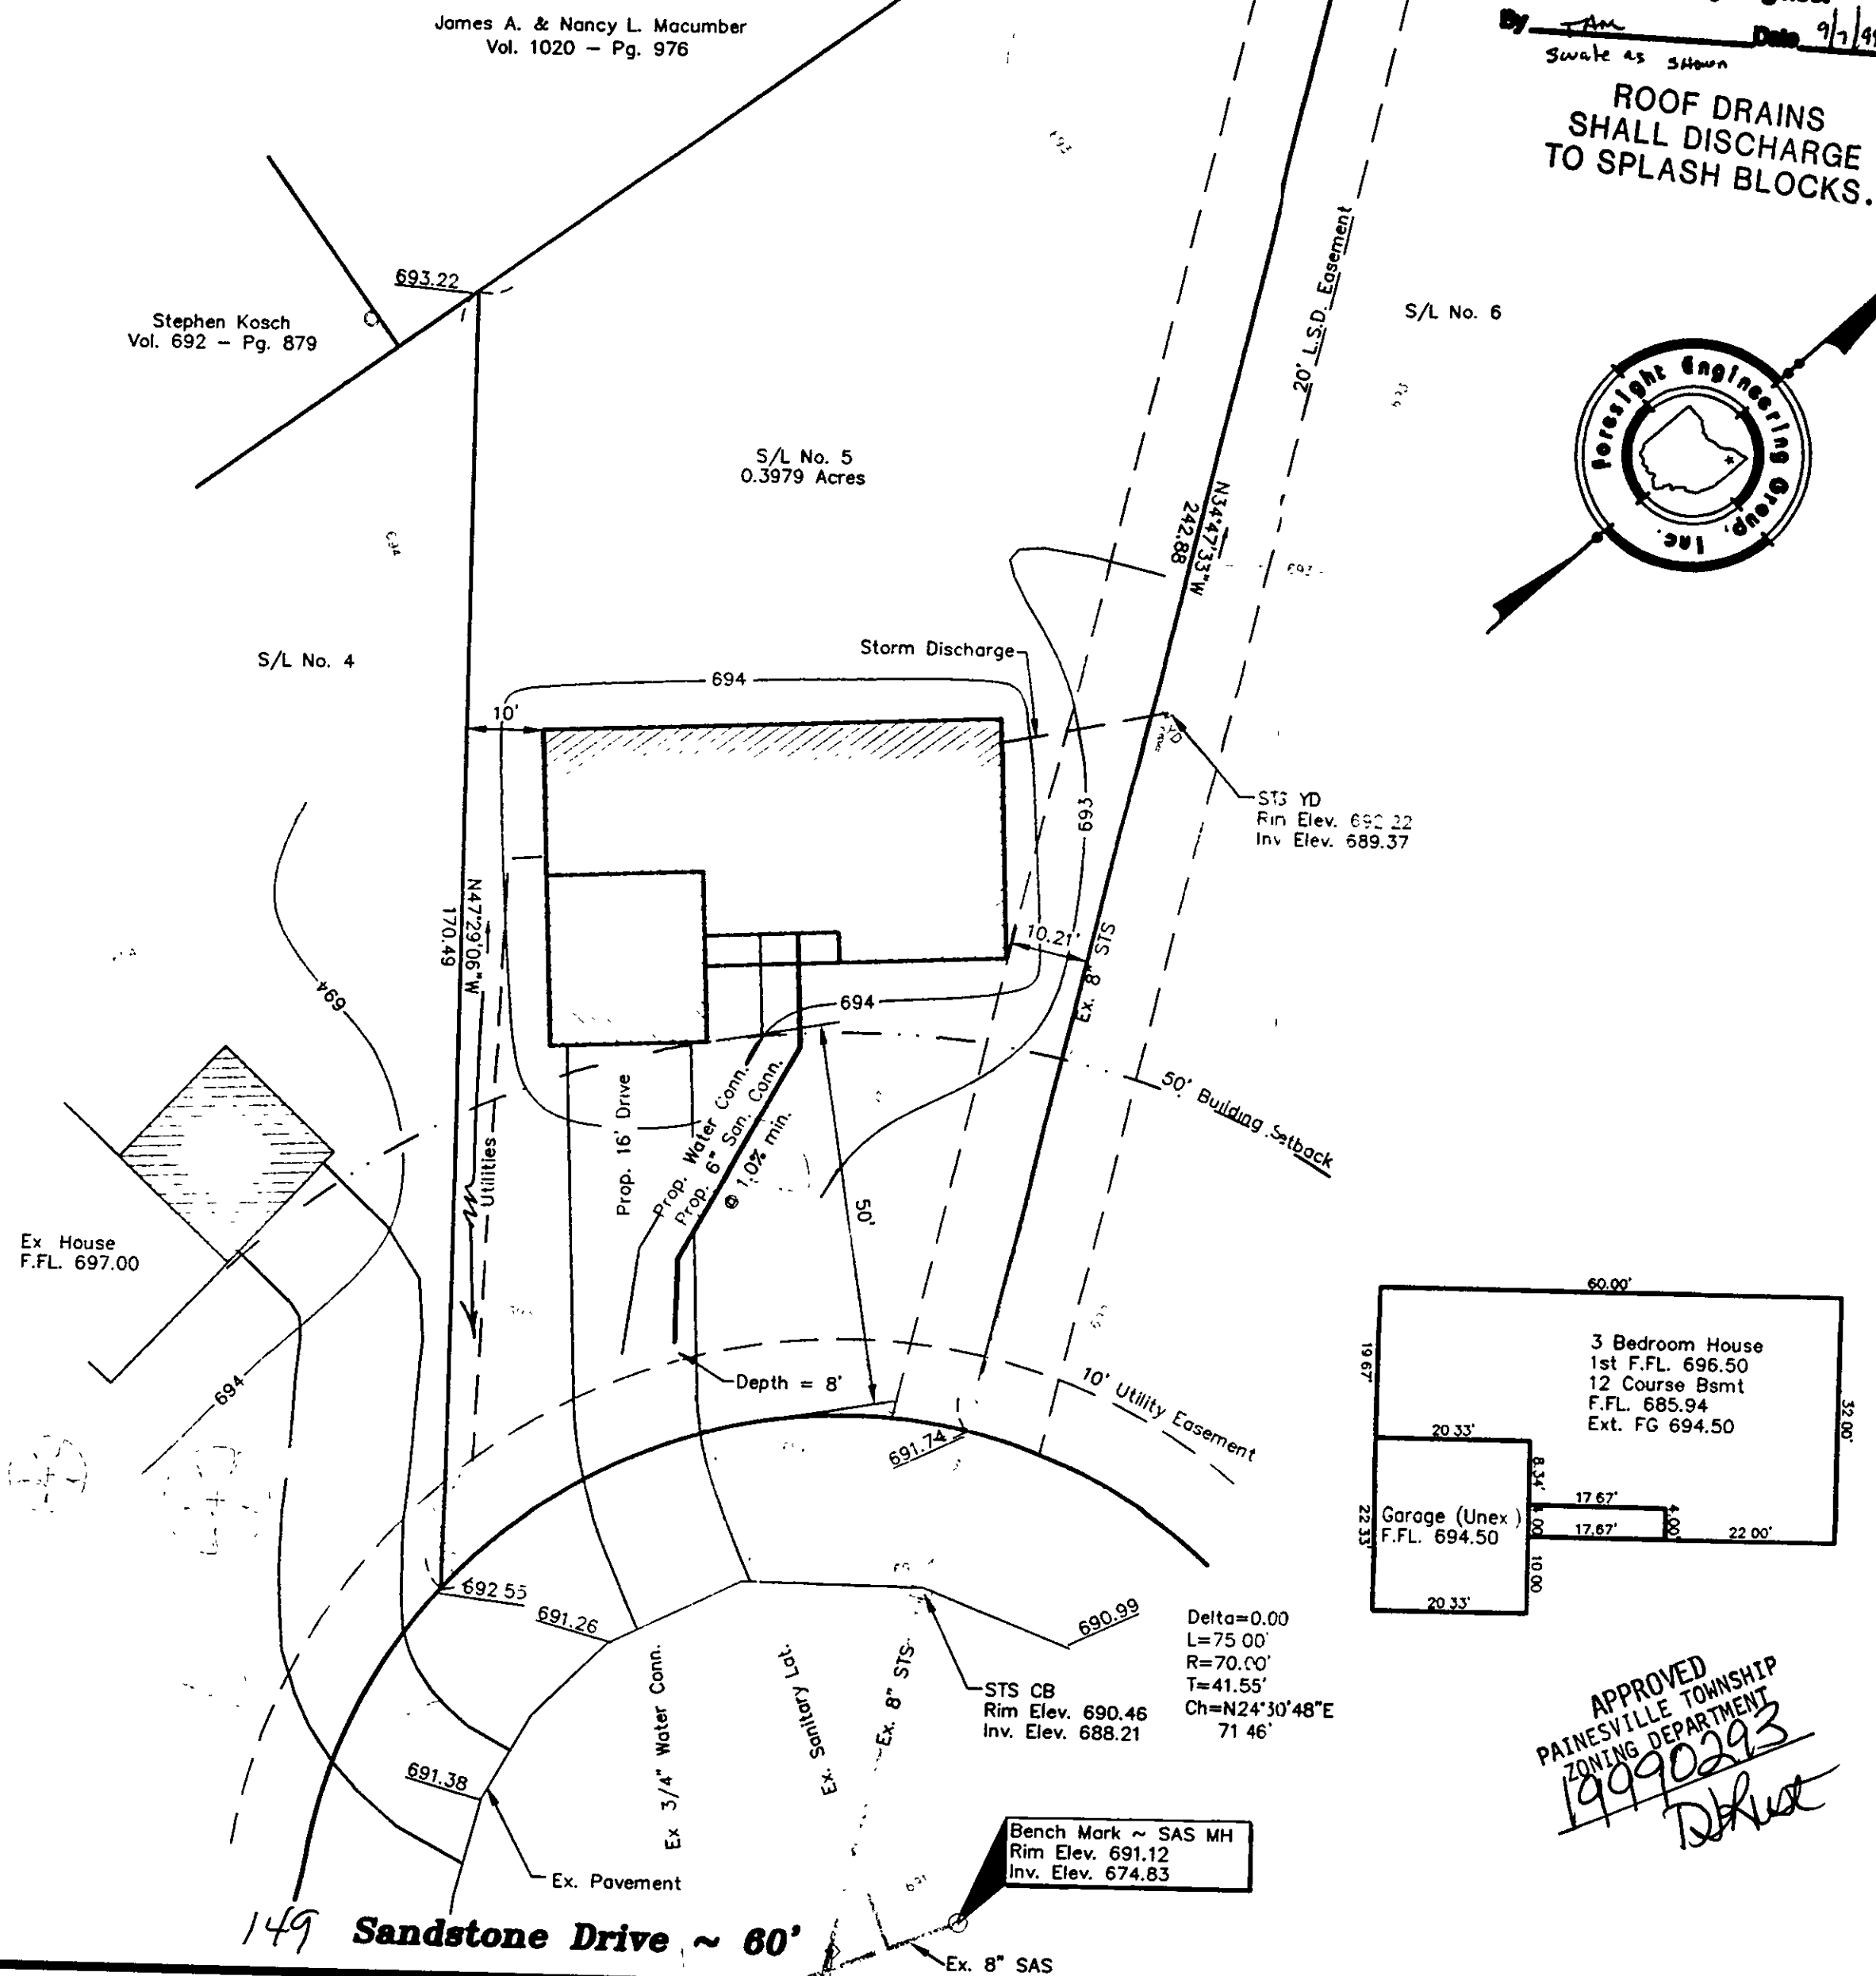


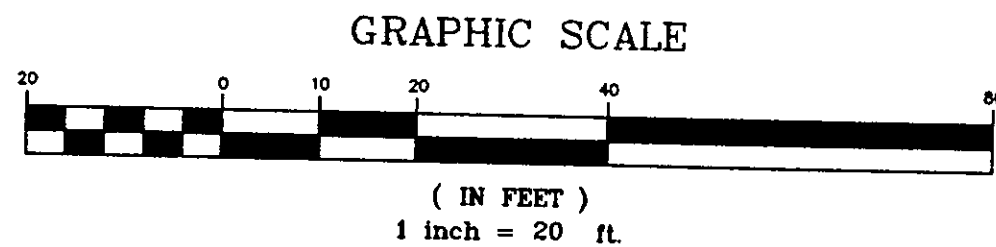

Rosemary Ward
Vol. 813 - Pg 1370

Donald L. and Mary L. Disbro
Vol 446 - Page 493

James A. & Nancy L. Macumber
Vol. 1020 - Pg. 976


Stephen Kosch
Vol. 692 - Pg. 879

Grading Plan Approved
as shown and/or noted
THOMAS P. GILLES, P.E.
Lake County Engineer

By Am Date 9/1/99
Swale as shown

ROOF DRAINS
SHALL DISCHARGE
TO SPLASH BLOCKS.

S/L No. 6

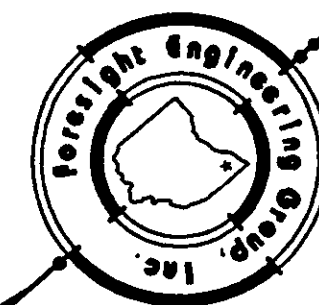

SITE PLAN

for : R.L. Moore
CLIENT
7121 Ravenna Road Concord OH 44077
ADDRESS CITY STATE ZIP

5 Eastern Woodlands Sub.
SUBLOT No. SUBDIVISION NAME VOL. PAGE
Painesville Ohio
LOT TRACT CITY STATE

Foresight Engineering Group

440 286-1010
440 286-1034 fax
320 Center Street, Unit F
Chardon, Ohio 44024

Engineers &
Surveyors


DESIGN CERTIFICATION

This Site Plan was prepared by Foresight Engineering Group, Inc.,
and is correct to the best of my knowledge and belief.

NAME

CHECK LIST

LIT DIMENSIONS & BEARINGS
TIE TO NEAREST STREET
SUBLOT No. (PARCEL No.)
SURROUNDING OWNERS
BUILDING DIMENSIONS
SETBACK, SIDEYARD, REARYARD
FINISH GRADES
DRIVE & APRON TYPE, WIDTH, THICKNESS
SIDEWALK TYPE, WIDTH, THICKNESS
CULVERT TYPE, DIAM., LENGTH
WATER MAIN SIZE, LOCATION
SAN. SEWER SIZE, % GRADE, LOC.
SAN. MH. CAST. ELEV., INV. ELEV.
SAN. CONN. SIZE, % GRADE, LOC.
STORM SEWER SIZE, % GRADE, LOC.
STORM MH. CAST. ELEV., INV. ELEV.
PAVT TYPE, GRADE, CURBS
GAS LINE LOC., SIZE
SEPTIC SYSTEM & DUPLICATION
WELL LOCATION & ISOLATION RADIUS

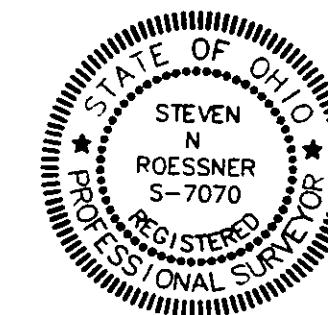

STATE SEAL

"AS BUILT" CERTIFICATION

I hereby certify that the circled information is existing as
obtained on the site 19 and is
correct to the best of my knowledge and belief.

NAME

SCALE : 1" = 20'

FILE NAME
I:\Rim19914\sl5


DATE : August 18, 1999

BENCHMARK:

SAS MH Rim elev =

"I, the undersigned hereby certify that this topographic map, including
contours, and the elevations shown hereon represent an actual survey
by Foresight Engineering Group, Inc. on the 12 day of March
19 99 and that the elevations were taken at appropriate intervals and
that as of that date they existed as indicated hereon."

NAME

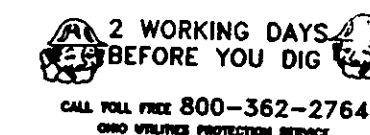

EXISTING UNDERGROUND UTILITIES NOTES:

The location both horizontal and vertical of the underground utilities
shown hereon, have been obtained by a diligent and comprehensive
search of available records. Verification by field observation, has been
conducted where practical. However, Foresight Engineering Group, Inc.
does not guarantee the completeness nor accuracy thereof.