

SITE PLAN

for : R.L. Moore
CLIENT

7121 Ravenna Rd. Concord Oh 44077
ADDRESS CITY STATE ZIP

7 Eastern Woodlands VOL. PAGE
SUBLOT No. SUBDIVISION NAME

Painesville Twp. Ohio
LOT TRACT CITY STATE

Foresight Engineering Group

Engineers & Surveyors

440 286-1010
440 286-1034 fax
320 Center Street, Unit F
Chardon, Ohio 44024

SCALE : 1" = 20'

FILE NAME:
I:\RLM10101\field.dwg

DATE : Jan. 29, 2001

BENCHMARK: BENCHMARK: San MH 691.12

SHEET NO.
1/2

LEGEND

	Man Box
	Yard Dr.
	Manhole
	Hydrant
	Water Valve
	Water Serv.
	Curb Inlet
	Power Pole

Grading Plan Approved
as shown and/or noted
JAMES R. GILLS, P.E.
Lake County Engineer

By TAM Date 2/5/01

ROOF DRAINS
SHALL DISCHARGE
TO SPLASH BLOCKS.



CURVE TABLE

CURVE	Delta	Length	Radius	Tangent	Chord Bearing	Chord Distance
C1	15°09'35"	18.52'	70.00'	9.32'	N55°49'27"W	18.47'
C2	60°00'36"	52.37'	50.00'	28.87'	N78°14'58"W	50.01'
C3	10°10'14"	40.83'	230.00'	20.47'	N76°49'51"E	40.77'

EROSION CONTROL SYMBOLS


- Combination Silt Fence & Straw Bale Barriers
- Filter Fabric Erosion Control
- Silt Fence
- Construction Entrance

GRAPHIC SCALE

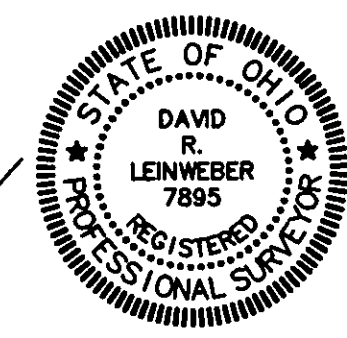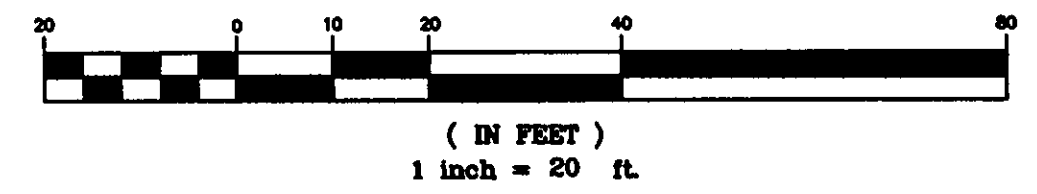

"I, the undersigned hereby certify that this topography, indicated by 6", 1' or 2' contours, and the elevations shown hereon represent an actual field survey made by Foresight Engineering Group, Inc. on the 28 day of Jan. 2001 and that the elevations were taken at appropriate intervals and that as of that date they existed as indicated hereon."

David R. Leinweber 1-20-01
NAME

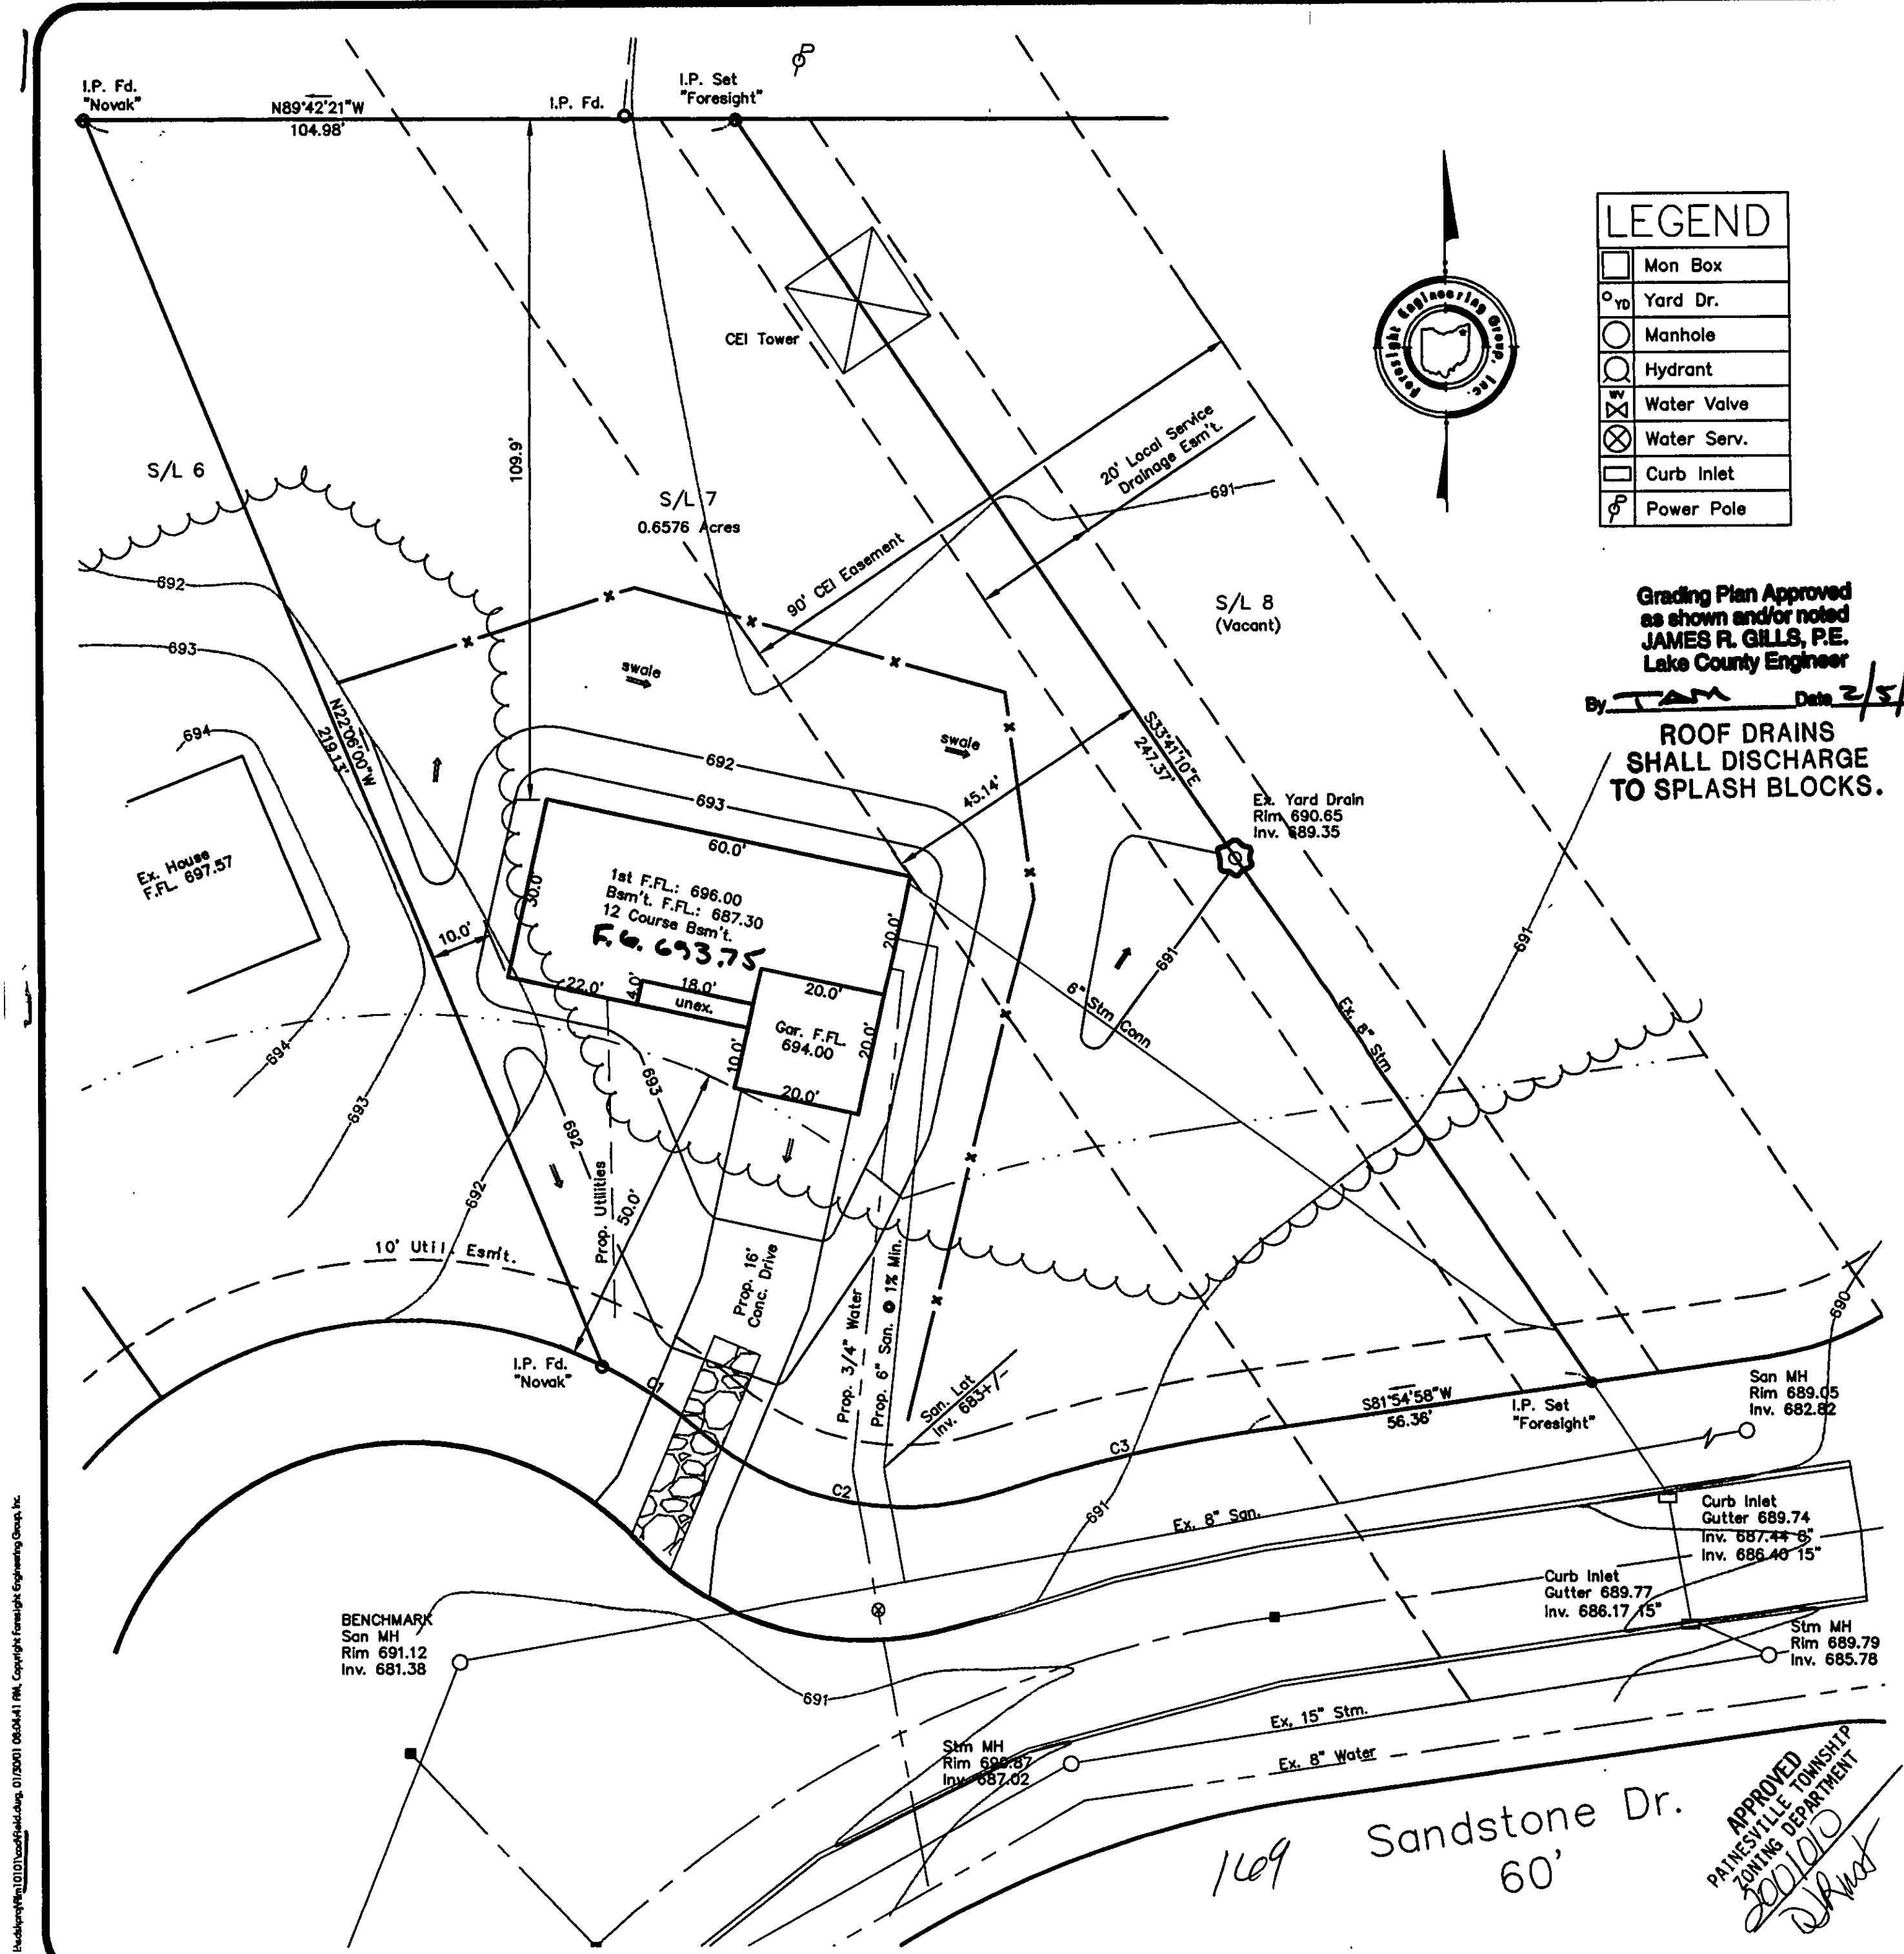

H:\projects\7121 Ravenna Rd.\7121 Ravenna Rd.dwg, 01/29/01 08:04:41 PM, Copyright Foresight Engineering Group, Inc.