


BENCHMARK:
TOP OF HYDRANT EAST SIDE
OF BACON RD. ACROSS FROM
HOUSE #789, ELEV = 643.46

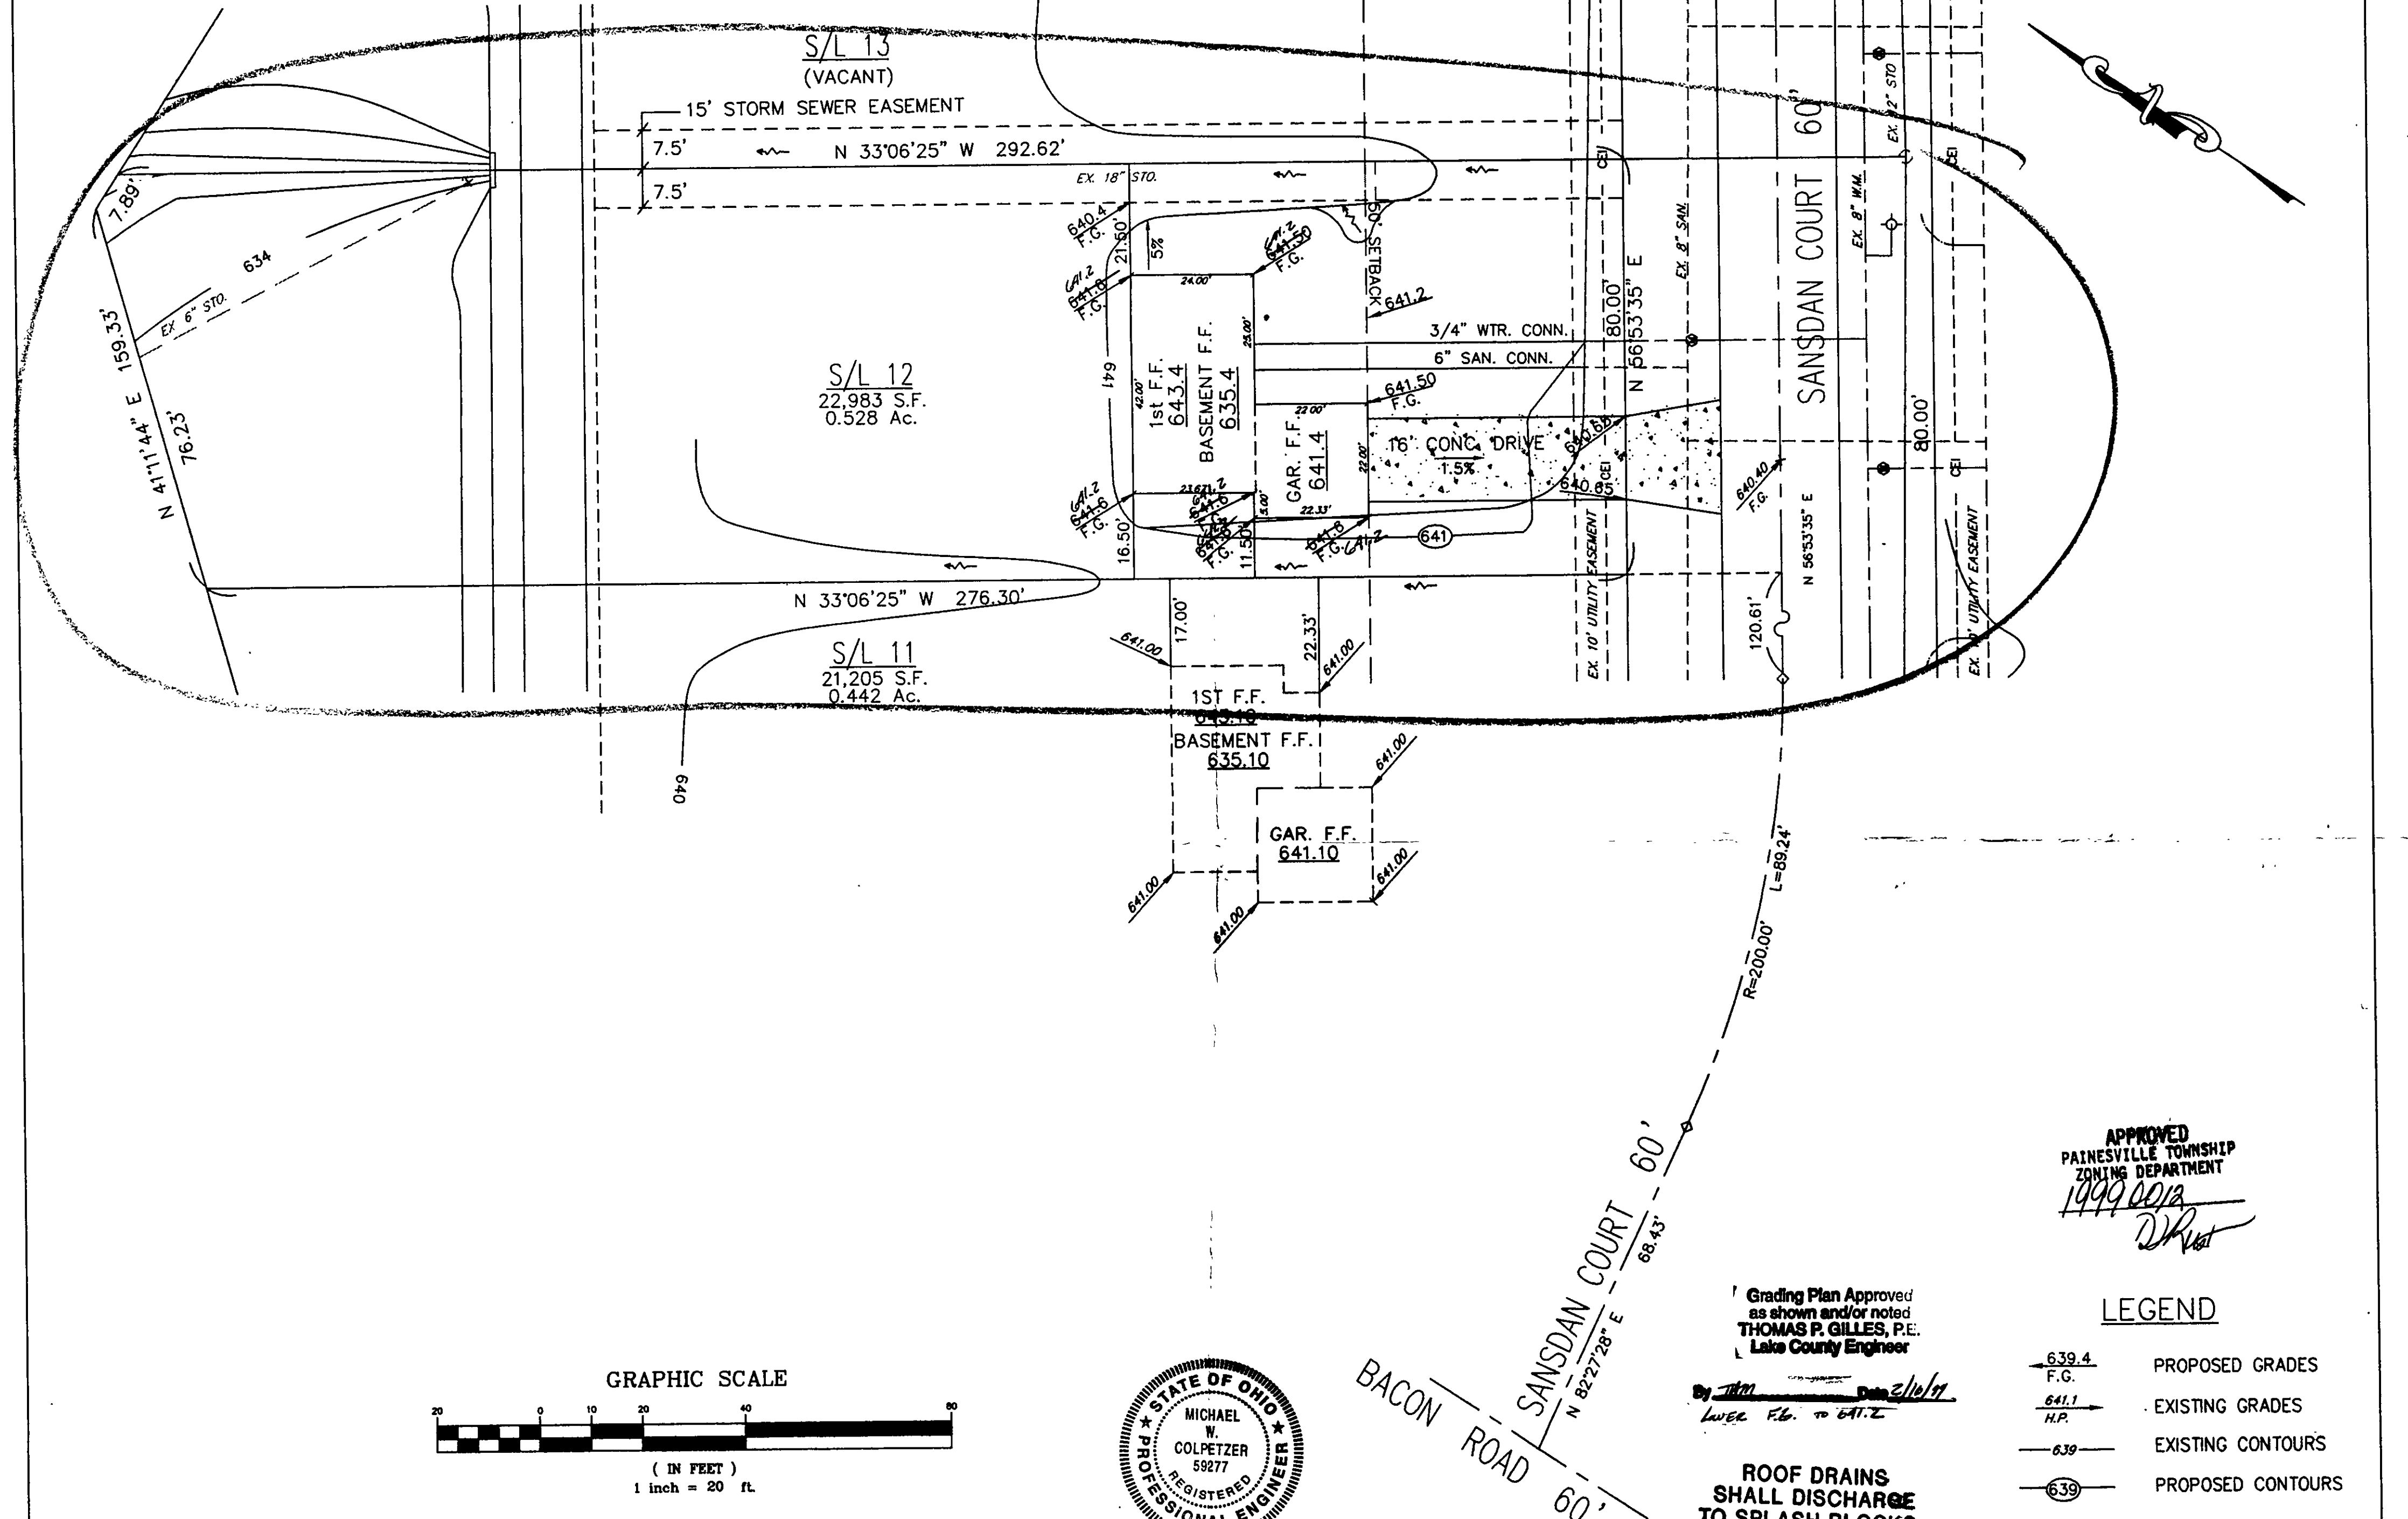

CERTIFICATION
I HEREBY CERTIFY THAT THIS PLAT WAS
PREPARED BY ME AND IS CORRECT TO THE
BEST OF MY KNOWLEDGE AND BELIEF.
BY: *Michael W. Colpetzer*
MICHAEL W. COLPETZER, P.E. NO. 59277

BACON ROAD
SANS DAN COURT 60'
N 82°27'28" E 68.43'
R=200.00' L=89.24'

Grading Plan Approved
as shown and/or noted
THOMAS P. GILLES, P.E.
Lake County Engineer

By *THM* Date *2/10/97*
Lower F.G. to 641.2

ROOF DRAINS
SHALL DISCHARGE
TO SPLASH BLOCKS.

APPROVED
PAINESVILLE TOWNSHIP
ZONING DEPARTMENT
1999 0012
DR

LEGEND

- 639.4 F.G. PROPOSED GRADES
- 641.1 H.P. EXISTING GRADES
- 639 EXISTING CONTOURS
- 639 PROPOSED CONTOURS

SITE PLAN for: EDWARD H. TRESGER, INC. 8100 DEEPWOOD BLVD. MENTOR, OHIO 44060 BEING SUBLOT NO. 12 IN THE PINES SUBDIVISION NO. 4 IN PAINESVILLE TOWNSHIP, OHIO.	
DATE: MAR. 1998 SCALE: 1"=20' DRAWN BY: B.R.S. CHK'D BY: M.W.C. F.B.# PG	CT Consultants, Inc. Engineers • Architects • Planners Willoughby • Mentor • Columbus • North Canton • Youngstown
SHEET 1 OF 1 CONTRACT NO.	