
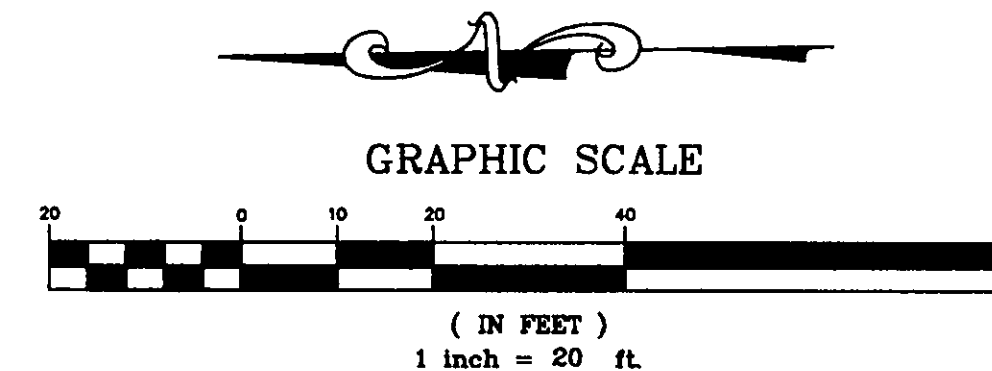


H:\CT\94290\SDSK\SP21.DWG 07-21-98 14:45

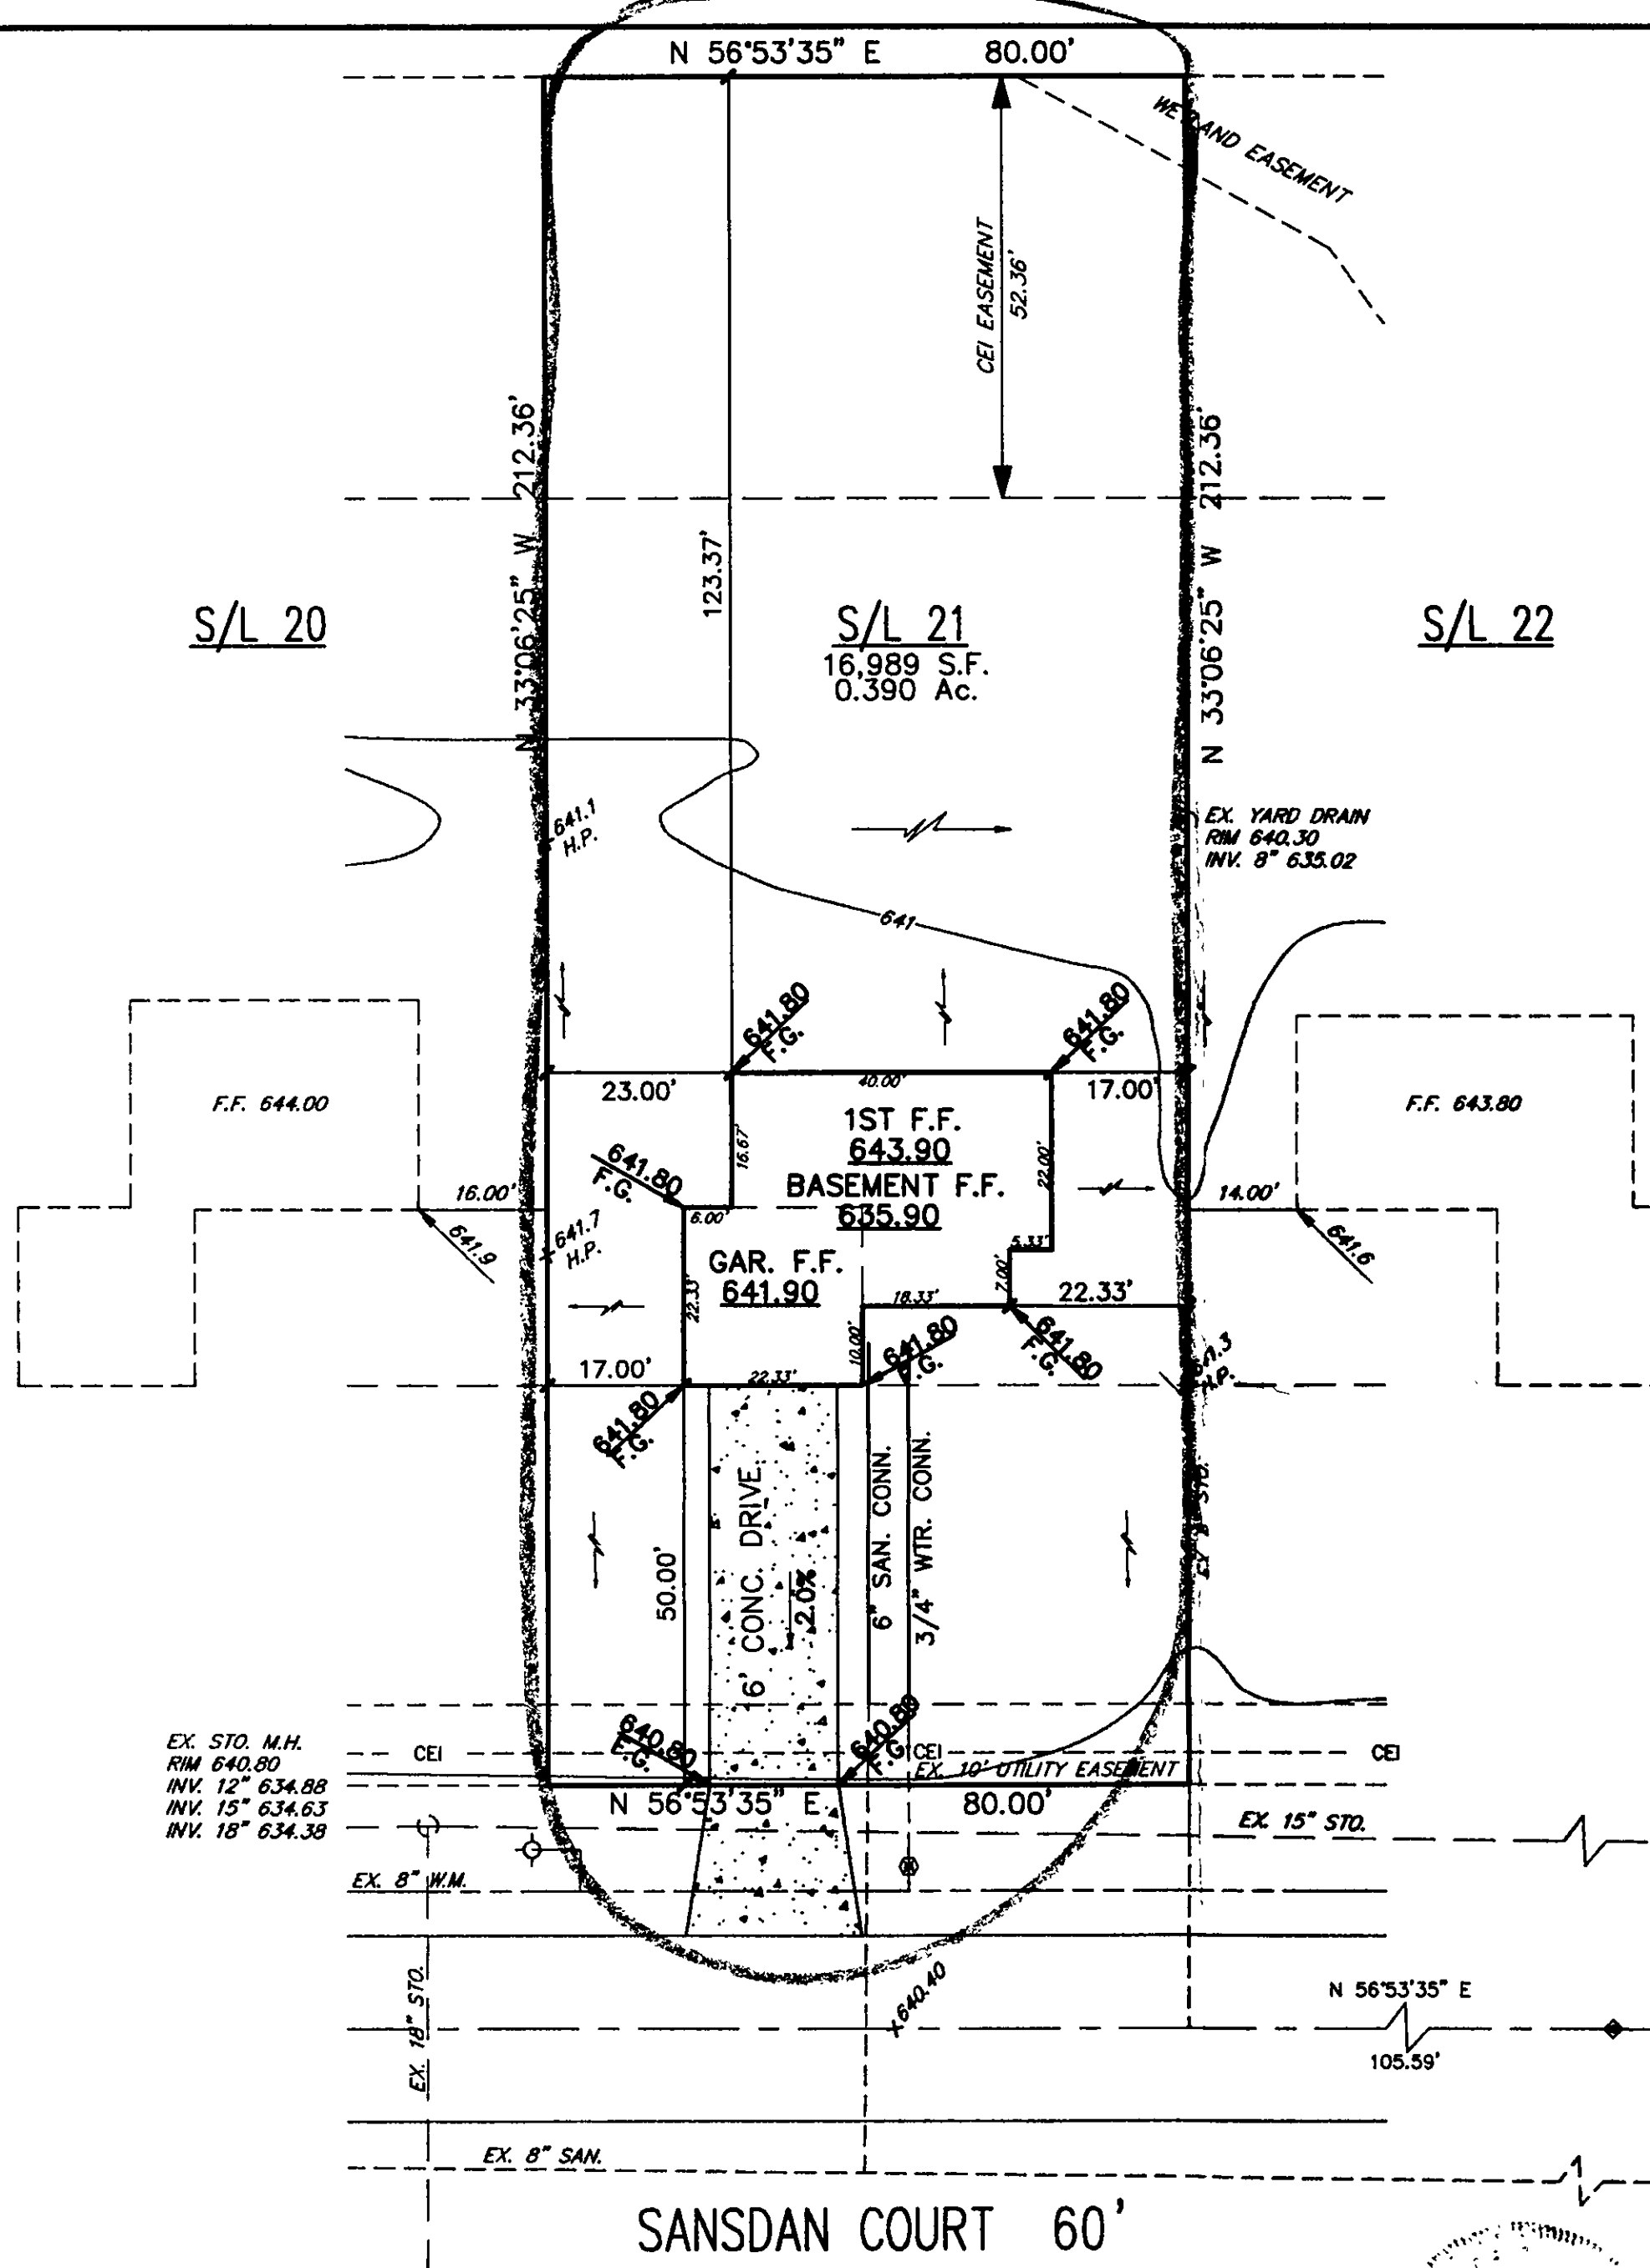

APPROVED
PAINESVILLE TOWNSHIP
ZONING DEPARTMENT
19980228
DR

Grading Plan Approved
as shown and/or noted
THOMAS P. GILLES, P.E.
Lake County Engineer

By GJH Date 8.3.98

CURVE DATA "A"

$\Delta = 25^{\circ}33'53''$
 $R = 200.00'$
 $T = 45.37'$
 $L = 89.24'$
 $C = 88.50'$
 $N 69^{\circ}40'32'' E$

PRINTED

JUL 21 1998

CT CONSULTANTS, INC.

LEGEND

- 639.4 F.G. PROPOSED GRADES
- 640.40 EXISTING GRADES
- 639 EXISTING CONTOURS
- 639 PROPOSED CONTOURS

BENCHMARK:

TOP OF HYDRANT EAST SIDE
OF BACON RD. ACROSS FROM
HOUSE #789, ELEV = 643.46

CERTIFICATION

I HEREBY CERTIFY THAT THIS PLAT WAS
PREPARED BY ME AND IS CORRECT TO THE
BEST OF MY KNOWLEDGE AND BELIEF.

BY: Michael W. Colpetzer
MICHAEL W. COLPETZER, P.E. NO. 59277

SITE PLAN for:

EDWARD H. TRESGER, INC.

8100 DEEPWOOD BLVD. MENTOR, OHIO 44060

BEING SUBLOT NO. 21 IN THE PINES SUBDIVISION NO. 4 IN PAINESVILLE TOWNSHIP, OHIO.

DATE JULY 1998
SCALE 1"=20'
DRAWN BY: B.R.S.
CHK'D BY: M.W.C.
F.B.# PG.

CT Consultants, Inc.
Engineers • Architects • Planners
Willoughby • Mentor • Columbus • North Canton • Youngstown

SHEET 1 OF 1
CONTRACT NO.