


GRAPHIC SCALE

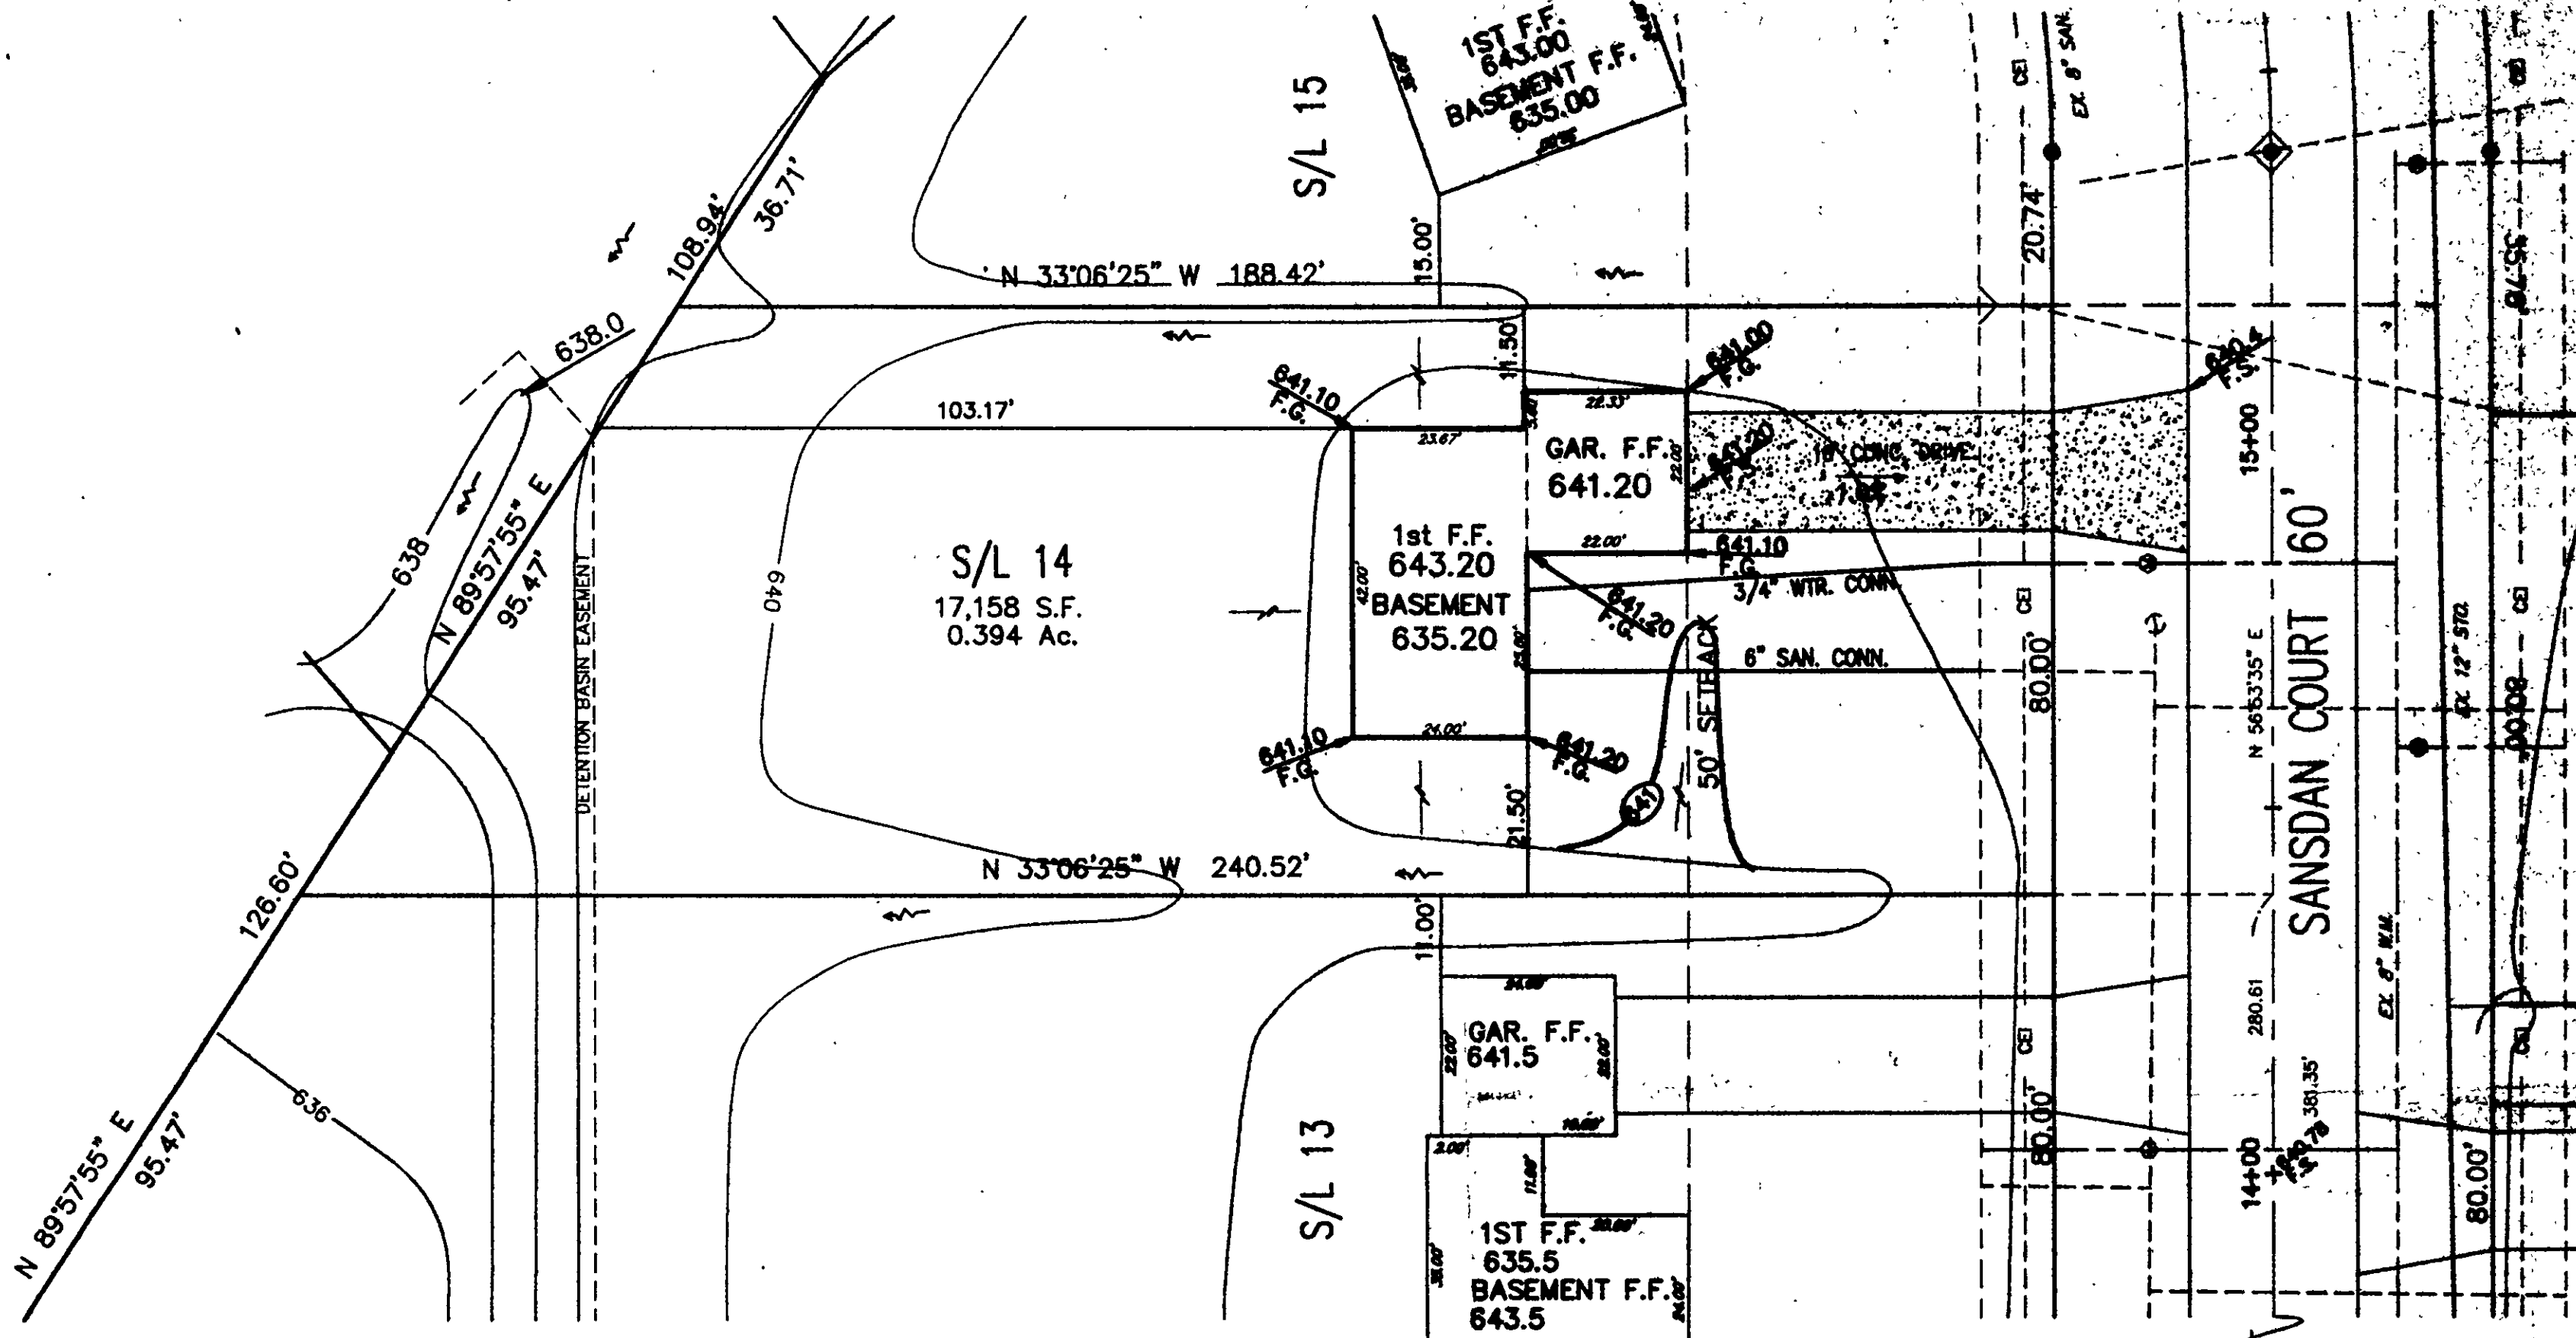

Grading Plan Approved
as shown and/or noted
THOMAS R. GELLES, P.E.
Lake County Engineer

ROOF DRAINS
SHALL DISCHARGE
TO SPLASH BLOCKS
CT CONSULTANTS, INC.

MAR 15 1999

PRINTED

BENCHMARK

TOP OF HYDRANT EAST SIDE
OF BACON RD. ACROSS FROM
HOUSE #789, ELEV = 643.48


LEGEND

- 639.4 F.G. PROPOSED GRADES
- 640.40 F.S. EXISTING GRADES
- 639 EXISTING CONTOURS
- 639 PROPOSED CONTOURS

CERTIFICATION

I HEREBY CERTIFY THAT THIS PLAT WAS
PREPARED BY ME AND IS CORRECT TO THE
BEST OF MY KNOWLEDGE AND BELIEF.

BY: *Michael W. Colpetzer*
MICHAEL W. COLPETZER, P.E. NO. 59277

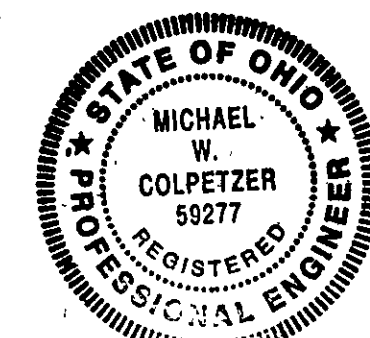

SITE PLAN for: EDWARD H. TRESGER, INC.	
8100 DEEPWOOD BLVD. MENTOR, OHIO 44060	
BEING SUBLT NO. 14 IN THE PINES SUBDIVISION NO. 4 IN PAINESVILLE TOWNSHIP, OHIO	
DATE: _____	SCALE: 1"=20'
DRAWN BY: _____	CHECKED BY: M.W.C.
F.S.#: _____	PO: _____
CT Consultants, Inc. Engineers • Architects • Planners Willoughby • Mentor • Cleveland • North Canton • Painesville	
CONTRACT NO. 1/1	