

SITE PLAN

PAINEVILLE TOWNSHIP COUNTY, OHIO

for: HERITAGE HOMES

CLIENT WILLIAM ST. HURSON OWNER HURSON CITY PAINEVILLE ZIP 44130

THE Paines Sub
SUBDIVISION 1-27 NAME PAINEVILLE
VOL. 1-27 PL. 1-27
SUBLOT NO. 47 STREET PAINEVILLE PERM. PARCEL NO. 1-27 TRACT 1-27
VOLUME 1-27 PAGE 1-27

LEGEND

SANITARY MANHOLE ---○--- WATER VALVE (GAS) ---○---
STORM MANHOLE ---●--- WATER METER (GAS) ---○---
INLET OR CATCH BASIN ---○--- AS BUILT ELEVATION ---○---
HYDRANT ---○--- EXISTING CONTOURS ---○---
PROPOSED CONTOURS ---○--- INDICATES DIRECTION OF SURFACE DRAINAGE
EXIST. ELEV. 100.0 PROP. ELEV. 100.0

REMARKS

ALL BOUNDARY DATA SHOWN WAS OBTAINED FROM (DEEDS, RECORDED SUBDIVISION PLAT OR OTHER PUBLIC RECORDS)
LOCATIONS AS SHOWN OF ADJACENT WELLS AND SEPTIC TANKS OBTAINED FROM LAKE COUNTY HEALTH DEPARTMENT

DESIGN CERTIFICATION

THIS PLAT WAS PREPARED BY ME, AND IS CORRECT TO THE BEST OF MY KNOWLEDGE AND BELIEF

NAME THOMAS P. GILLES, P.E. SURVEYOR REGISTRATION NO. 6343

CHECK LIST

NO. OF BEDROOMS
DIMENSIONS
BEARINGS
TIE TO NEAREST STREET
SUBLOT NO. PARCEL NO.
SURROUNDING OWNERS
BLDG. DIMENSIONS FIN. GR.
BLDG. TIES PL. R. GRADES
ARROW TYPE WIDTH THICKNESS
SEPTIC TANK LOCATION & DIMENSIONS
WELL LOCATION
ISOLATION RADIUS FROM WELL

PLAN PREPARED BY:

BABCOCK • JONES & ASSOCIATES, INC.
PAINEVILLE, OHIO

NO.	DATE	BY	SCALE	DATE	PHONE NO.
1			1" = 20'	7/26/83	357-1811
2					
3					
4					
5					


"AS BUILT" CERTIFICATION

I, HEREBY CERTIFY THAT THE CIRCLED GRADES ARE EXISTING FINISH GRADES CHECKED IN THE FIELD ON 19 AND ARE CORRECT TO THE BEST OF MY KNOWLEDGE AND BELIEF.

REGISTERED SURVEYOR

REG. NO.

SHEFFIELD TERRACE - 60'

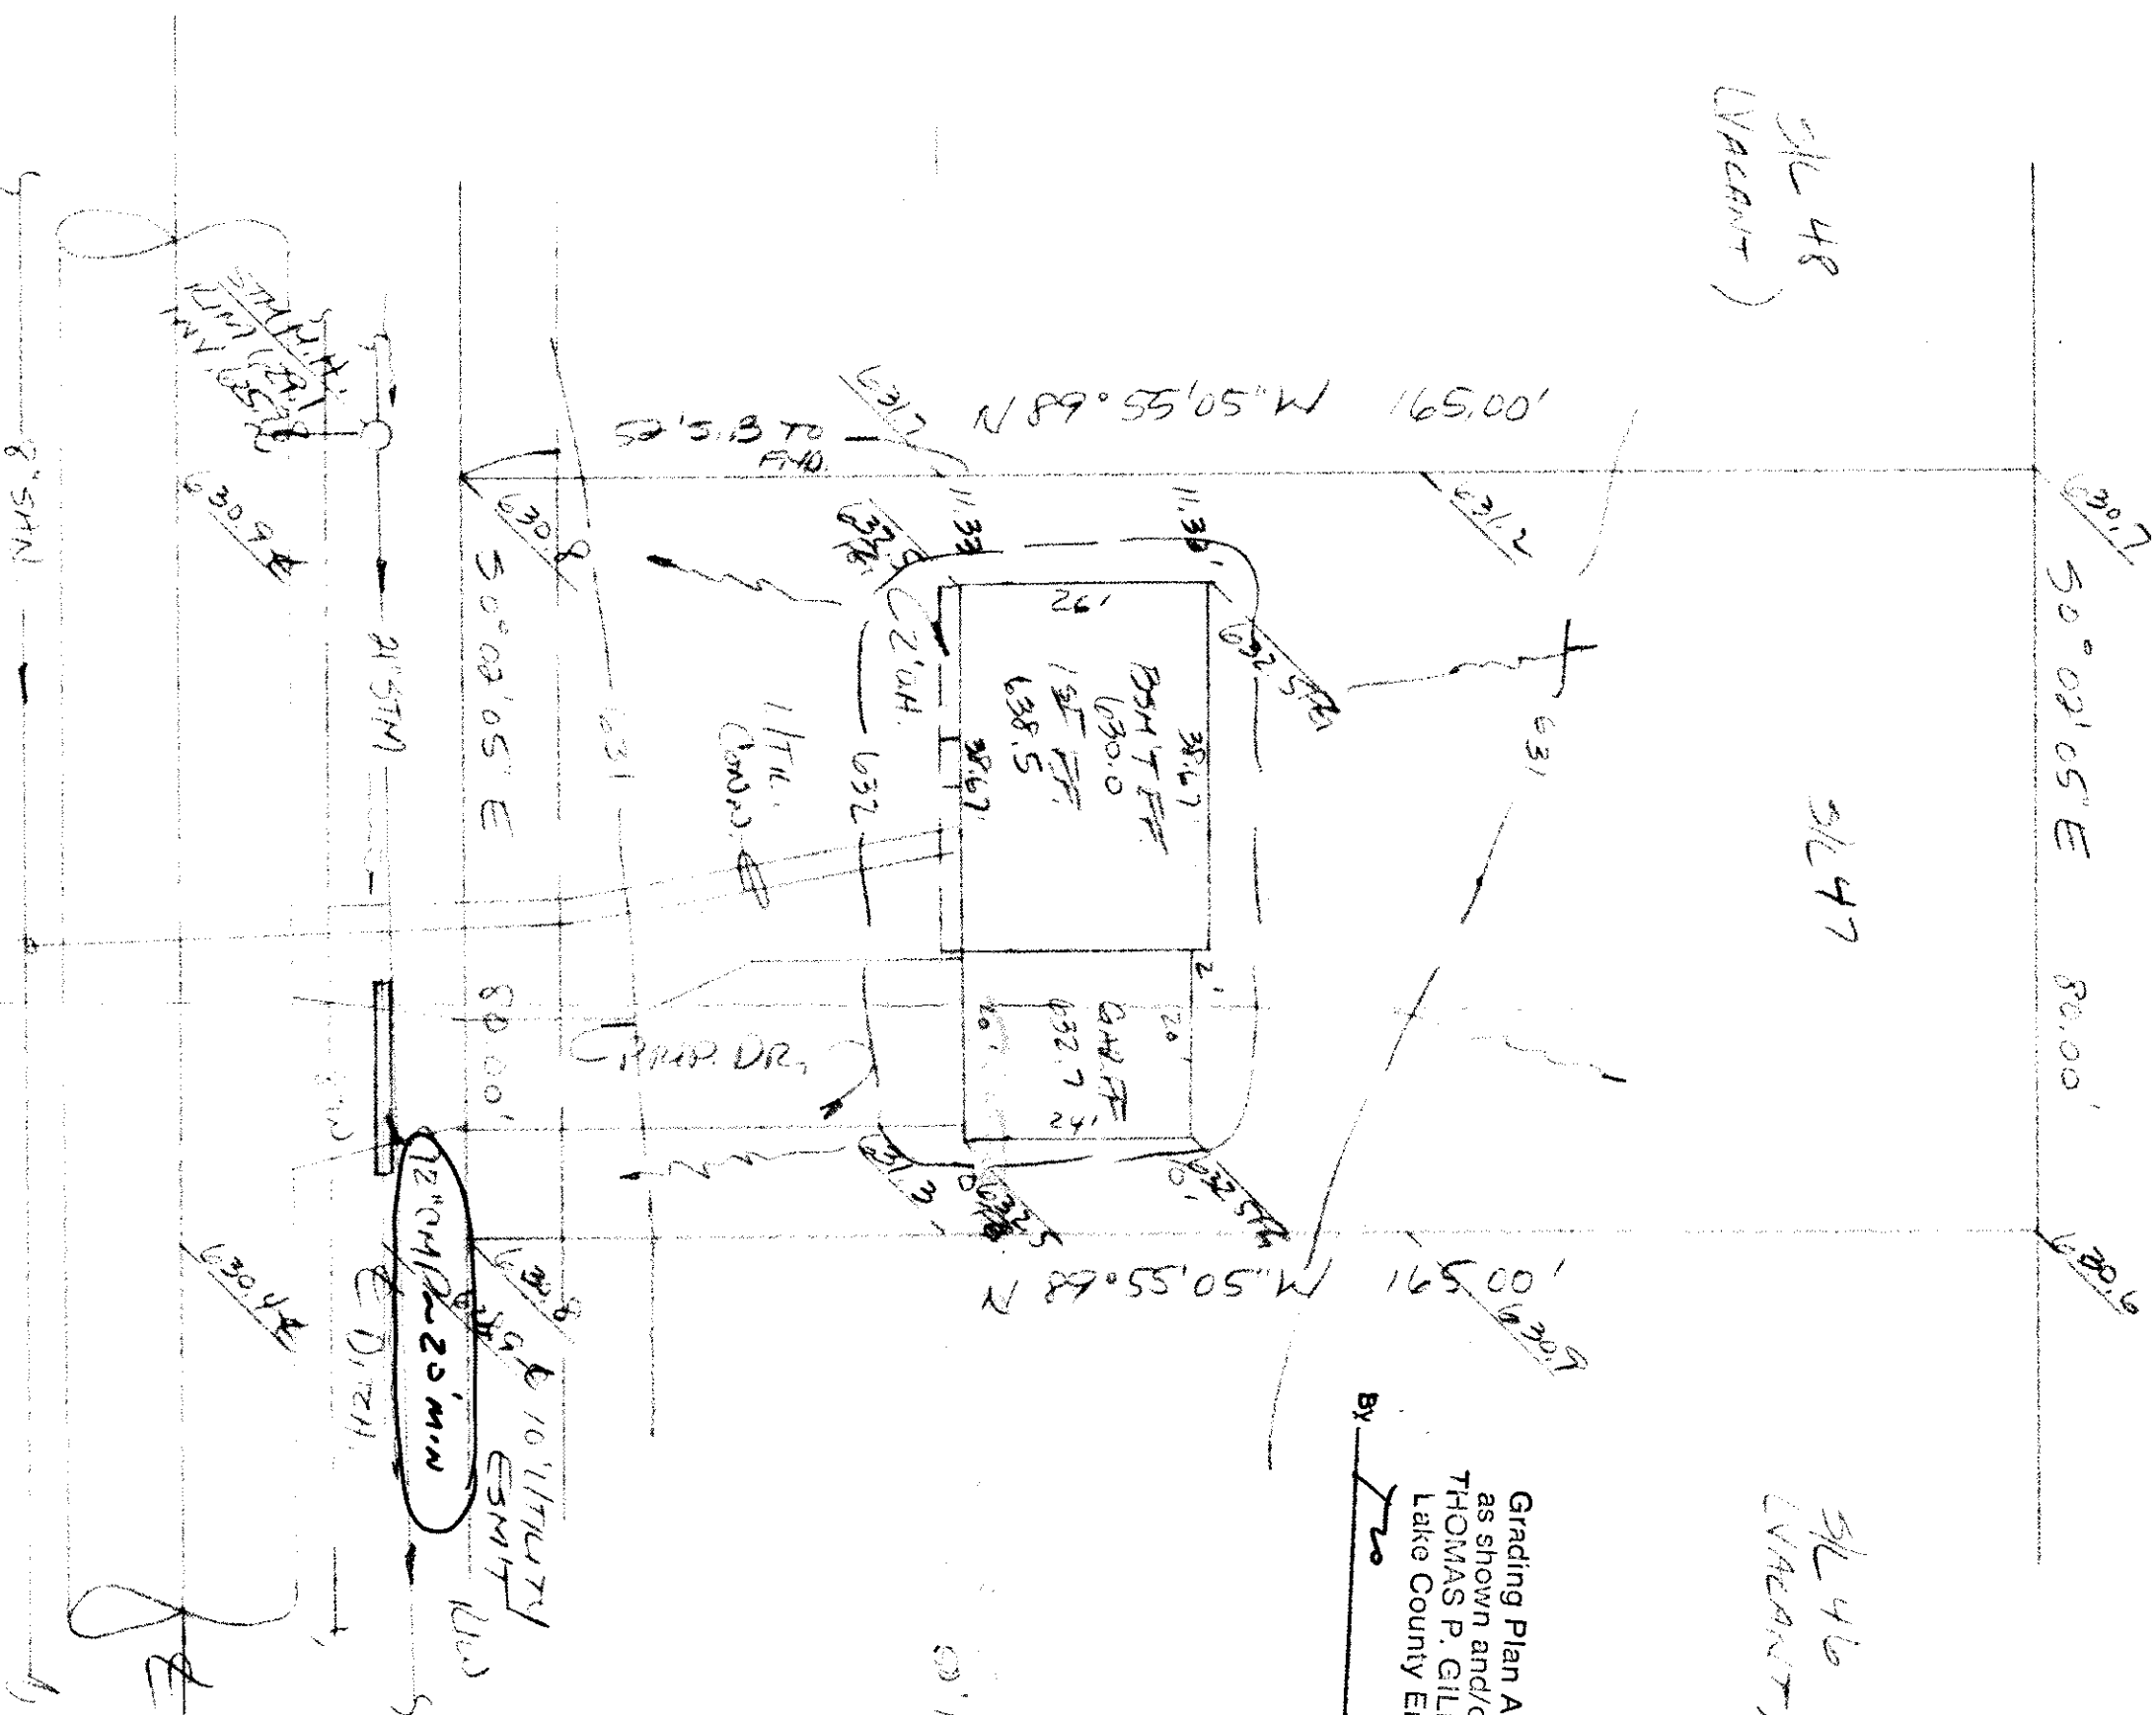

This Permit Expires

AUG 8 1984

PAINEVILLE TOWNSHIP ZONING APPROVED

5789

Zoning Inspector 8/8/83