



EDWARD H. RESER, INC.
 6100 DEERWOOD BLVD., VENTON, OHIO 44020
 BEING SUDOT NO. 102 IN THE PAINES SUBDIVISION
 PHASE III-A IN PAINESVILLE TOWNSHIP, OHIO

DATE: 1/1/89
 SCALE: 1" = 20'
 DRAWN BY: [Signature]
 CHECKED BY: [Signature]
 JOB NO: 88-992
 SHEET NO: 106

CT Consultants, Inc.
 Engineers - Architects - Planners
 Pittsburgh - Newry - Columbus - Toledo - North Canton - Steubenville

AS BUILT CERTIFICATION
 I HEREBY CERTIFY THAT THE CIRCLED GRADES
 ARE EXISTING FINISH GRADES CHECKED IN THE
 FIELD ON SURVEY IS CORRECT TO THE BEST OF MY
 KNOWLEDGE AND BELIEF

DESIGN CERTIFICATION
 THIS PLAN WAS PREPARED BY ME
 AND IS CORRECT TO THE BEST OF
 MY KNOWLEDGE AND BELIEF

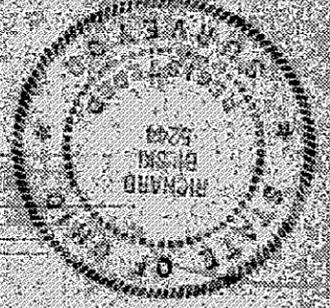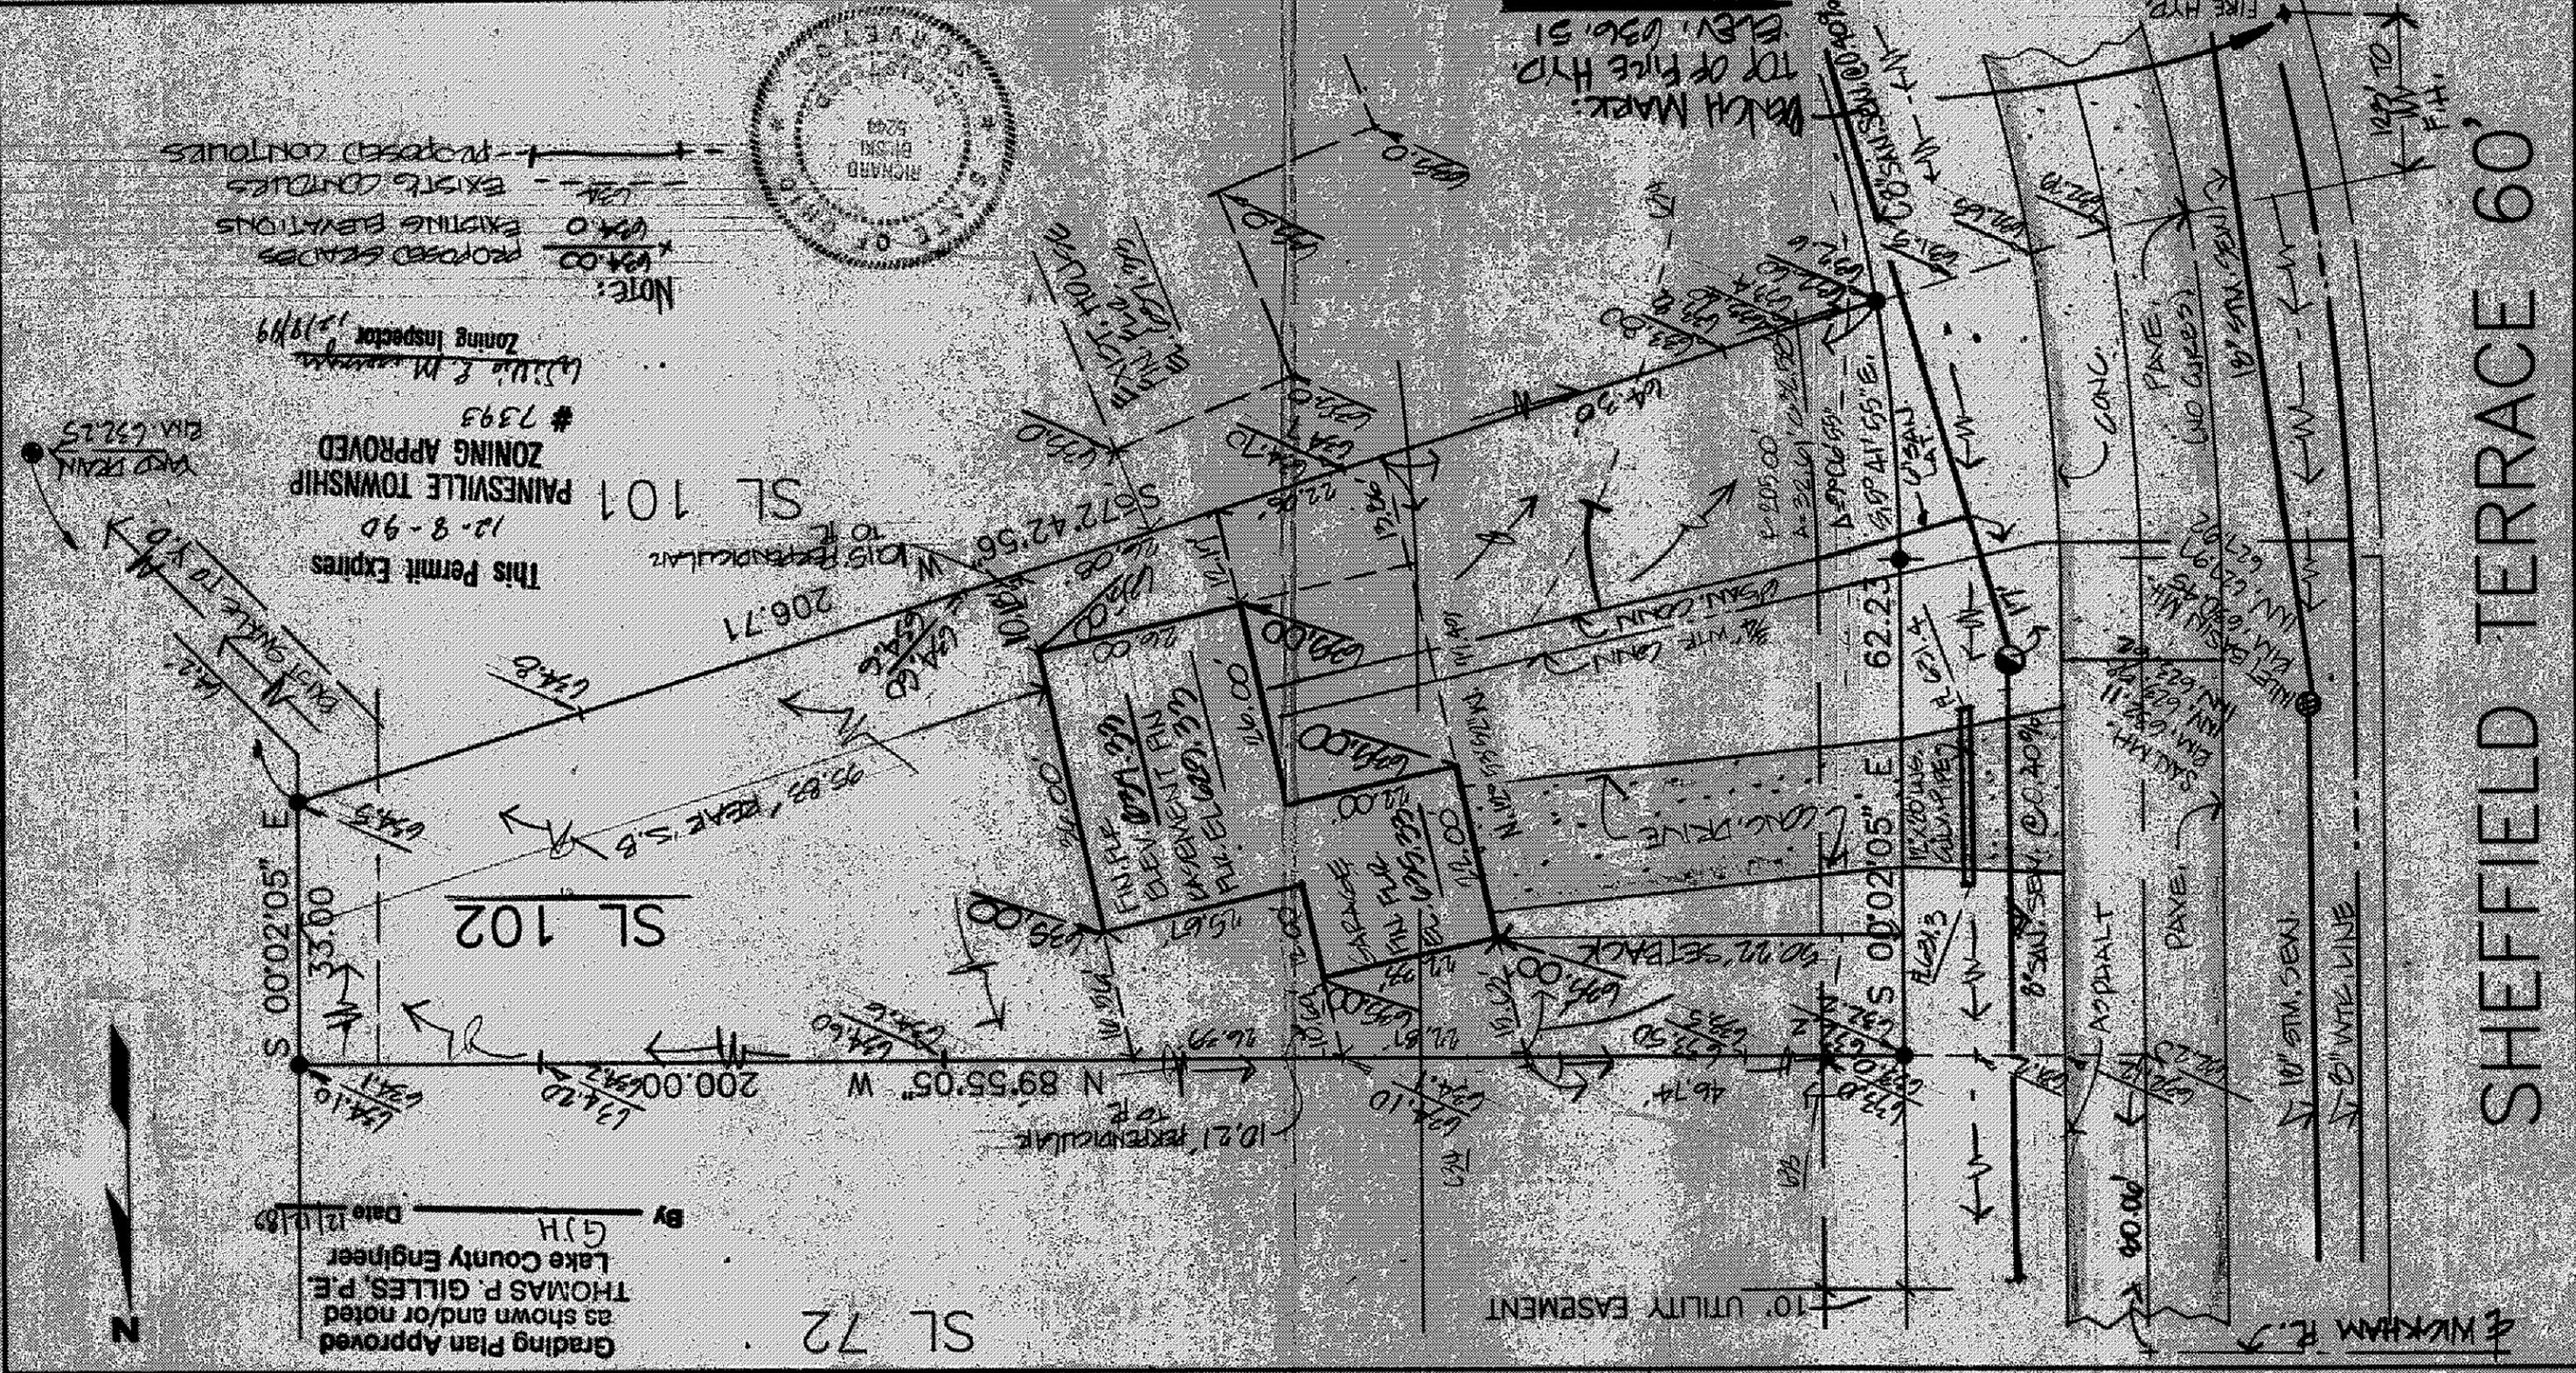

NOTE:
 1. PROPOSED SEASLES
 2. EXISTING ELEVATIONS
 3. EXISTING CONTOURS
 4. PROPOSED CONTOURS

This Permit Expires 12-8-90
 PAINESVILLE TOWNSHIP ZONING APPROVED # 7393
 Zoning Inspector 12/19/89

Grading Plan Approved as shown and/or noted
 THOMAS P. GILLES, P.E.
 Lake County Engineer
 G.J.H.
 Date 12/18/89

SHEFFIELD TERRACE 60'

5249

[Signature]