
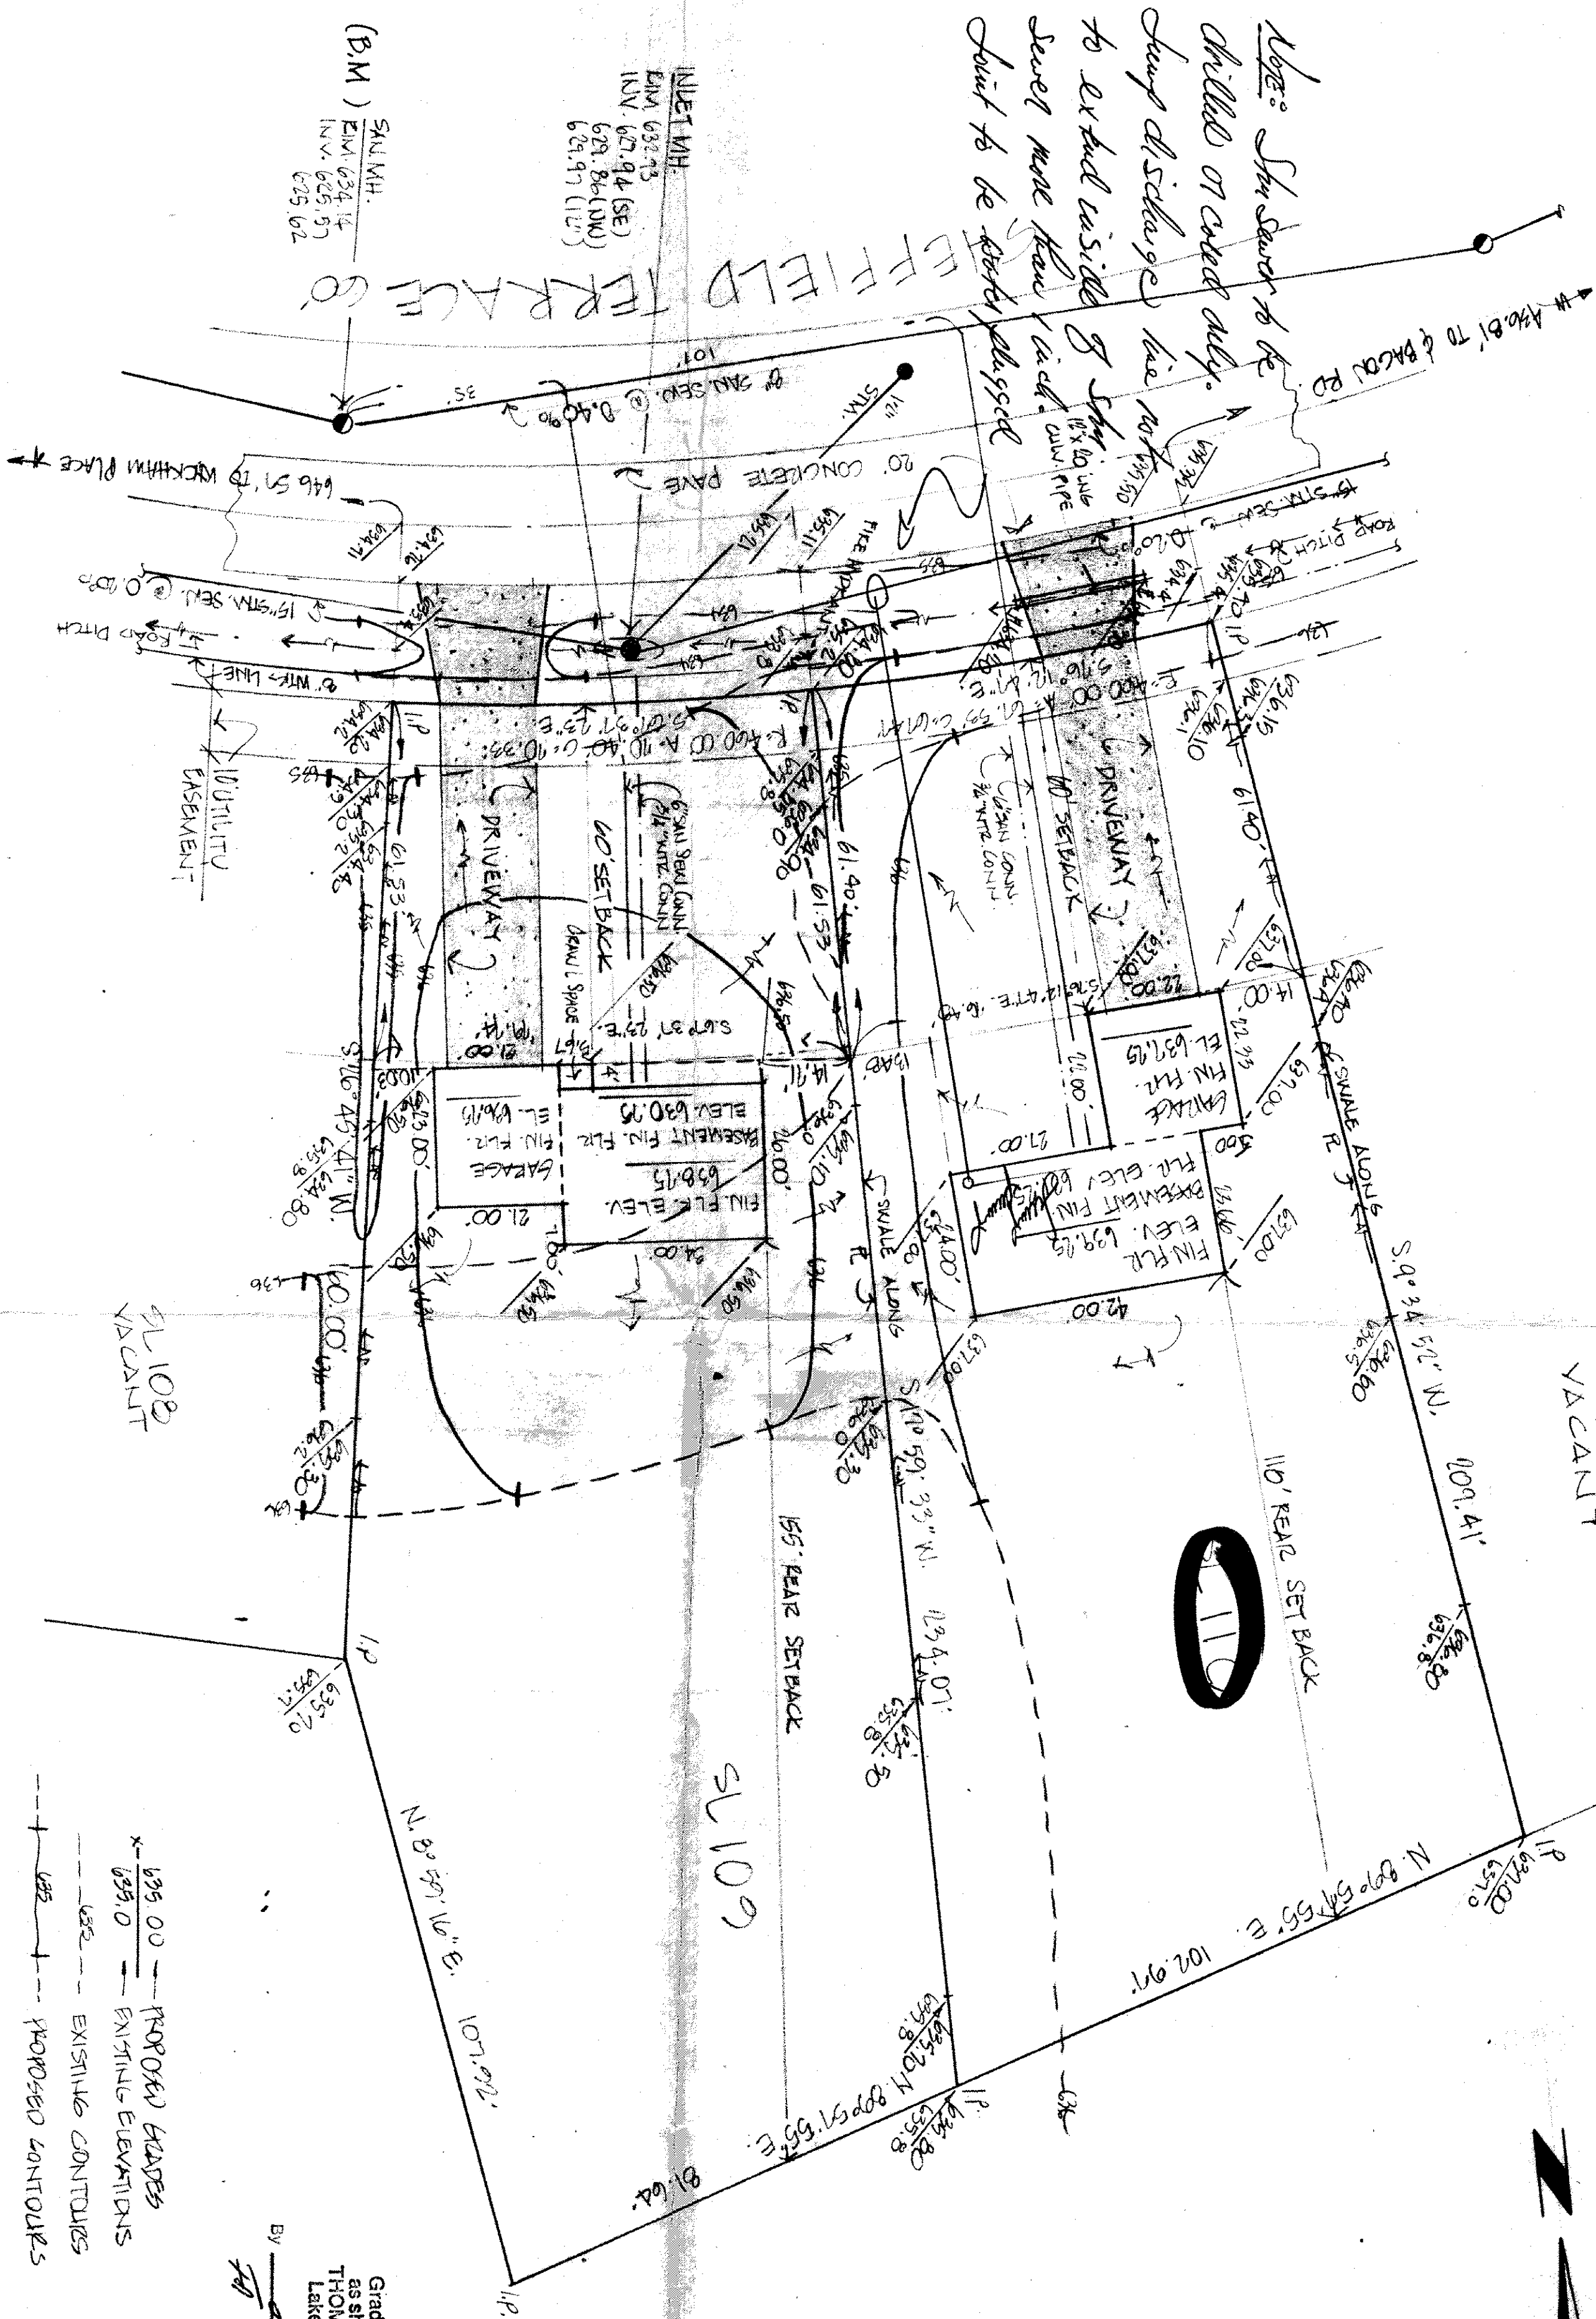


SL111
VACANT

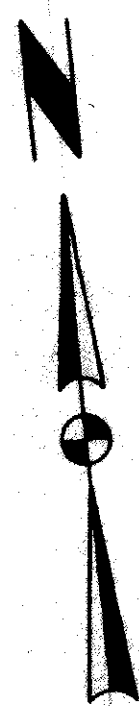

FRONT WALK: TOP OF SANI.
MANHOLE IN FRONT OF
SUBLOT NO. 109 ELEV. 634.14

CERTIFICATION:

I HEREBY CERTIFY THAT THIS
PLAN WAS PREPARED BY ME
AND IS CORRECT TO THE BEST OF MY
KNOWLEDGE AND BELIEF.

BY:

Edward H. Tresker, Inc.
P.O. Box 109, Painesville, Ohio 44060



SITE PLAN FOR: EDWARD H. TRESKER, INC.
8100 DEERWOOD BOULEVARD, MENTOR, OH 44060
PAINESVILLE TOWNSHIP, CUYAHOGA COUNTY, OHIO

--- PROPOSED GRADES
--- EXISTING ELEVATIONS
--- EXISTING CONTOURS
--- PROPOSED CONTOURS

This Permit Expires
3-21-90
PAINESVILLE TOWNSHIP
ZONING APPROVED
2178
Zoning Inspector 3/21/89

Grading Plan Approved
as shown and/or noted
THOMAS P. GILLES, P.E.
Lake County Engineer
Date 3-23-89
By T.P. Gilles

DATE 3/21/89
SCALE 1"=20'
DRAWN BY LK
CHECKED BY JLB
P.E. 00112

CT Consultants, Inc.
Engineers • Architects • Planners
Painesville • Mentor • Columbus • Lorain • North Canton • Steubenville

SHEET 1 OF 1
PROJECT NO. 89-5012