



DESIGN CERTIFICATION
 THIS PLAN WAS PREPARED BY ME
 AND IS CORRECT TO THE BEST OF
 MY KNOWLEDGE AND BELIEF.
 5244
 REG. SURVEYOR NO.

AS BUILT CERTIFICATION
 I HEREBY CERTIFY THAT THE CIRCLED GRADES
 ARE EXISTING FINISH GRADES CHECKED IN THE
 FIELD ON
 SURVEY IS CORRECT TO THE BEST OF MY
 KNOWLEDGE AND BELIEF.
 REG. SURVEYOR NO.

CT Consultants, Inc.
 Engineers • Architects • Planners
 Willoughby • Mentor • Columbus • Lorain • North Canton • Stouenville

DATE: MAY 3, 1989
 SCALE: 1" = 40'
 DRAWN BY: LB
 CHECKED BY: LB
 JOB NO: 88-592
 FB 682 PG 108

SITE PLAN FOR:
EDWARD H. RESSEK, INC.
 8100 REARWOOD BLVD., MENTOR, OHIO
 BEING SUBLOT NO. III IN THE PILES SUBDIVISION
 PHASE IIIA IN PAINESVILLE TOWNSHIP, OHIO

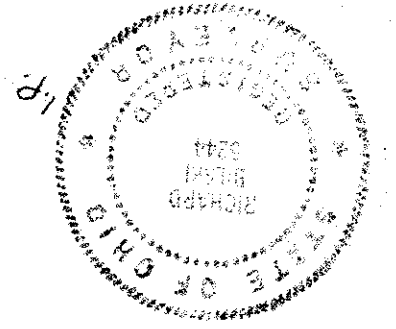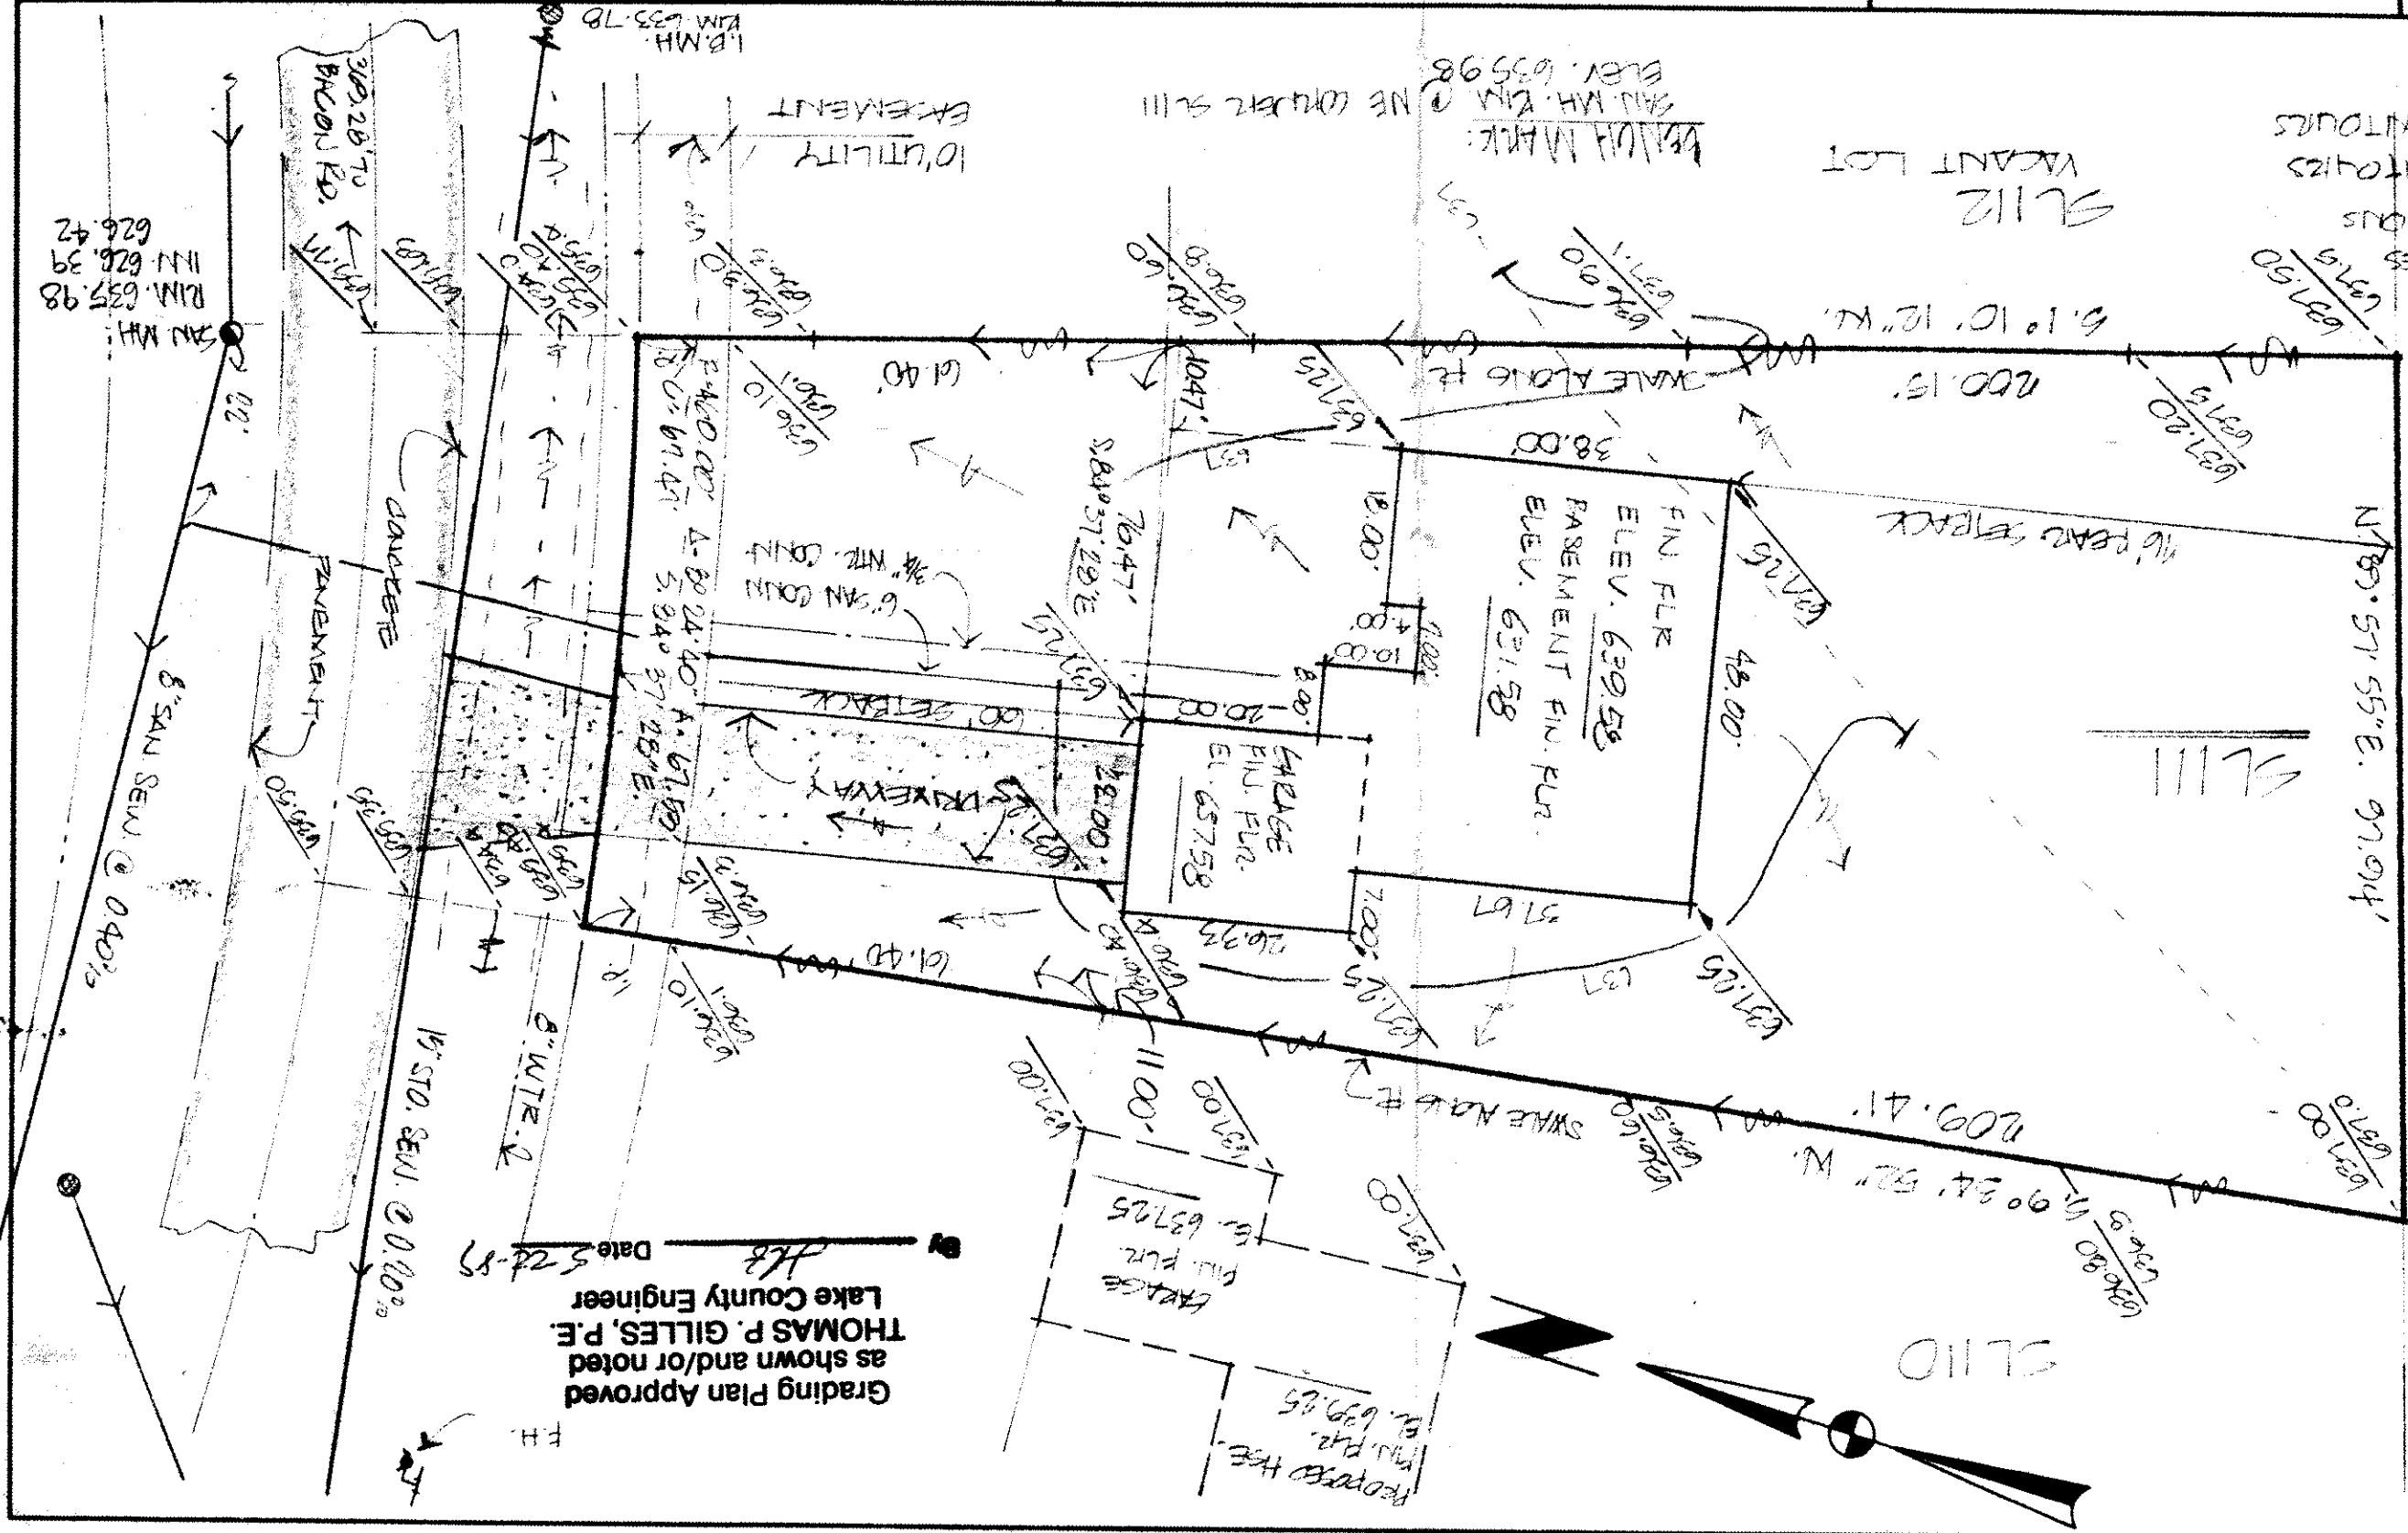

Turning Point #7226