

Grading Plan Approved
as shown and/or noted
THOMAS P. GILLES, P.E.
Lake County Engineer
by GPH Date 5/10/90

LEGEND:
636.00 PROPOSED GRADES
636.0 EXISTING ELEVATIONS

EXISTING CONTOURS
PROPOSED CONTOURS

This Permit Expires
5/19/91
PAINESVILLE TOWNSHIP
ZONING APPROVED
#1501

CT Consultants, Inc.
Engineers • Architects • Planners
Willoughby • Mentor • North Canton • Steubenville • Lorain

CAD.DWG NO. 01.0395.DWG
SHEET NO. 1 OF 1
DATE MAY 15, 1990
DRAWN BY C.O.B.
CHECKED BY
APPROVED BY



EDWARD H. TRESGER, INC.
8100 DEERWOOD BLVD. MENTOR, OHIO 44060
BEING SUBLOT NO. 93 AND SUBLOT NO. 95 IN THE
PINES SUBDIVISION PHASE III-A IN

DATE MAY 15, 1990
DRAWN BY C.O.B.
CHECKED BY
APPROVED BY

DESIGN CERTIFICATION:

I HEREBY CERTIFY THAT THIS PLAN WAS MADE
BY ME, AND IS CORRECT TO THE BEST OF MY
KNOWLEDGE AND BELIEF.

BY: Richard J. Bilicki
RICHARD J. BILICKI, P.E., NO. 5244

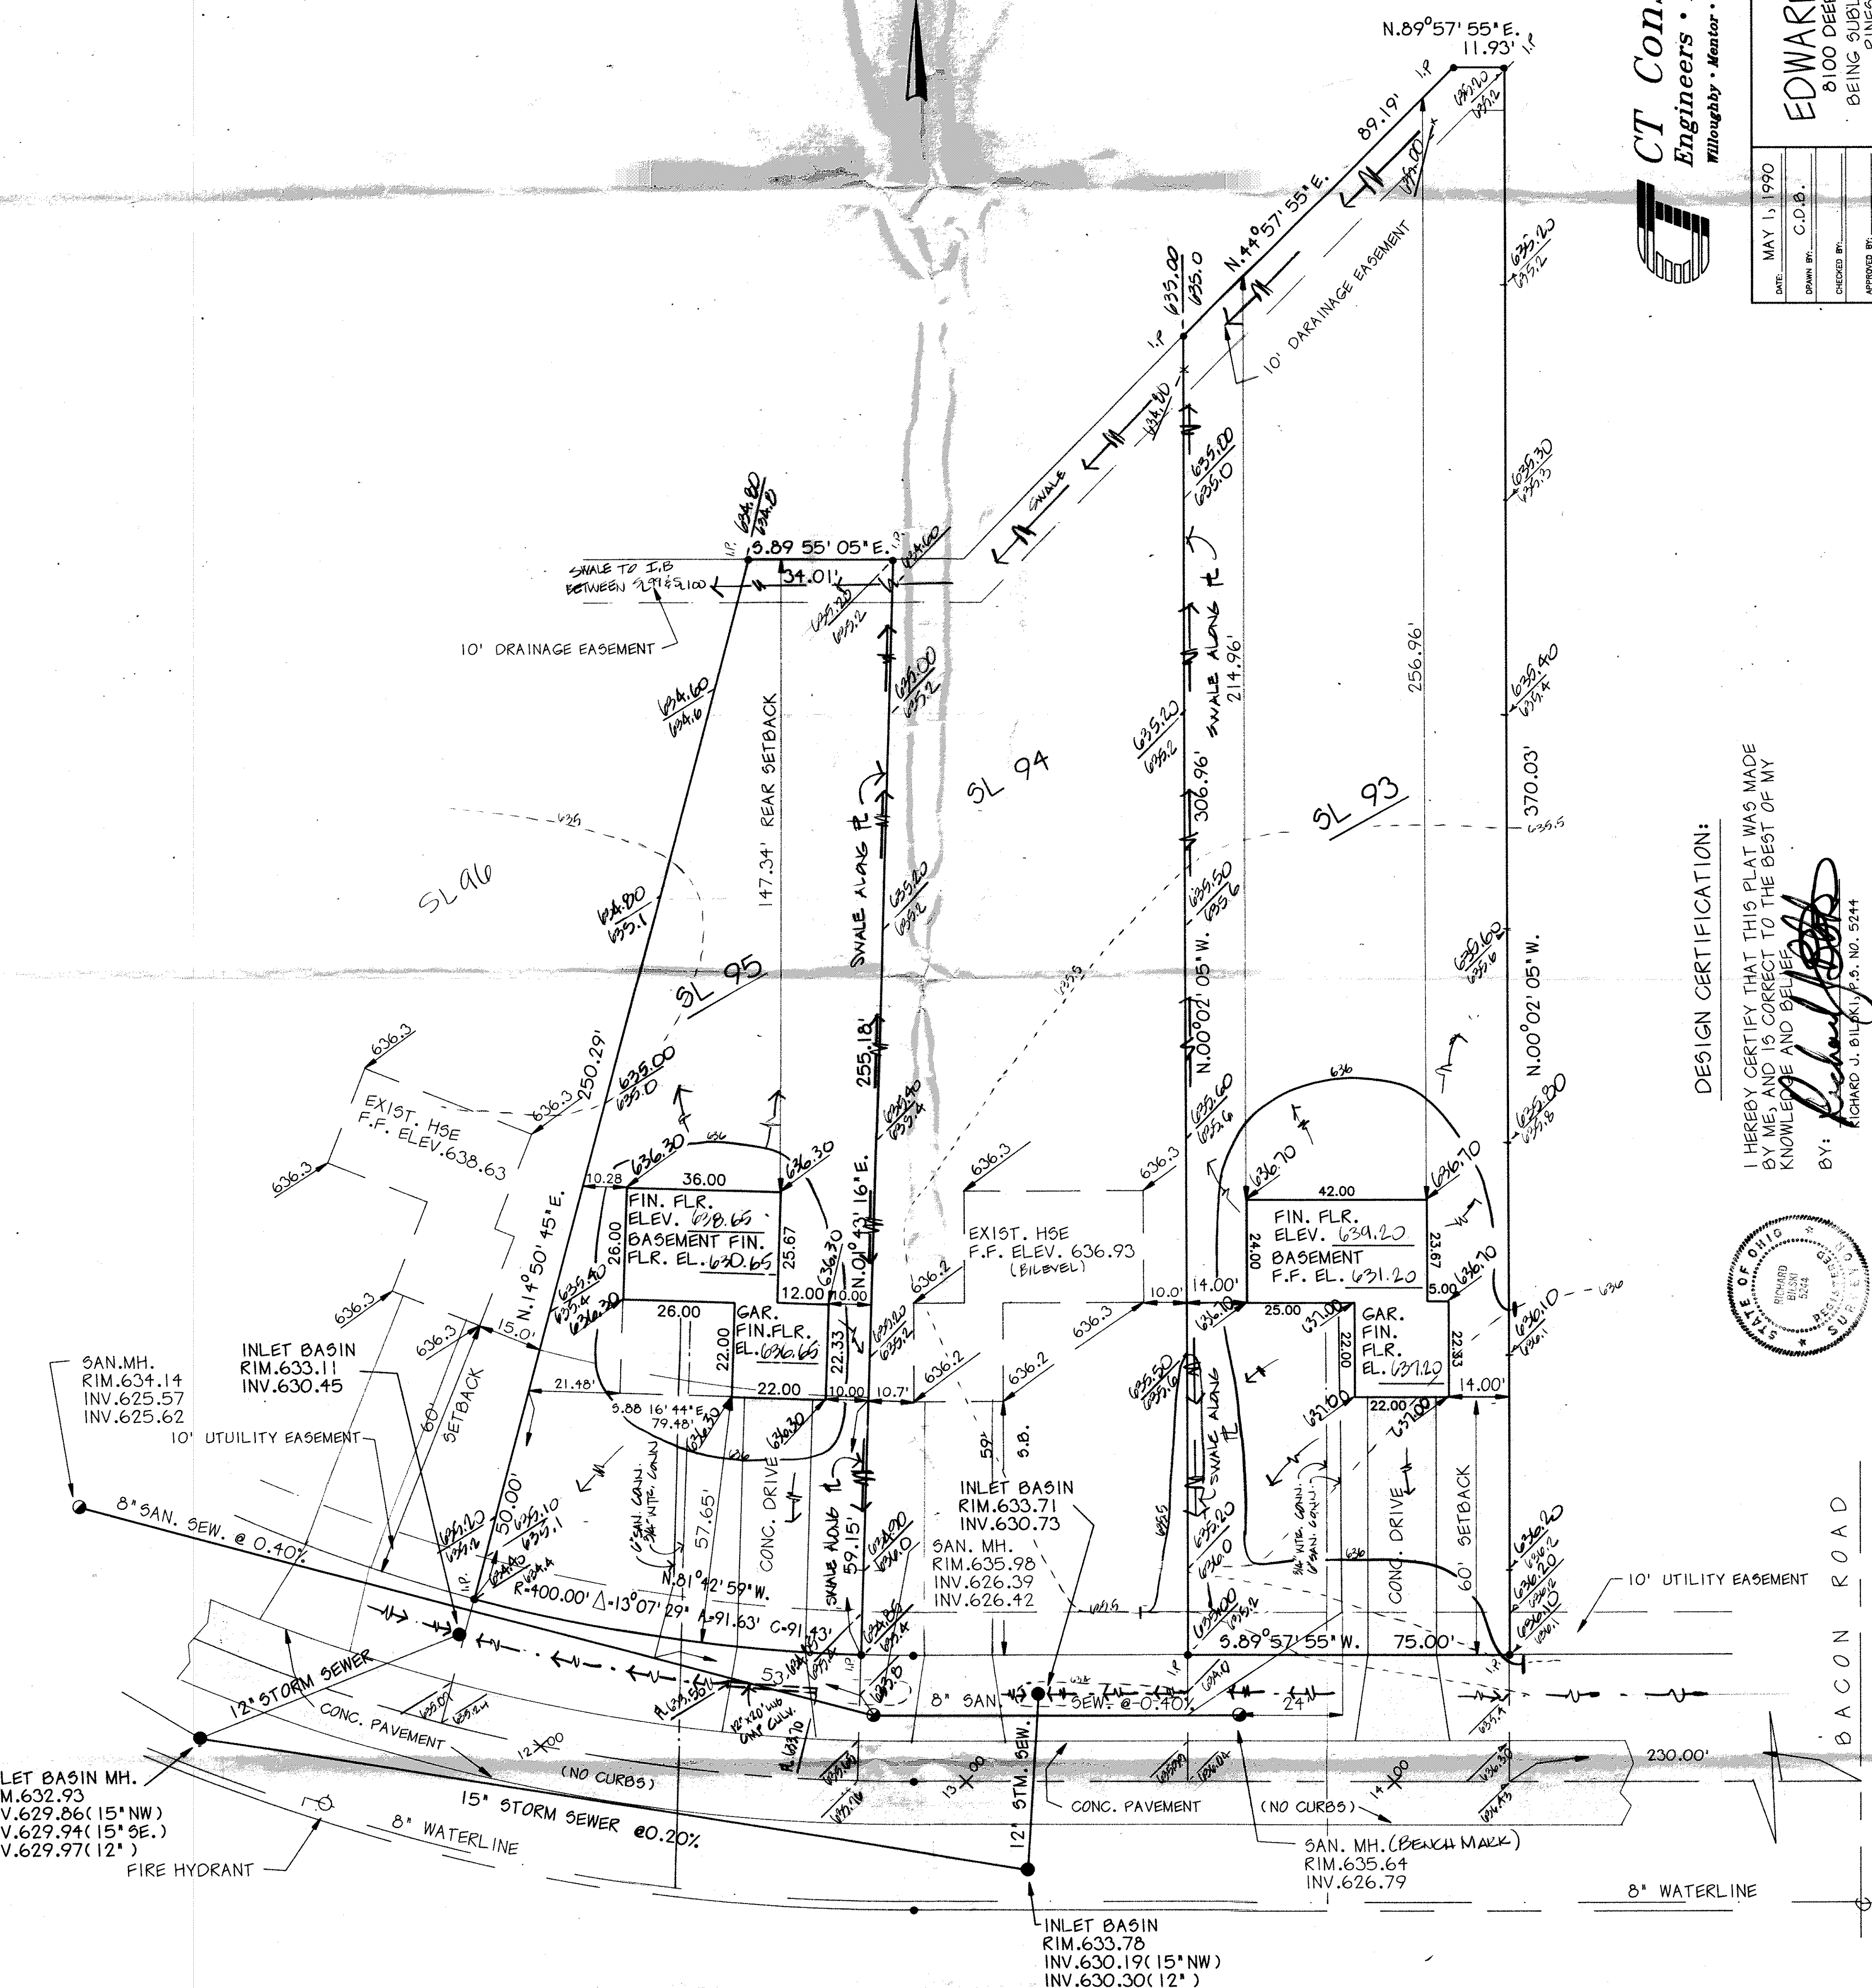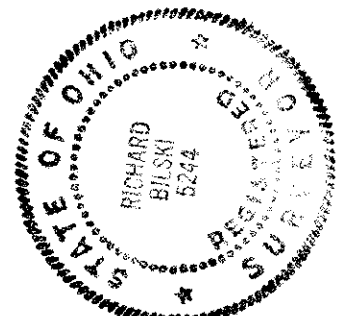

SHEFFIELD TERRACE 60'