


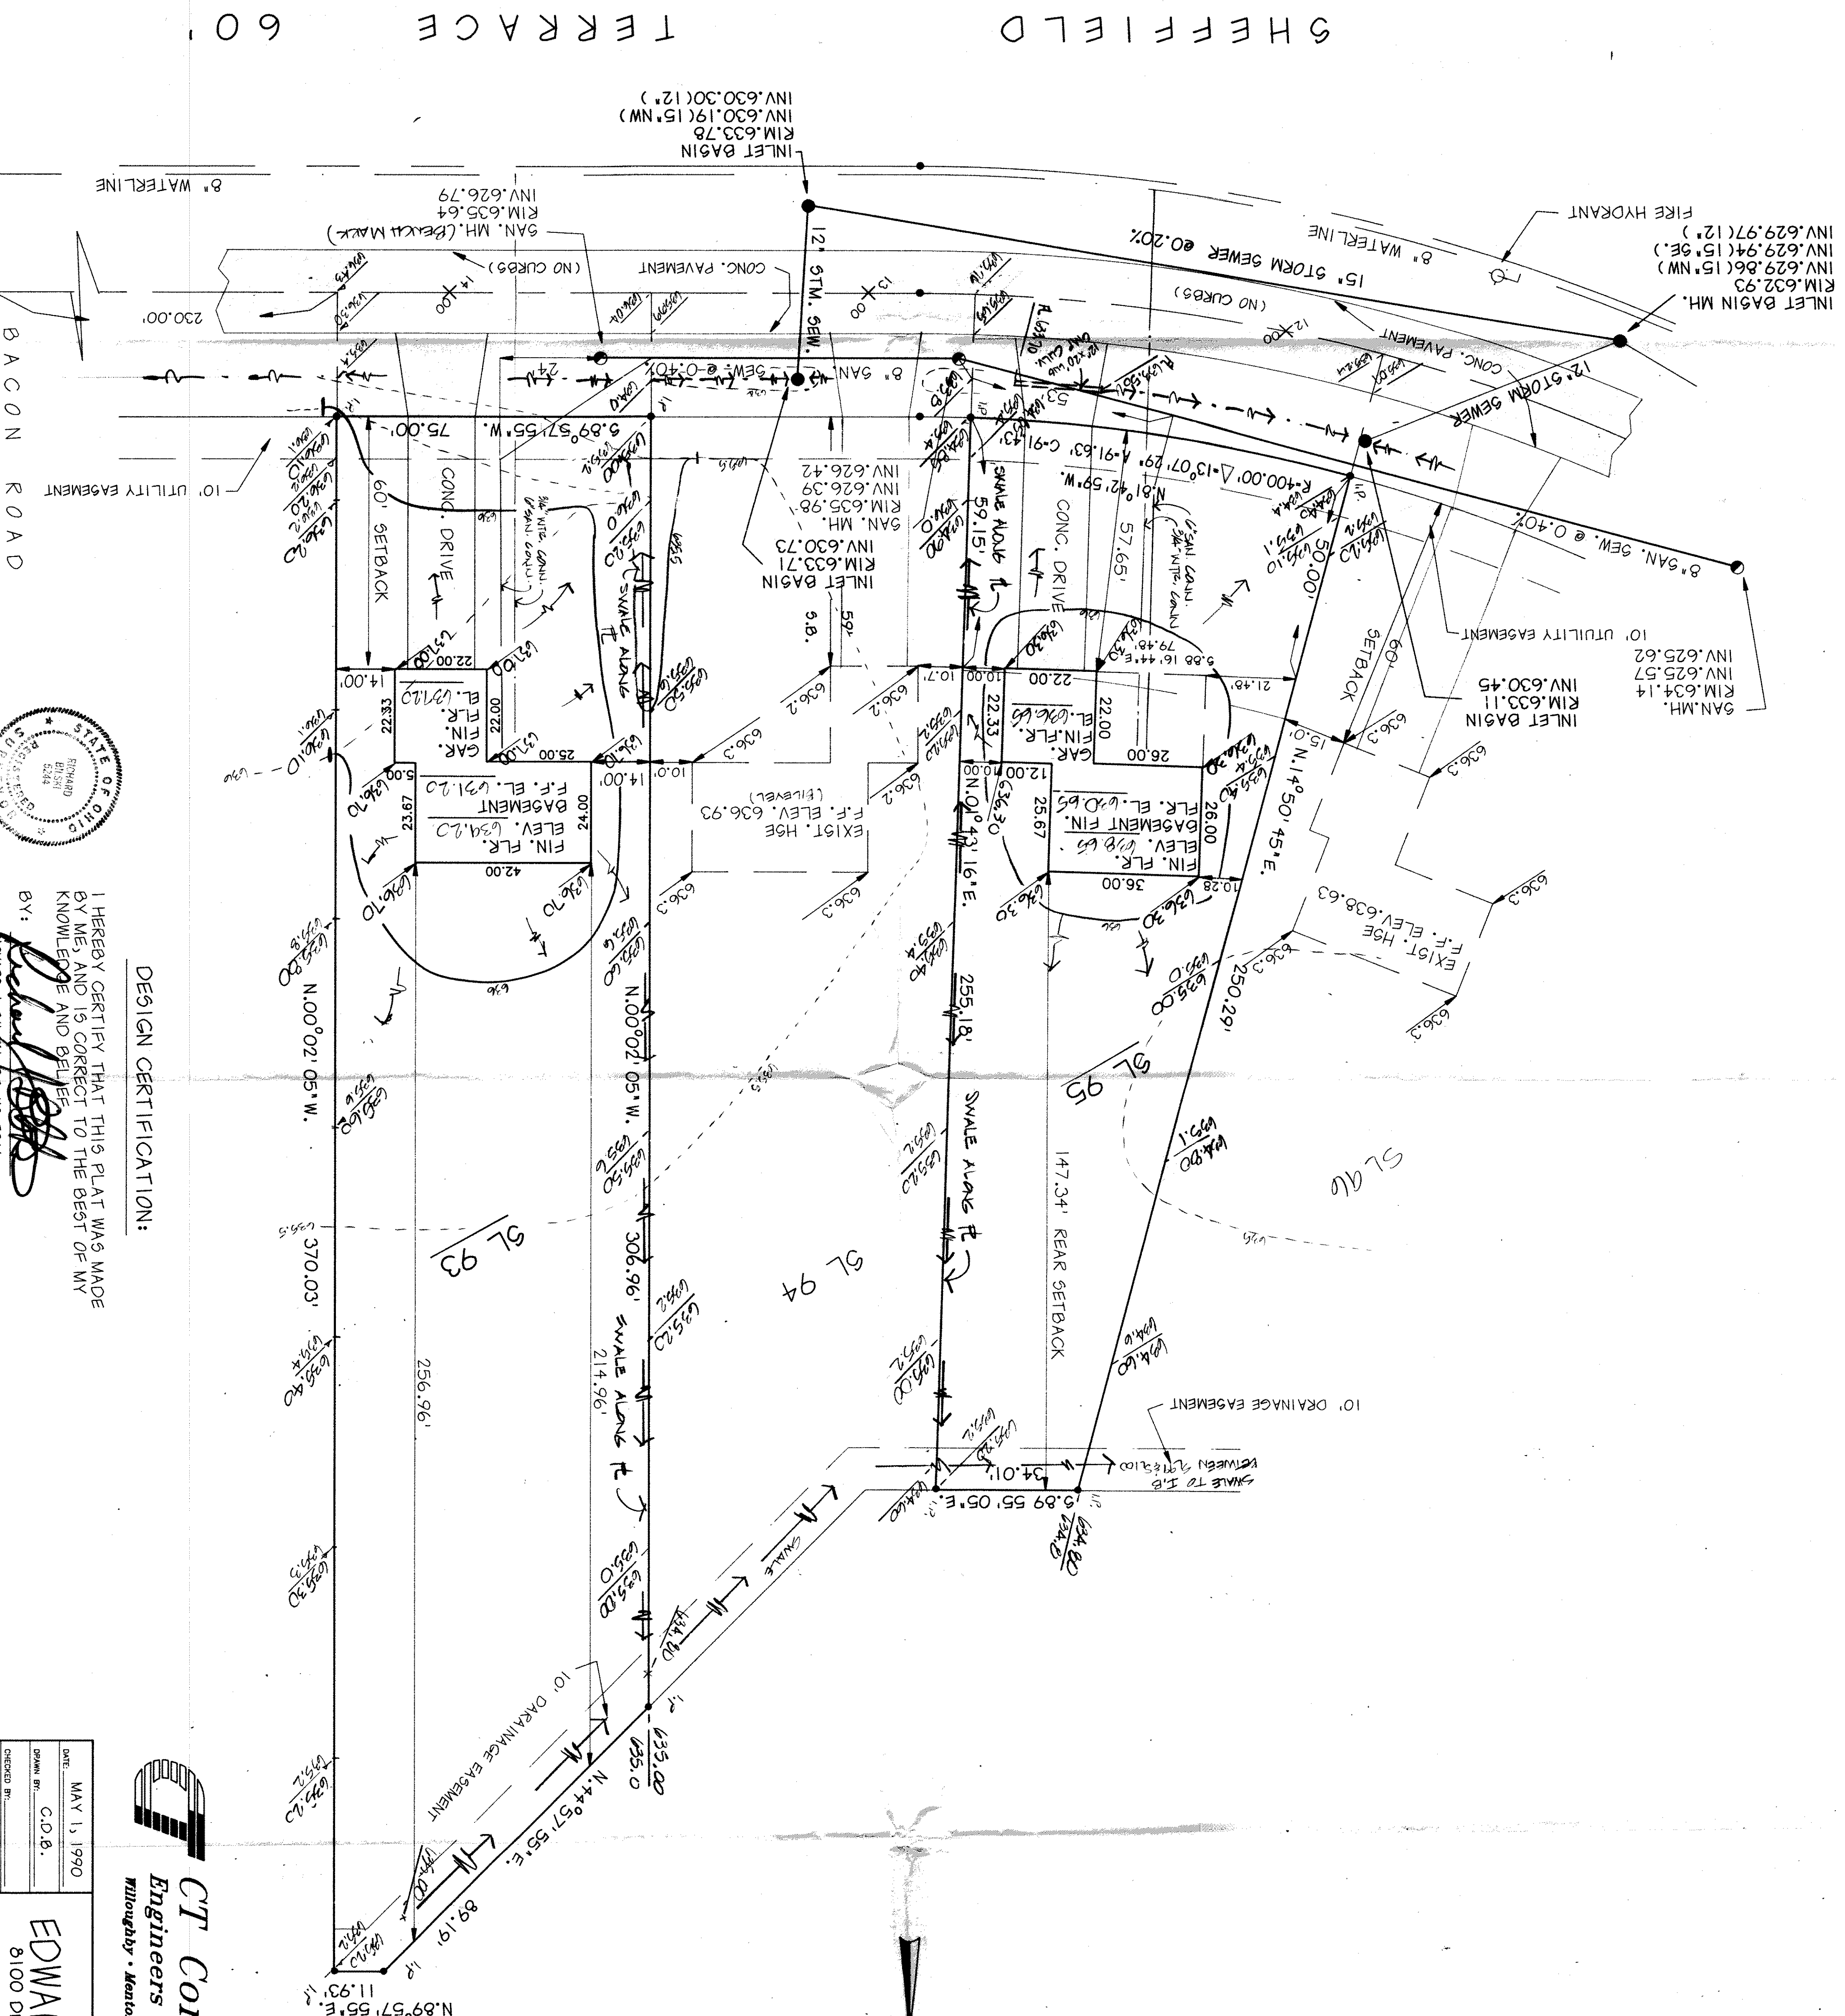


I HEREBY CERTIFY THAT THIS PLAN WAS MADE BY ME, AND IS CORRECT TO THE BEST OF MY KNOWLEDGE AND BELIEF.

BY: *Richard H. Tresger*

DESIGN CERTIFICATION:

DATE	MAY 13, 1990
DRAWN BY	C.D.B.
CHECKED BY	
SITE PLAN FOR	
EDWARD H. TRESGER, INC.	
8100 DEERWOOD BLVD. MENTOR, OHIO 44060	
NO.	1
DATE	11/11/1989
CONTRACT NO.	

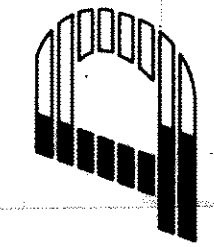

CT Consultants, Inc.
Engineers • Architects • Planners
Miloughby • Mentor • North Canton • Steubenville • Lorain

This Permit Expires

5/1/90

PAINESVILLE TOWNSHIP

ZONING APPROVED

#1500

Zoning Inspector

Grading Plan Approved
as shown and/or noted
THOMAS P. GILLES, P.E.
Lake County Engineer
By: *TDH* Date: 5/10/90

LEGEND:
636.00 PROPOSED GRADES
636.0 EXISTING ELEVATIONS
EXISTING CONTOURS
PROPOSED CONTOURS