



# NORTH RIDGE ROAD 60'

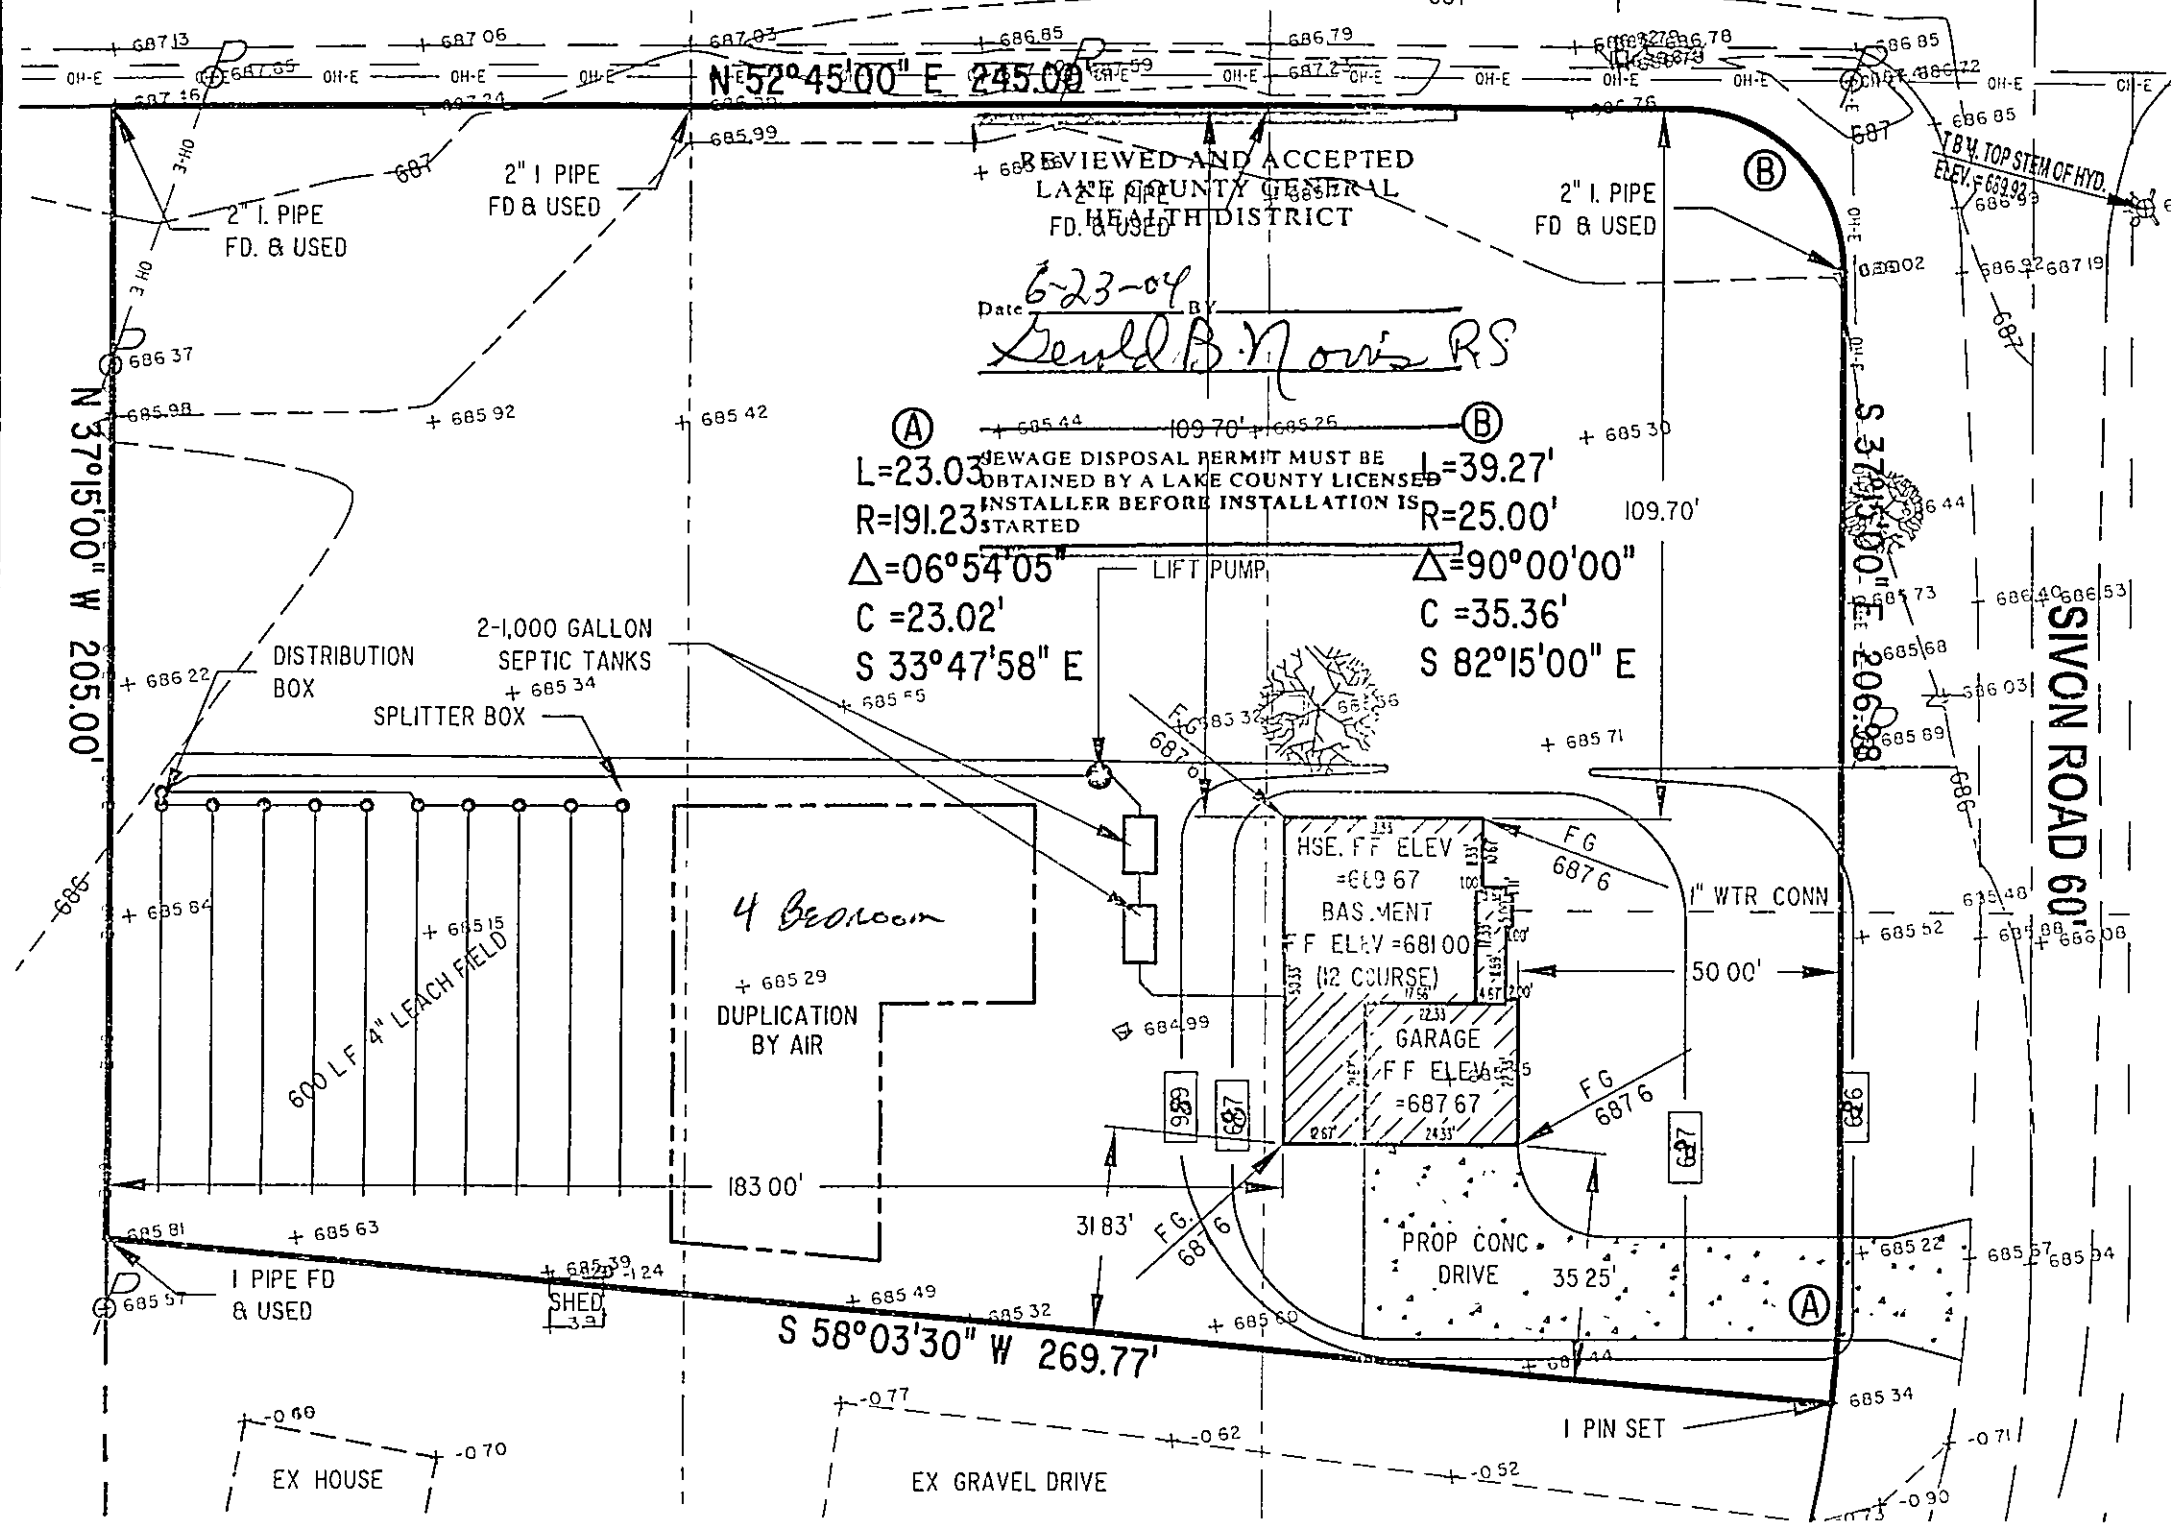

## GRAPHIC SCALE

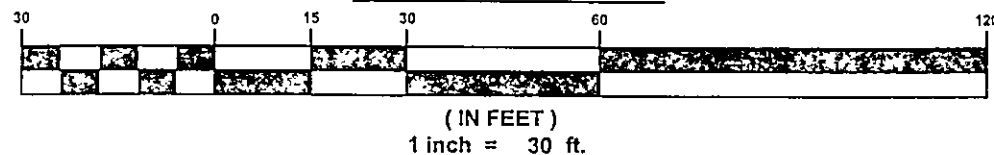

## GENERAL NOTES:

1. BENCHMARK - TOP STEM OF EXISTING FIRE HYDRANT LOCATED ON THE SOUTHEAST CORNER OF N RIDGE RD. & SIVON RD., ELEVATION = 689.92.
2. DRIVEWAY APRON TO BE 6" THICK CONCRETE
3. ALL DOWNSPOUTS TO BE OUTLETED TO SPLASH BLOCKS.
4. CONTRACTOR RESPONSIBLE FOR CONTACTING THE OHIO UTILITY PROTECTION SERVICE (1 800 362 2764) AND ALL UTILITY COMPANIES A MINIMUM OF 48 HOURS PRIOR TO CONSTRUCTION.
5. THE LOCATION BOTH HORIZONTAL AND VERTICAL OF EXISTING UNDERGROUND UTILITIES SHOWN HEREON, HAVE BEEN OBTAINED BY A DILIGENT AND COMPREHENSIVE SEARCH OF AVAILABLE RECORDS. VERIFICATION BY FIELD OBSERVATION HAS BEEN CONDUCTED WHERE PRACTICAL, HOWEVER, BARRINGTON CONSULTING GROUP, INC. DOES NOT GUARANTEE THE COMPLETENESS, NOR ACCURACY THEREOF
6. CONTRACTOR SHALL VERIFY ELEVATIONS OF LATERAL INVERTS IN THE FIELD PRIOR TO FOUNDATION EXCAVATION.
7. SEE SHEET 2 FOR EROSION AND SEDIMENT-CONTROL PLAN
8. SEE SHEET 2 FOR SEEDING INFORMATION.

## CERTIFICATION:

"I THE UNDERSIGNED HEREBY CERTIFIES THAT THIS TOPOGRAPHY INDICATED BY 1 FOOT CONTOURS AND ELEVATION SHOWN HEREON REPRESENTS AN ACTUAL SURVEY MADE BY ME ON THE 4th DAY OF MAY, 2004 AND THE ELEVATIONS WERE TAKEN AT AN APPROPRIATE INTERVAL AND AS OF THAT DAY THEY EXISTED AS INDICATED HEREON.

"I HEREBY CERTIFY THAT THIS PLAN WAS PREPARED BY ME AND IS CORRECT TO THE BEST OF MY KNOWLEDGE AND BELIEF"

DAVID W. SNOW, P.E., Survey Management  
 Approved as shown and/or not  
 JAMES R. GILLS, P.E.  
 County Drainage Engineer  
 By GJH Date 6/2/04

APPROVED  
 PAINESVILLE TOWNSHIP  
 ZONING DEPARTMENT  
 2004/205  
 DRUOT

REVISIONS	BY

**Barrington**  
 CONSULTING GROUP, INC.  
 33342 WESTERN PARKWAY, SUITE 10  
 WILLOUGHBY, OHIO 44094  
 PHONE 440.946.1761 FAX 440.918.0486



**SITE PLAN**  
 P.P. No. 11B-035B-015 NORTH RIDGE RD.  
 PAINESVILLE TWP. OHIO 44077  
 LITTLE MOUNTAIN HOMES, INC.

DRAWN WSO	CHECKED DWN
DATE JUNE 08 2004	SCALE 1" = 30'
JOB NO. 04024	SHEET 1/3