PAINESVILLE TOWNSHIP ZONING APPROVED This Permit Expires Zoning Inspector/9/19/97 6781

EN1000

X 75/ 500 1 16.88.50 10.88.50

SURVEYOR REG. NO.

REGISTERED

"AS BUILT" CERTIFICATION
I, HEREBY CERTIFY THAT THE CIRCLED GRADES ARE EXISTING
FINISH GRADES CHECKED IN THE FIELD ON 19 19 19 AND ARE CORRECT TO THE BEST OF MY KNOWLEDGE AND BELIEF.

*****				C	CHECK LIST	LIST	
6 4	8	NO. OF BEDROOMS	ā			WATER MAIN SIZE, LOCATION	
		DINENSIONS				SAN. SEWER SIZE % GR. LOC.	
	1	TIE TO NEAREST STREET	T STREET	7		SAN, MH. CAST. ELEV. INV. ELEV.	
	S	SUBLOT NO. PARCEL NO.	RCEL NO	•		SAN. CONN. SIZE, LOC. DEFIN	
	ş	SURROUNDING OWNERS	OWNERS			STORM SEWER SIZE & GR. LOC.	
	ב	BLDG. DIMENSIONS FIN. GR.	ONS FIN.	GR.		STORM MH. CASI GLEV. INV. GLEV.	
	-	LDG. TIES FL'R. GRADES	R. GRADE	**		PAVT TYPE GRADE CURBS	
	ì	PRON TYPE WIGHT THICKNESS	HIT HTO	CKNESS	j i	GAS LINE LOC. SIZE TRESOURE	
	50	SIDEWALK TYPE WIOTH THICKNESS	HIOTH	THICKNESS		SEPTIC TANK LOCATION & DUFLICATION AND	
	3	CULVERT TYPE DIA., LENGTH	DIA., LEP	GTH		WELL LOCATION	
	3	HOCK OUTCHOPPINGS	TINGS			SOLVE STORY STORY	_
		REVISIONS				PLAN PREPARED BY:	
	Š	DATE	₹	200		IONIES & ASSOCIATES INC	
	-			DADC		BABCUCA JUNES & ASSUCIA LES, INC.	•
	2					PAINESVILLE, OPIO	<u> </u>
	ပ			DRAWN BY	THE	SCALE 1" = 70 PHONE NO. 357-1811	
	•			CHK'D.	Ħ	DATE PARAMING NO.	
	55			CREW	1.32	APP'D. Color (10)	
	•			CHIEF	A.		

NAME SURVEYOR REGISTRATION NO.

DESIGN CERTIFICATION
THIS PLAT WAS PREPARED BY ME, AND IS CORRECT
TO THE BEST OF MY KNOWLEDGE AND BELIEF.

LOCATIONS AS SHOWN OF ADJACENT WELLS AND SEPTIC TANKS OBTAINED FROM LAKE COUNTY HEALTH DEPARTMENT

ALL BOUNDARY DATA SHOWN WAS OBTAINED FROM (DEEDS, RECORDED SUBDIVISION PLAT OR OTHER PUBLIC RECORDS)

REMARKS


V SURFACE DRAINAGE	D - PROP. ELEV.	LEV 100	EXIST. ELEV.
S DIRECTION OF		PROPOSED CONTOURS	PROPOSE
INDICATES		EXISTING CONTOURS	EXISTIN
\ \ \ \ \ \ \ \ \ \ \ \ \ \ \ \ \ \ \	<del></del>	7	HYDRANT
AS BUILT ELEVATION		INLET OR CATCH BASIN	INLET O
		MANHOLE	STORM
WATER VALVE (GAS)		AN MANHOLE	SANITARY

LEGEND	BOUNDIVISION Y-/7 NAME  3/ VOL-POLICION OTTO  SUBLOT NO. STREET  SUBLOT NO.
END VALVE (GAS)	VOLUME PENM. PARCEL NO.
-	TRACT PAGE STREET

NON Y-17 NAME  VOL-PO NAME  VOL-PO NAME  VOL-PO NAME	ADDRESS STREET
AOLUWE FOL	T CITY
TRACT PAGE	AF

TOWNS THE LAKE COUNTY, OHIO SITE PLAN

HARRYS.
JONES, JR.
C.65.3 OPVE TO

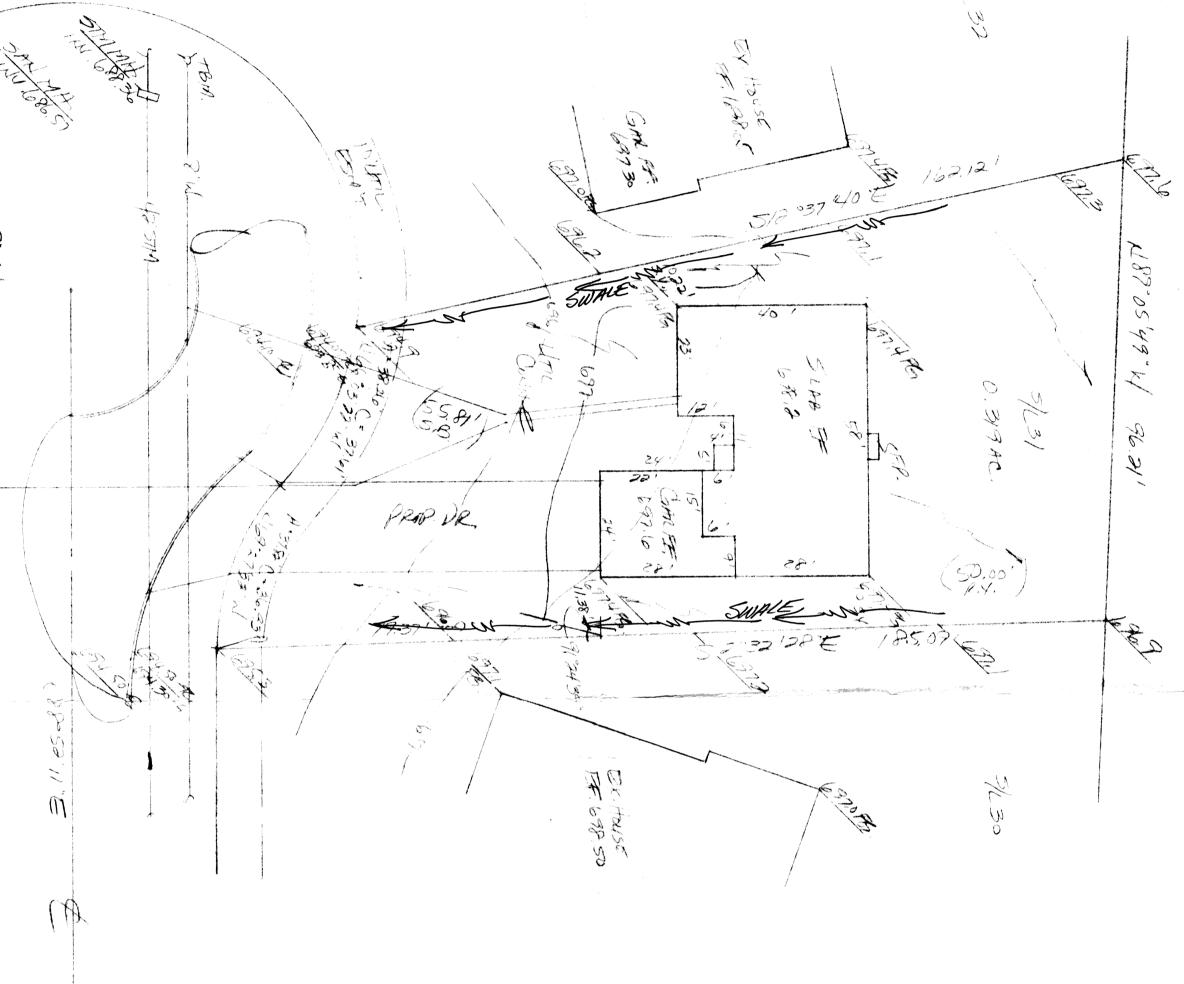

Grading Plan Approved as shown and/or noted THOMAS P. GILLES, P.E. Lake County Engineer

Date 8:// Date 8.17.57

for:

IERRA

BUILDERS

Ву