

SITE PLAN

PAINESVILLE TOWNSHIP, LAKE COUNTY, OHIO
for: GREAT EASTERN CONSTRUCTION
CLIENT: DAVE & SYCAMORE

ADDRESS: PAINESVILLE, OHIO CITY: PAINESVILLE ZIP: 43084

LOT: 10 TRACT: 10
SUBDIVISION: 10-15 NAME: PAINESVILLE PAGE: 1
SHEET NO.: 1 SHEET: 1

LEGEND

SEWAGE MANHOLE (S) WATER VALVE (W) WATER METER (M)
STORM MANHOLE (SM) AS BUILT ELEVATION (A) INLET OR CATCH BASIN (IB)
HYDRANT (H) EXISTING CONTOURS (C) PROPOSED CONTOURS (P)
EXIST. ELEV. (E) PROP. ELEV. (P) INDICATES DIRECTION OF SURFACE DRAINAGE (D)

REMARKS

ALL BOUNDARY DATA SHOWN WAS OBTAINED FROM (RECORD, RECORDED SUBDIVISION PLAT OR OTHER PUBLIC RECORD)
LOCATIONS AS SHOWN OF ADJACENT WELLS AND SEPTIC TANKS OBTAINED FROM LAKE COUNTY HEALTH DEPARTMENT

DESIGN CERTIFICATION

THIS PLAT WAS PREPARED BY ME, AND IS CORRECT TO THE BEST OF MY KNOWLEDGE AND BELIEF.

NAME: HARRY S. JONES, JR. SURVEYOR REGISTRATION NO.: 55343

CHECK LIST

NO. OF BEDROOMS: 3 WATER MAIN SIZE, LOCATION: 8" 150' 10" 10"
SEWERS: 12" 150' 10" 10" SAN. IN. CAST ELEV. INV. ELEV. 100.0
TIE TO NEAREST STREET: PAINESVILLE AVE. SAN. CONN. SIZE LOC. DEPTH: 12" 150' 10" 10"
SUBDIVISION NO., PARCEL NO.: 10-15 STORM SEWER SIZE & GR. LOC. STORM IN. CAST ELEV. INV. ELEV. 100.0
BLDG. DIMENSIONS FIN. GR. BLDG. TIES P.L.N. GRADERS: 12" 150' 10" 10" PAVT TYPE GRADE CURBS: 12" 150' 10" 10"
APPROX. TYPE WIDTH THICKNESS: 12" 150' 10" 10" GAS LINE LOC. SIZE PRESSURE: 12" 150' 10" 10"
SEWER/TANK TYPE WIDTH THICKNESS: 12" 150' 10" 10" SEPTIC TANK LOCATION & DUPPLICATION AREA: 12" 150' 10" 10"
ROCK OUTCROPPINGS: 12" 150' 10" 10" WELL LOCATION: 12" 150' 10" 10"
ISOLATION RADIIUS FROM WELL: 12" 150' 10" 10"

PLAN PREPARED BY:

BABCOCK • JONES & ASSOCIATES, INC. PAINESVILLE, OHIO

NO.	DATE	BY
1		
2		
3		
4		
5		



DRAWN BY: <u>H.S.</u>	SCALE: <u>1" = 20'</u>	PHONE NO.: <u>357-1811</u>
CHK'D: <u>H.S.</u>	DATE: <u>9/24/77</u>	DRAWING NO.: <u>27-052-19</u>
CHIEF: <u>H.S.</u>	APPROVED: <u>H.S.</u>	

"AS BUILT" CERTIFICATION

I, HEREBY CERTIFY THAT THE CIRCLED GRADES ARE EXISTING FINISH GRADES CHECKED IN THE FIELD ON 19 AND ARE CORRECT TO THE BEST OF MY KNOWLEDGE AND BELIEF.

REGISTERED SURVEYOR REG. NO. 55343

SYCAMORE DAVE - 40'

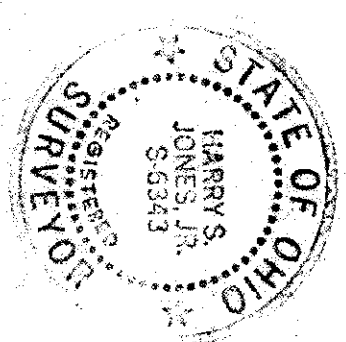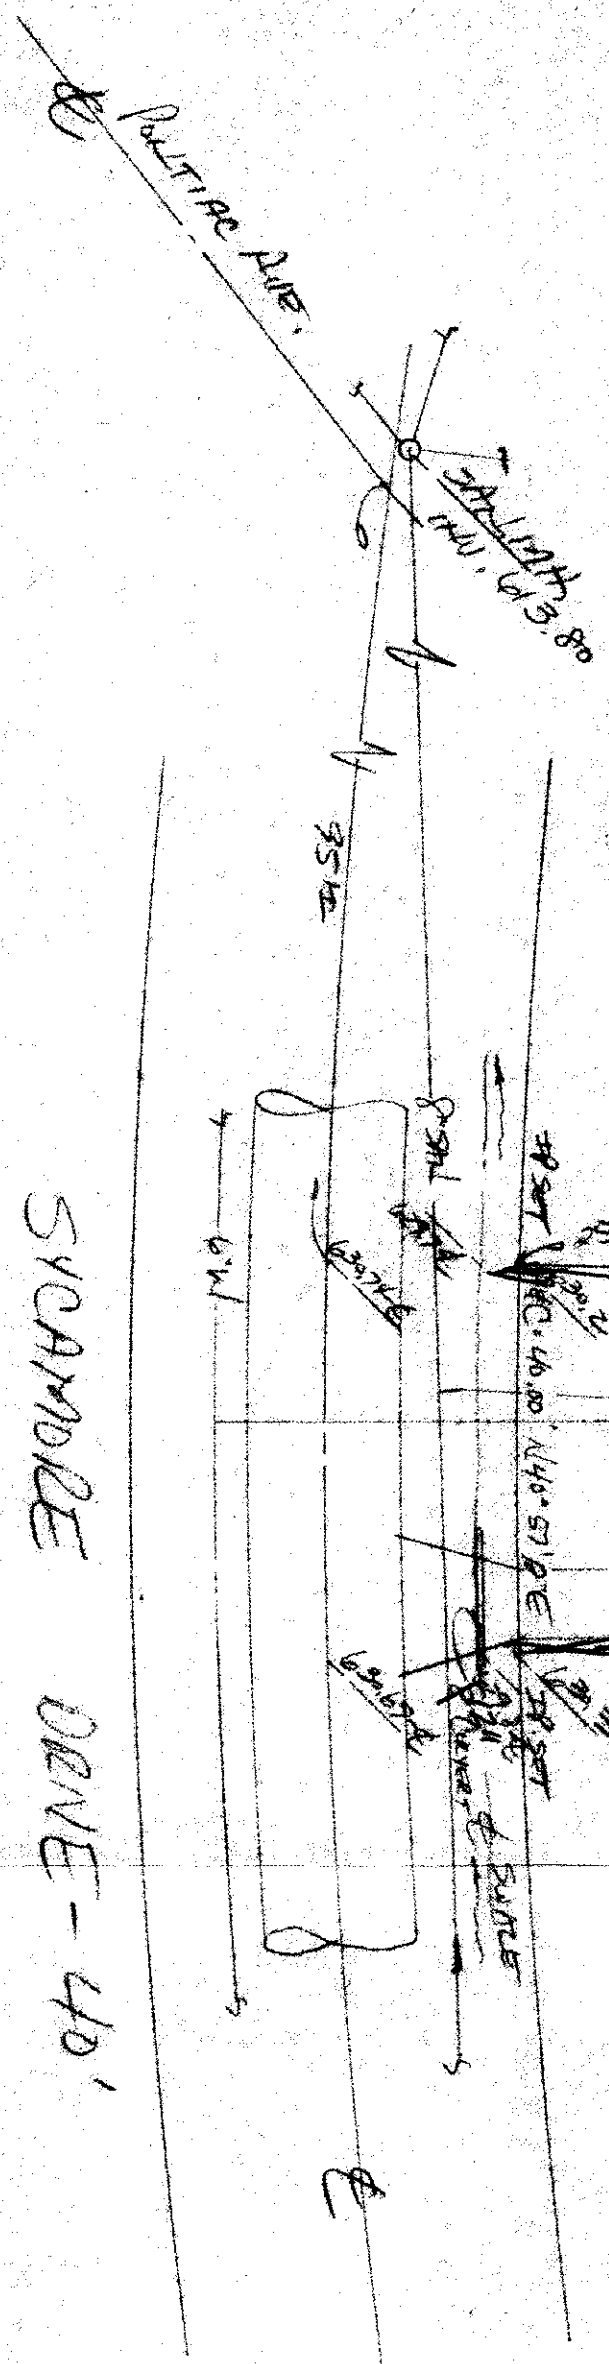

Grading Plan Approved
as shown and/or noted
THOMAS P. GILLES, P.E.
Lake County Engineer
By: [Signature] Date: 12-18-77

This Permit Expires 1-19-89
PAINESVILLE TOWNSHIP
ZONING APPROVED
6860
Willie E. [Signature]
Zoning Inspector, 1/19/81