
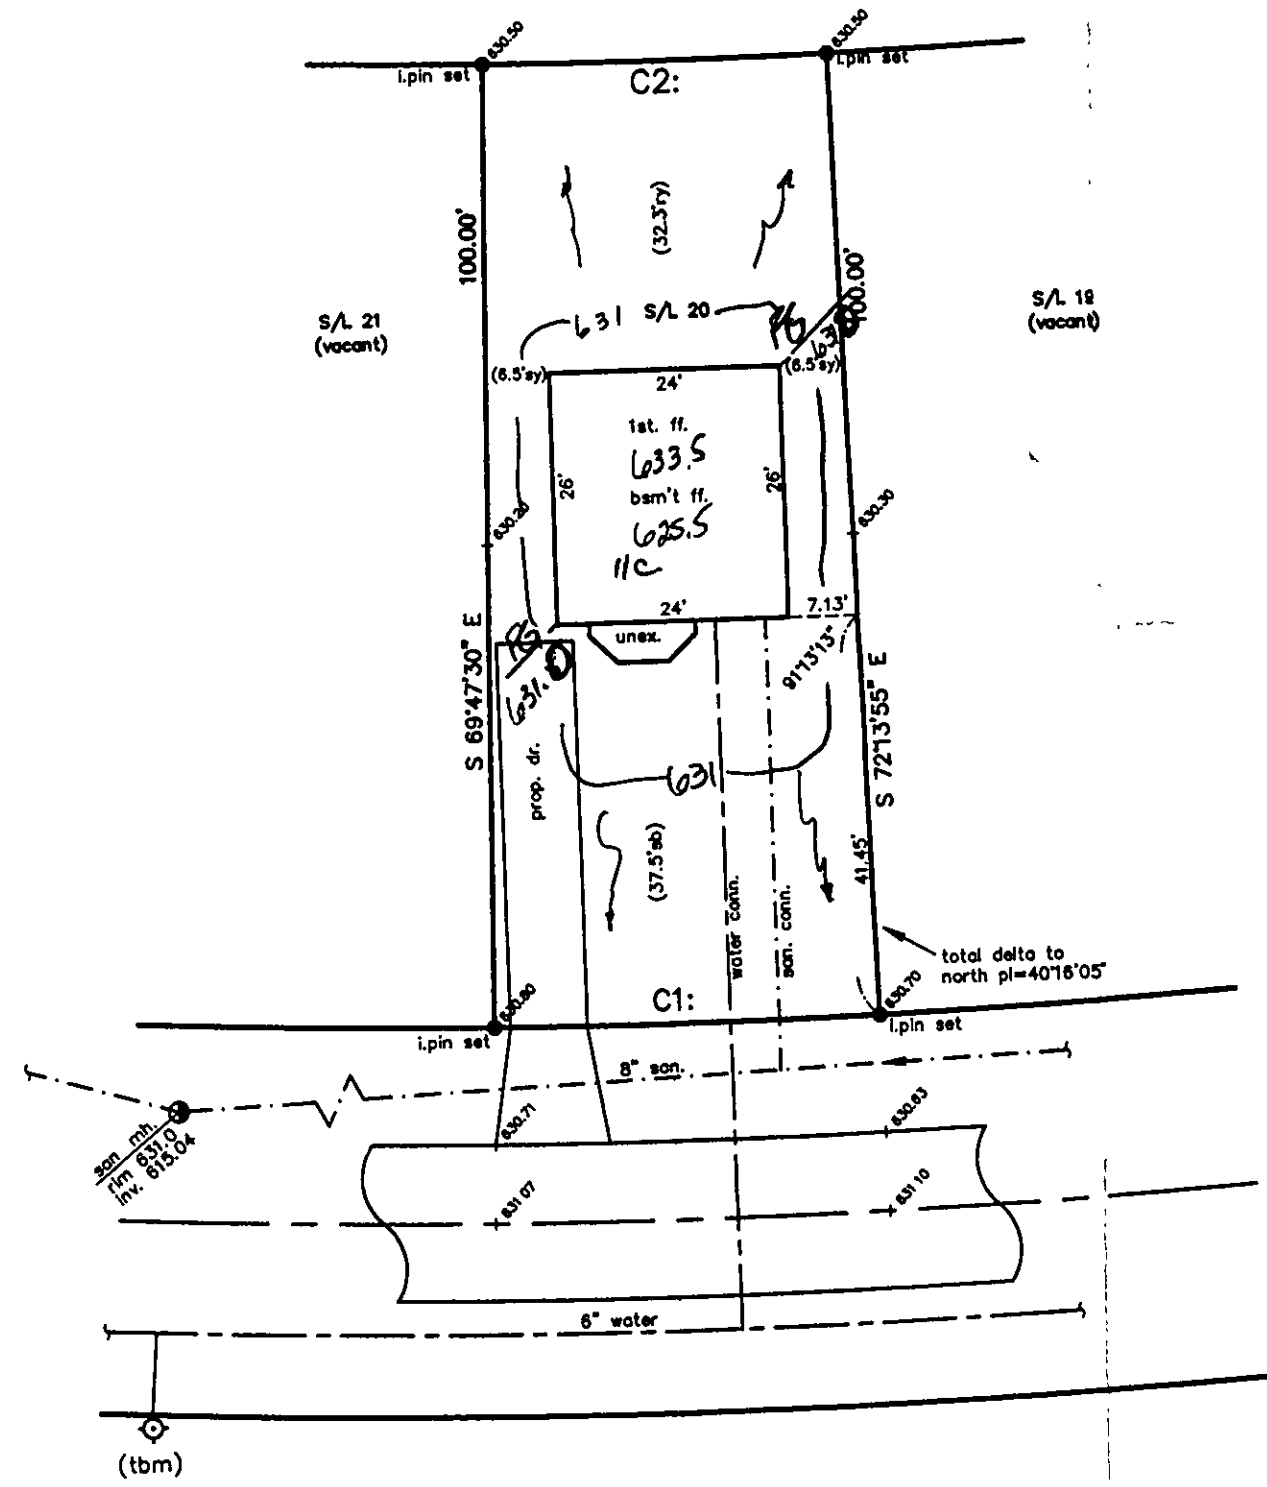


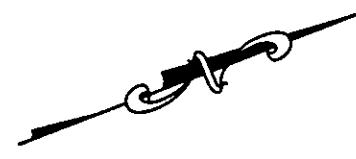

SYCAMORE DRIVE - 40'

APPROVED
PAINESVILLE TOWNSHIP
ZONING DEPARTMENT
19990258
D.R. Hunt

As shown and/or
THOMAS P. GILLES, P.E.
Lake County Engineer
By Tam Date 8/1/99
Lower F.G. to 631.00

ROOF DRAINS
SHALL DISCHARGE
TO SPLASH BLOCKS.

C1: R=939.09' C2: R=839.09'
L=40.00' L=35.74'
C=40.00' C=35.74'
D=02°26'26" D=02°26'26"
N18°59'17"E N18°59'17"E

TBM-TOP F. HYDRANT
ELEV.=632.89

SITE PLAN

PAINESVILLE TWP., LAKE COUNTY, OHIO
for: HARVEY BROS.
CLIENT OWNER
ADDRESS STREET CITY ZIP
PAINESVILLE ON THE LAKE TRACT
SUBDIVISION D-13 NAME LOT STREET
20 VOL-PG SYCAMORE DR. LOT PERM. PARCEL NO.
SUBLOT NO. STREET VOL-PG.

LEGEND
SANITARY MANHOLE --- (circle with cross)
STORM MANHOLE --- (circle with dot)
INLET OR CATCH BASIN --- (rectangle with dot)
HYDRANT --- (circle with cross and dot)
EXISTING CONTOURS --- (dashed line)
PROPOSED CONTOURS --- (solid line)
EXIST. ELEV. --- 100.0
100.0 --- PROP. ELEV.
AS BUILT ELEVATION
INDICATES DIRECTION OF SURFACE DRAINAGE

REMARKS
ALL BOUNDARY DATA SHOWN WAS OBTAINED FROM (DEEDS, RECORDED SUBDIVISION PLAT OR OTHER PUBLIC RECORDS)
LOCATIONS AS SHOWN OF ADJACENT WELLS AND SEPTIC TANKS OBTAINED FROM LAKE COUNTY HEALTH DEPARTMENT

DESIGN CERTIFICATION
THIS PLAT WAS PREPARED BY ME, AND IS CORRECT TO THE BEST OF MY KNOWLEDGE AND BELIEF.
NAME SURVEYOR REGISTRATION NO.

CHECK LIST	
NO. OF BEDROOMS	WATER MAIN SIZE, LOCATION
DIMENSIONS	SAN. SEWER SIZE & GR. LOC.
BEARINGS	SAN. MH. CAST. ELEV. INV. ELEV.
TIE TO NEAREST STREET	SAN. CONN. SIZE, LOC. DEPTH
SUBLOT NO. PARCEL NO.	STORM SEWER SIZE & GR. LOC.
SURROUNDING OWNERS	STORM MH. CAST ELEV. INV. ELEV.
BLDG. DIMENSIONS FIN GR.	PAV'T TYPE GRADE CURBS
BLDG. TIE FL'R. GRADES	GAS LINE LOC. SIZE PRESSURE
APRON TYPE WIDTH THICKNESS	SEPTIC TANK LOCATION & DUPLICATION AREA
SIDEWALK TYPE WIDTH THICKNESS	WELL LOCATION
CULVERT TYPE DIA. LENGTH	ISOLATION RADIUS FROM WELL
ROCK OUTCROPPINGS	

REVISIONS			PLAN PREPARED BY:	
NO.	DATE	BY	BABCOCK - JONES & ASSOCIATES, INC.	
1	1/21/99	tr.	PAINESVILLE, OHIO	
2			DRAWN BY T.R.	SCALE 1"=20'
3			CHK'D. H.J.	DATE 1/7/99
4			APP'D H.J.	PHONE NO. 440-387-1811
5				DRAWING NO. 98-383-20

"AS BUILT" CERTIFICATION
I, HEREBY CERTIFY THAT THE CIRCLED GRADES ARE EXISTING FINISH GRADES CHECKED IN THE FIELD ON 1999, AND ARE CORRECT TO THE BEST OF MY KNOWLEDGE AND BELIEF.

REGISTERED SURVEYOR REG. NO.

