



**Grading Plan Approved**  
as shown and/or noted  
**THOMAS P. GILLES, P.E.**  
**Lake County Engineer**

KNOWN AS BEING SUBLOTS 22 & 21 AND PART TOWN DATE 3/2/97  
OF SUBLLOT 20, BLOCK 6, OF THE PAINESVILLE- BUILD CATCH BASIN  
ON-THE-LAKE SUBDIVISION AS RECORDED IN  
Vol. D, Pg. 13 OF THE LAKE COUNTY RECORDS.  
TOWNSHIP OF PAINESVILLE  
COUNTY OF LAKE - STATE OF OHIO

APPROVED  
PAINESVILLE TOWNSHIP  
ZONING DEPARTMENT  
11/13/14

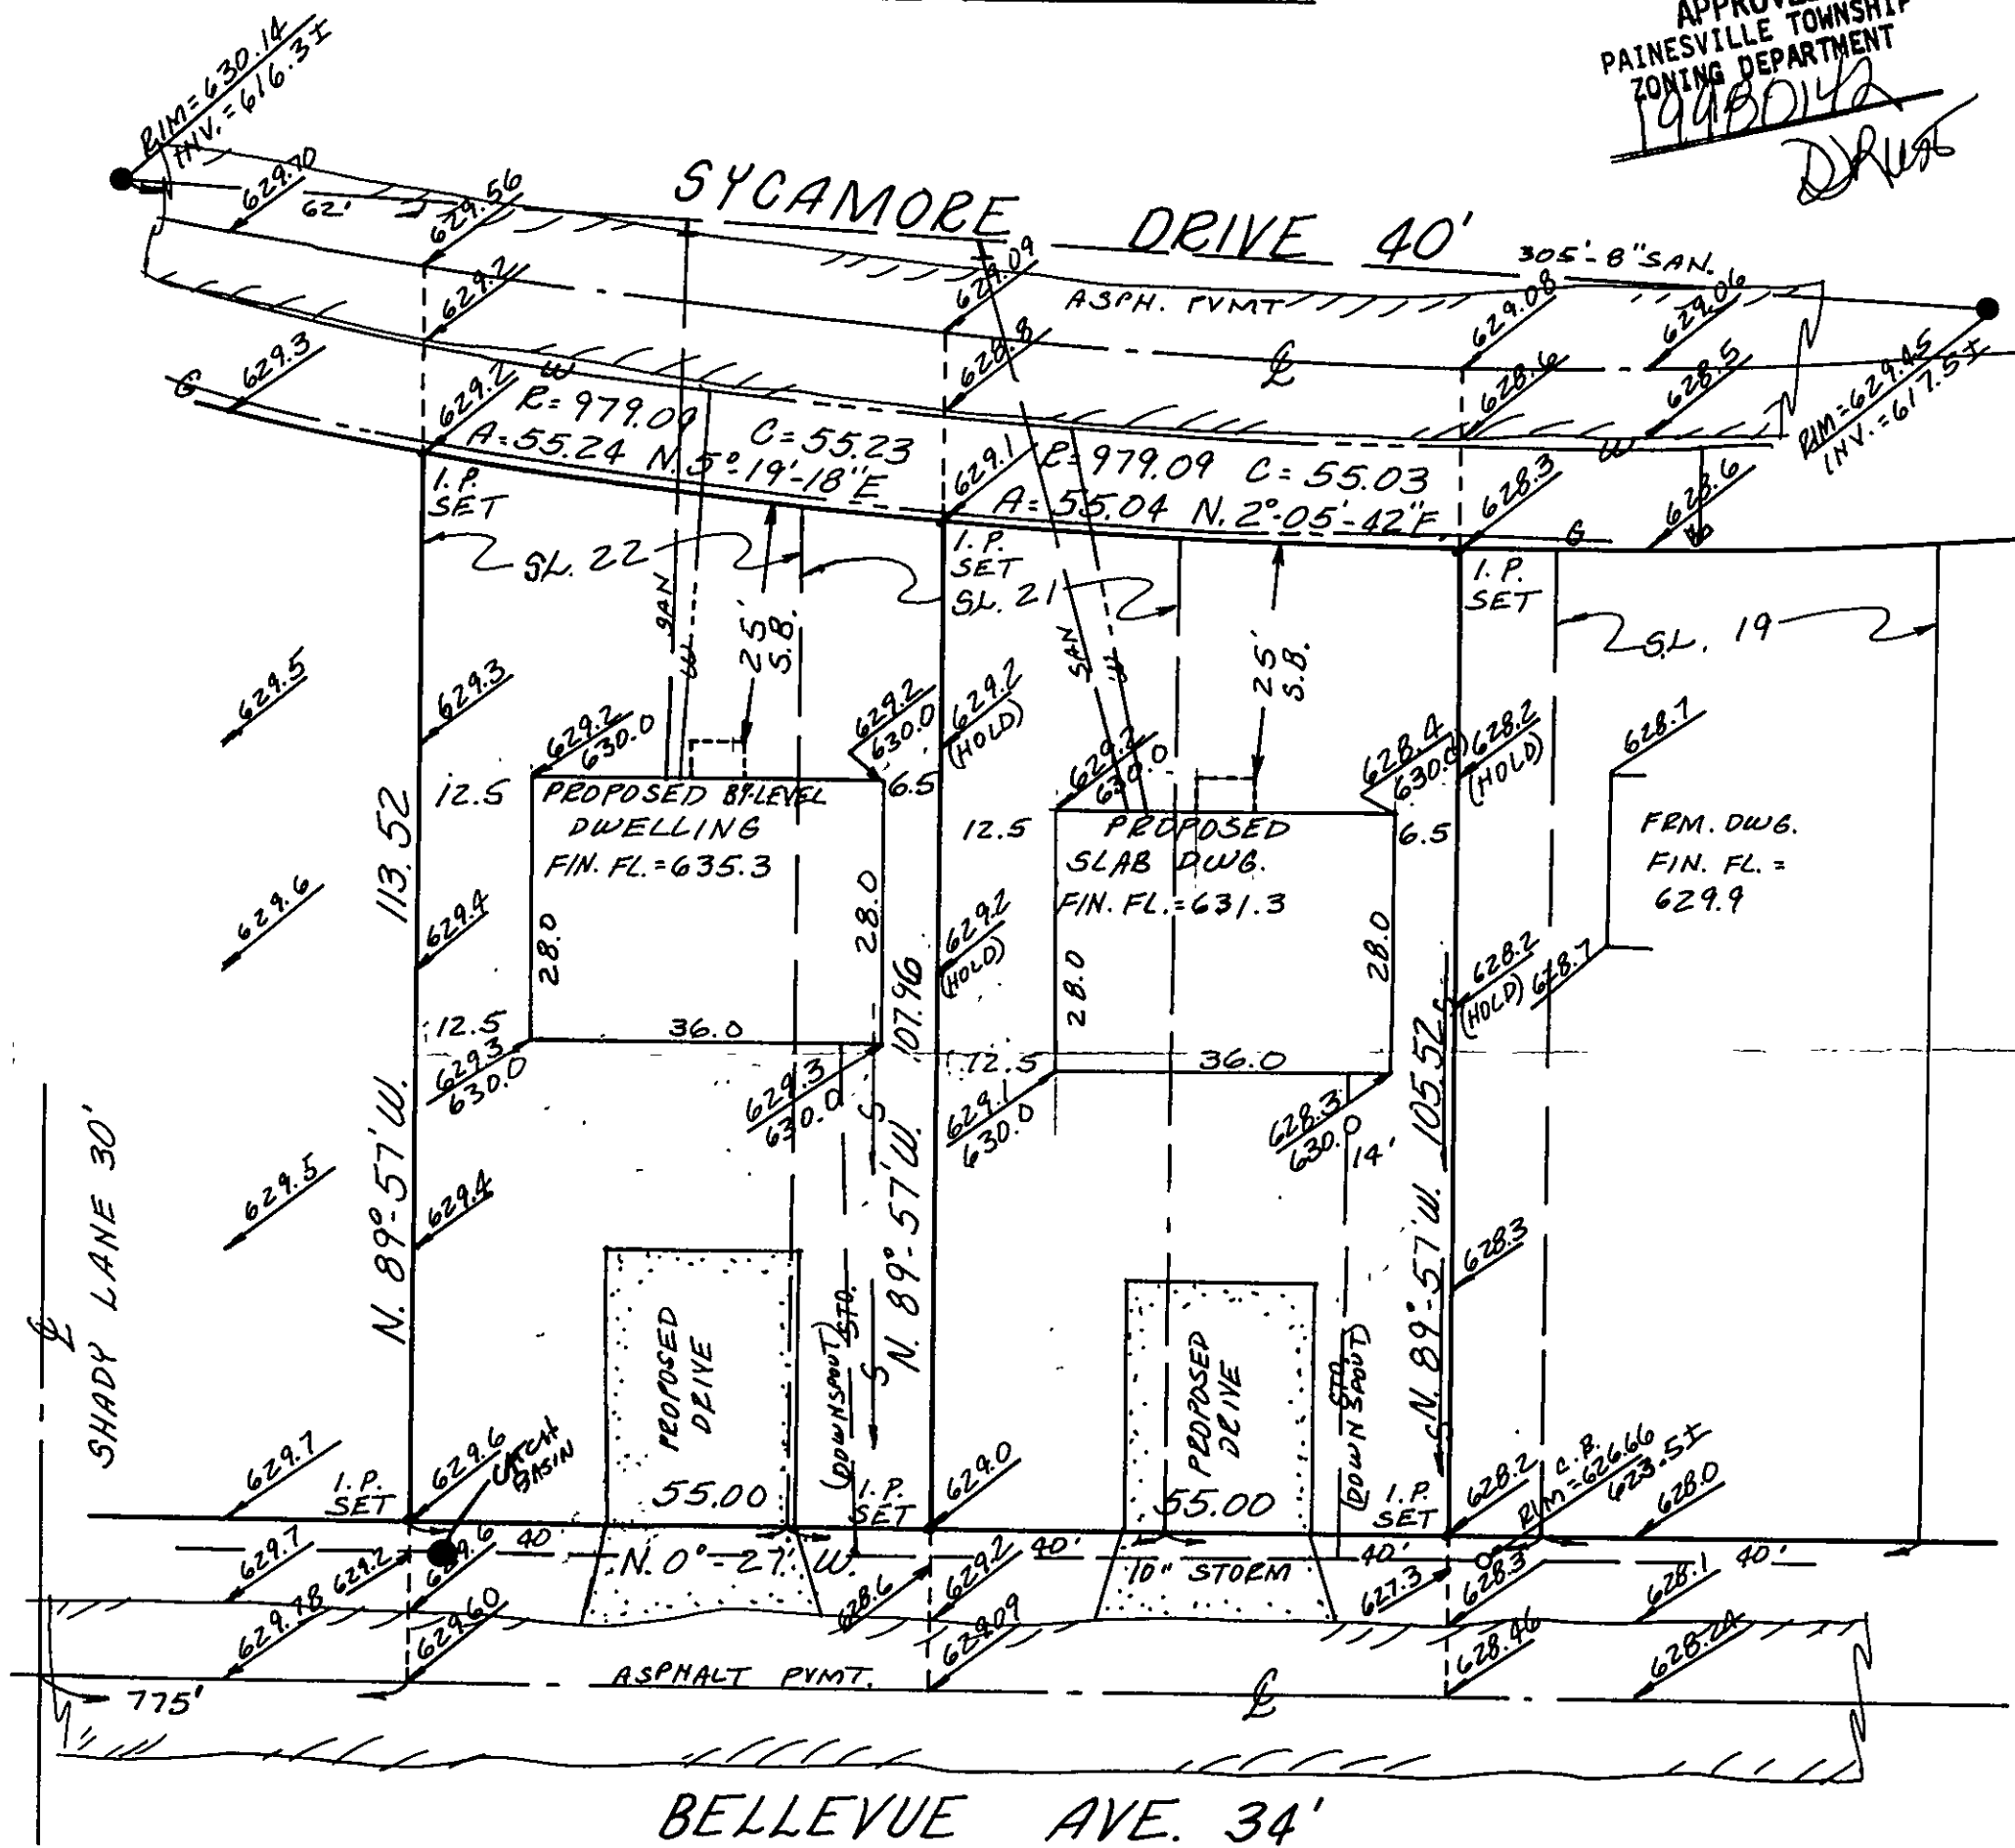


BENCH MARK  
TOP OF HYD.  
@ S.L. 19 SYCAMORE

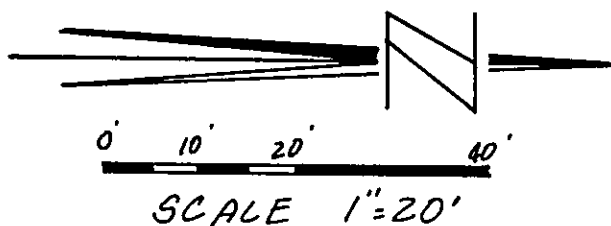

SEWER AND WATER  
CONNECTIONS TO BE  
VERIFIED AT TIME  
OF CONSTRUCTION.

BEARINGS SHOWN HEREON ARE TO AN ASSUMED MERIDIAN AND ARE USED TO DENOTE ANGLES ONLY. DISTANCES ARE GIVEN IN FEET AND DECIMAL PARTS THEREOF, ALL OF WHICH ARE CORRECT, TO THE BEST OF MY KNOWLEDGE AND BELIEF.

James A. Ziemba  
JAMES A. ZIEMBA P.S. #7094

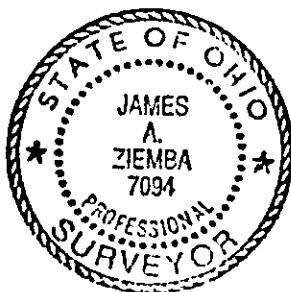

BENCHMARK SURVEY CO.

5964 S. RIDGE RD.  
MADISON, OHIO

428-8599  
5-1-98