


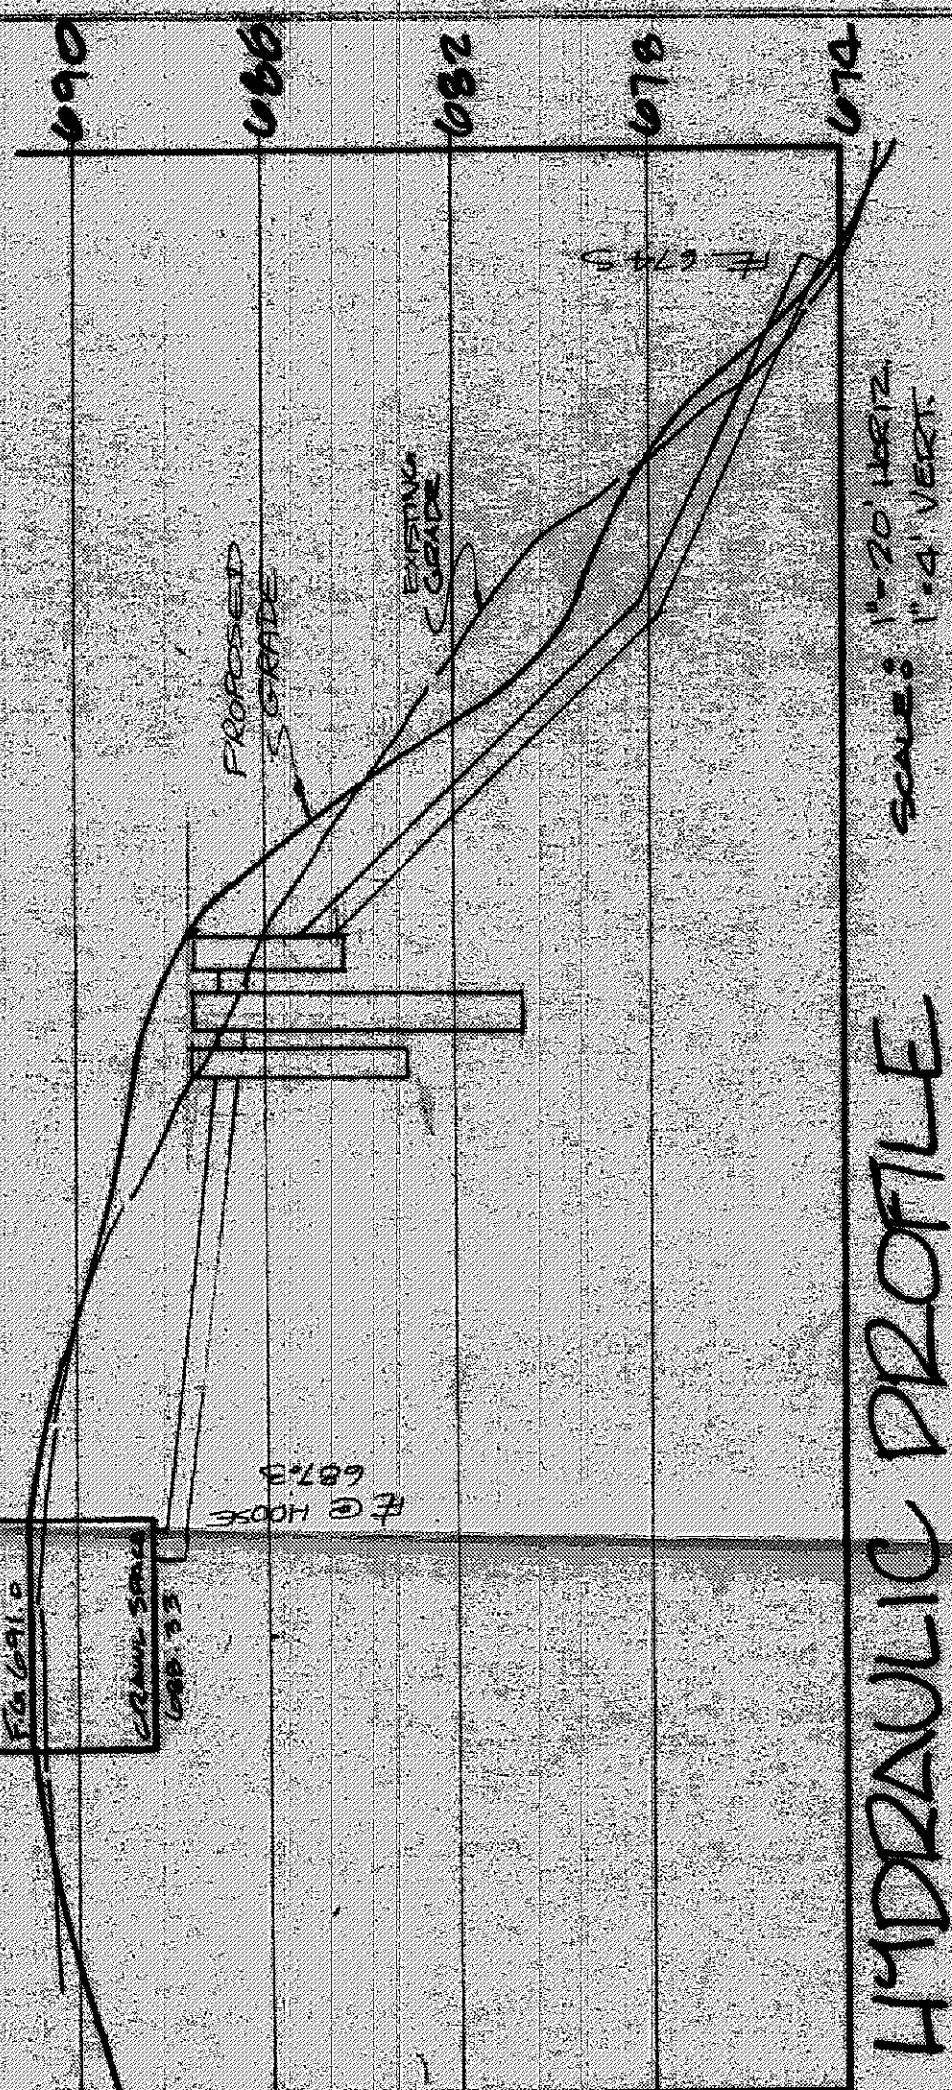

PAINESVILLE TOWNSHIP
ZONING O.K.
PENDING DRAINAGE
R. Haul
Zoning Inspector
8/28/18

Grading Plan Approved
as shown and/or noted
THOMAS P. GILLES, P.E.
Lake County Engineer
By *me* Date 8-24-18

SITE PLAN

for **TOM REED**
CLIENT OWNER
ADDRESS STREET CITY
21 REEDSTOCK
SUBLOT NO. SUBDIVISION NAME VOL. PAGE
PAINESVILLE TOWNSHIP OHIO
LOT, TRACT

REMARKS
ALL BOUNDARY DATA SHOWN WAS OBTAINED FROM (DEEDS, RECORDED SUBDIVISION PLAT OR OTHER PUBLIC RECORDS). LOCATIONS AS SHOWN OF ADJACENT WELLS AND SEPTIC TANKS OBTAINED FROM LAKE COUNTY HEALTH DEPARTMENT.



LEGEND
SANITARY MANHOLE — (M)
PROPOSED CONTOURS —
EXIST. ELEV. — 100.0
100.0 — PROP. ELEV.
WATER VALVE (GAS) — (W)
DIRECTION OF SURFACE DRAINAGE —

CHECK LIST
NO. OF BEDROOMS
DIMENSIONS
HEARINGS
TIE TO NEAREST STREET
SUBLOT NO., PARCEL NO.
SURROUNDING OWNERS
BLDG. DIMENSIONS-FIN. GR.
BLDG. TIES F.L.R. GRADES
APRON TYPE WIDTH THICKNESS
SIDEWALK TYPE WIDTH THICKNESS
CULVERT TYPE DIA. LENGTH
ROCK OUTCROPPINGS
WATER MAIN SIZE, LOCATION
SAN. SEWER SIZE & GR. LOC.
SAN. MH. CAST. ELEV. IN. ELEV.
SAN. CONN. SIZE, LOC. DEPTH
STORM SEWER SIZE & GR. LOC.
STORM MH. CAST. ELEV. INV. ELEV.
PAVT. TYPE GRADE CURBS
GAS LINE LOC. SIZE PRESSURE
SEPTIC TANK LOCATION & DUCTIFICATION AREA
WELL LOCATION
ISOLATION RADIUS FROM WELL

DESIGN CERTIFICATION
THIS PLAN WAS PREPARED BY ME, AND IS CORRECT TO THE BEST OF MY KNOWLEDGE AND BELIEF.
R. Haul
NAME SURVEYOR REGISTRATION NO. **PS5044**

"AS BUILT" CERTIFICATION
I HEREBY CERTIFY THAT THE CIRCLED GRADES ARE EXISTING GRADES OBTAINED ON THE SITE ON 19____ AND ARE CORRECT TO THE BEST OF MY ACKNOWLEDGMENT AND BELIEF.

1	DRAWN BY <i>RJR</i>	SCALE 1"=20'	DRAWING NO.
2	CHKD BY <i>JB</i>	DATE 8/28/18	250-21
3	CREATED BY	APP'D.	

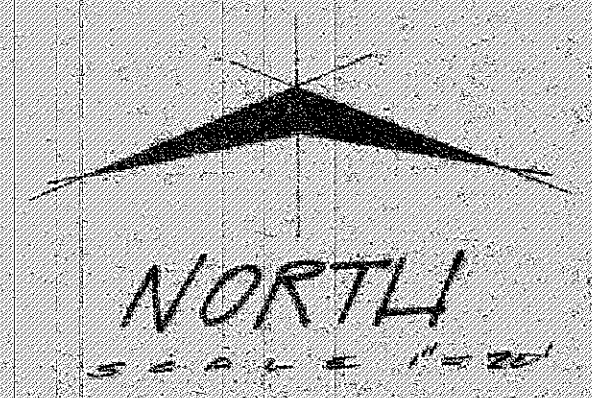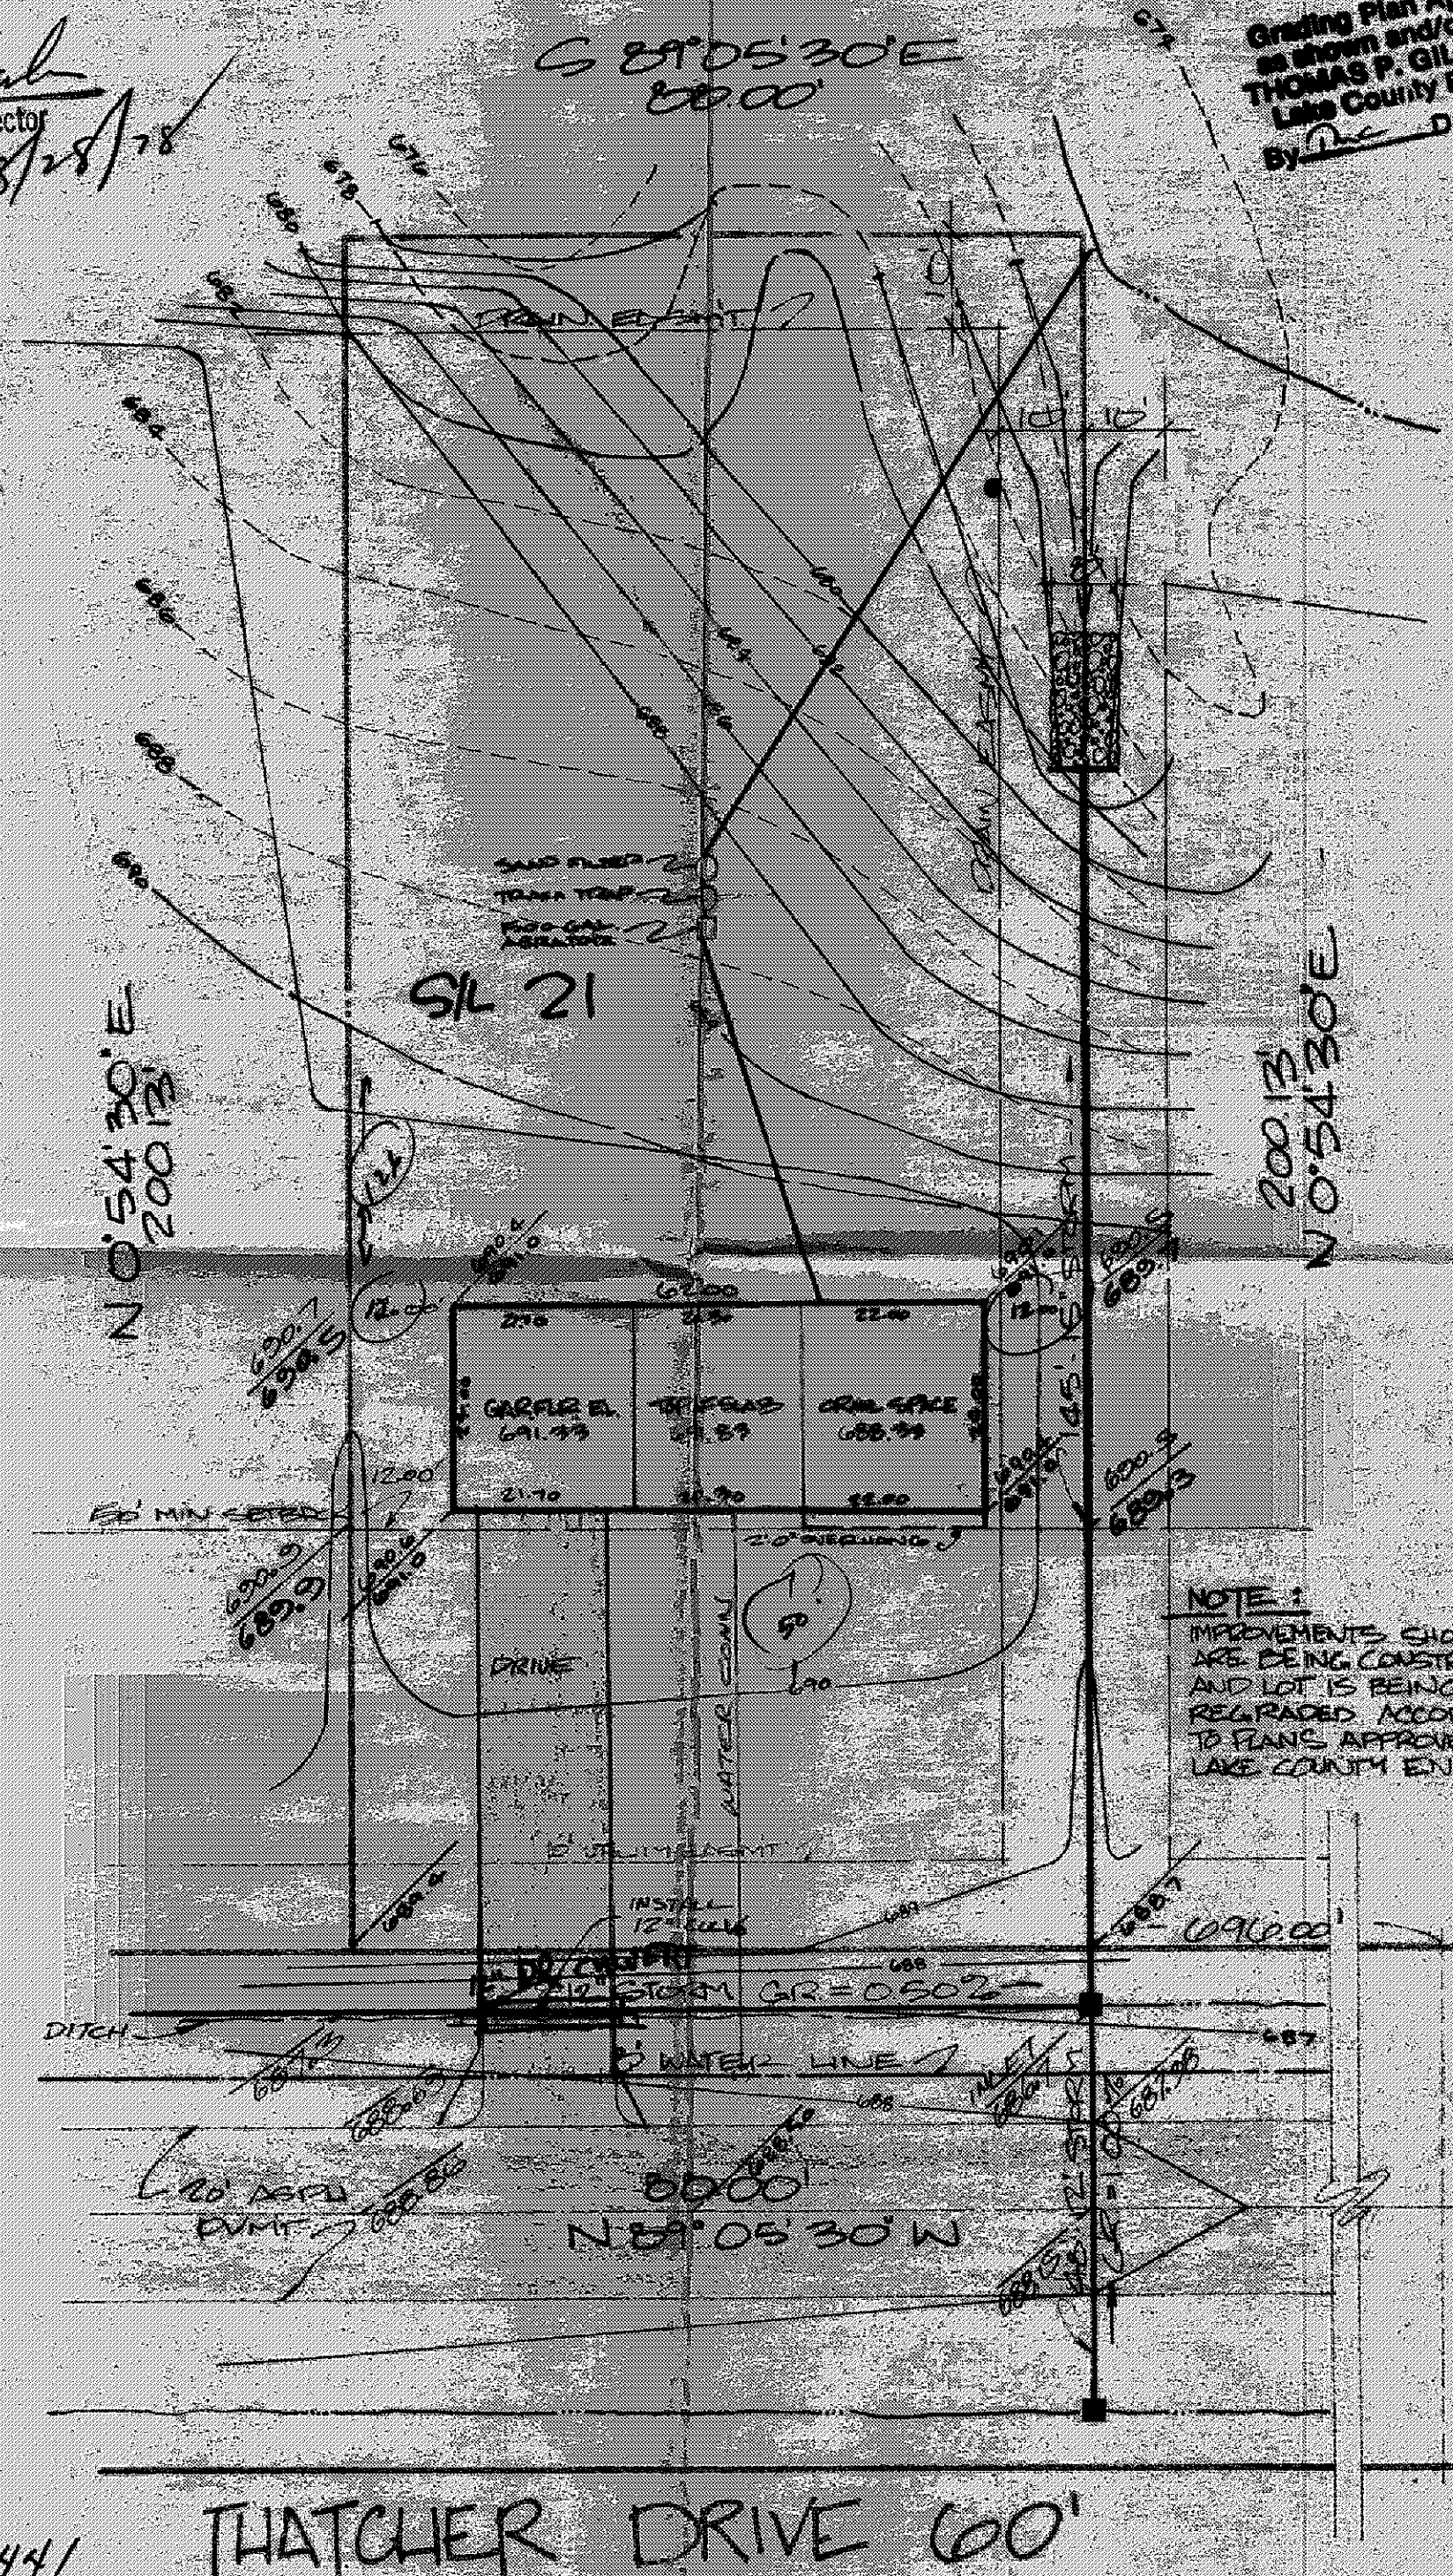

1441 THATCHER DRIVE 60'

PARK ROAD