



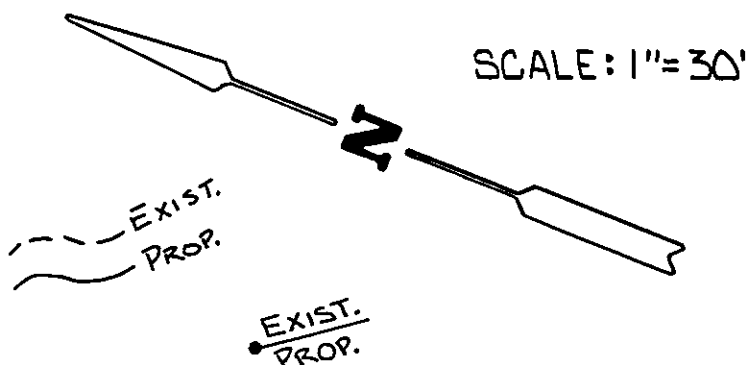

APPROVED
PAINESVILLE TOWNSHIP
ZONING DEPARTMENT
2000-03-26


SITE PLAN

FOR
WAYNE HAWKINS
BEING KNOWN AS S/L 3 IN THE MORLEY ALLOTMENT
SUBDIVISION IN LOT 1, GOODRICH SURVEY, TRACT 4,
PAINESVILLE TOWNSHIP, LAKE COUNTY, OHIO.
1840 JACKSON ST

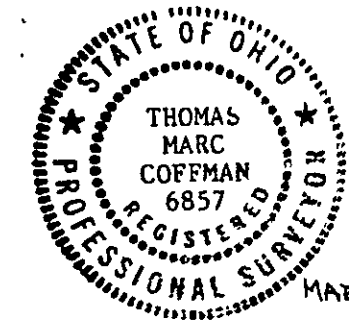

I, the undersigned hereby certify that
this topography, indicated by 1' contours
and elevations shown hereon represent an
actual field survey made by me on MARCH 17, 2000
and that the elevations were taken at
appropriate intervals and that as of that
date they existed as indicated hereon.

Thomas Marc Coffman P.S.
No 6857

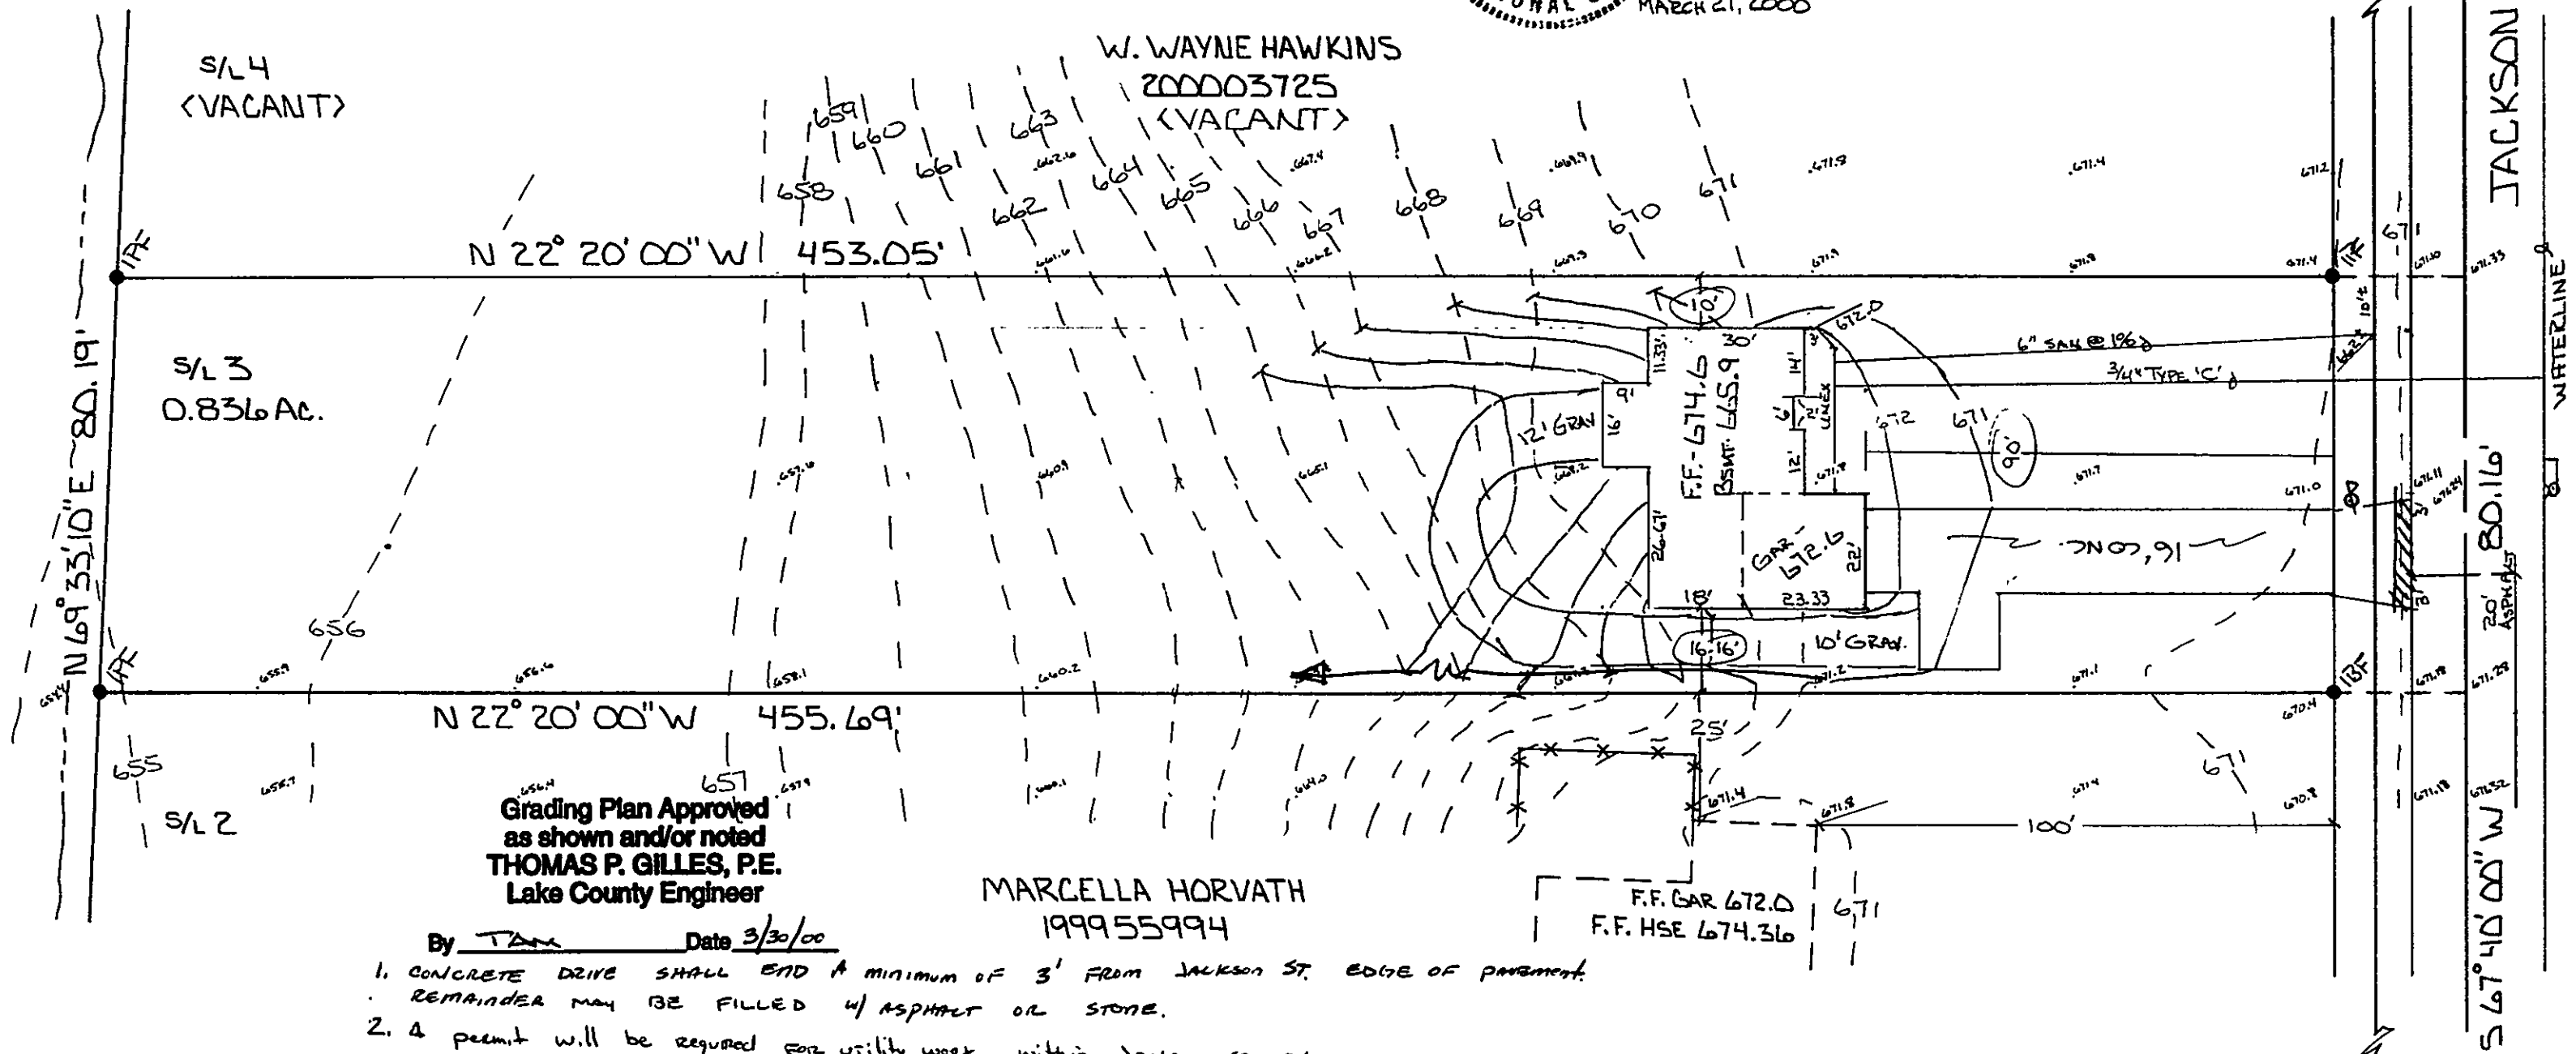

Grading Plan Approved
as shown and/or noted
THOMAS P. GILLES, P.E.
Lake County Engineer

MARCELLA HORVATH
199955994

- By TAM Date 3/30/00
1. CONCRETE DRIVE SHALL END A MINIMUM OF 3' FROM JACKSON ST. EDGE OF PAVEMENT.
REMAINDER MAY BE FILLED W/ ASPHALT OR STONE.
 2. A permit will be required for utility work within Jackson St. R/W.
 3. Swale as shown