



EXISTING BUILDING
(PART TO BE RELOCATED TO SITE)

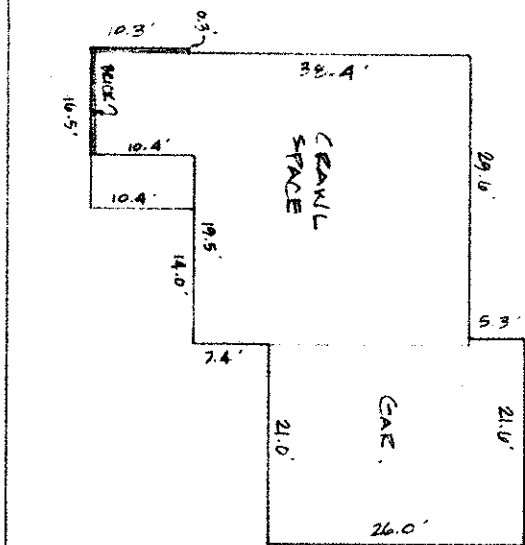

S/L 0

NOTE: PROPOSED & EXIST. FOUNDATION
DIMENSIONS SHOWN. BEFORE ANY
HOUSE STARTING.

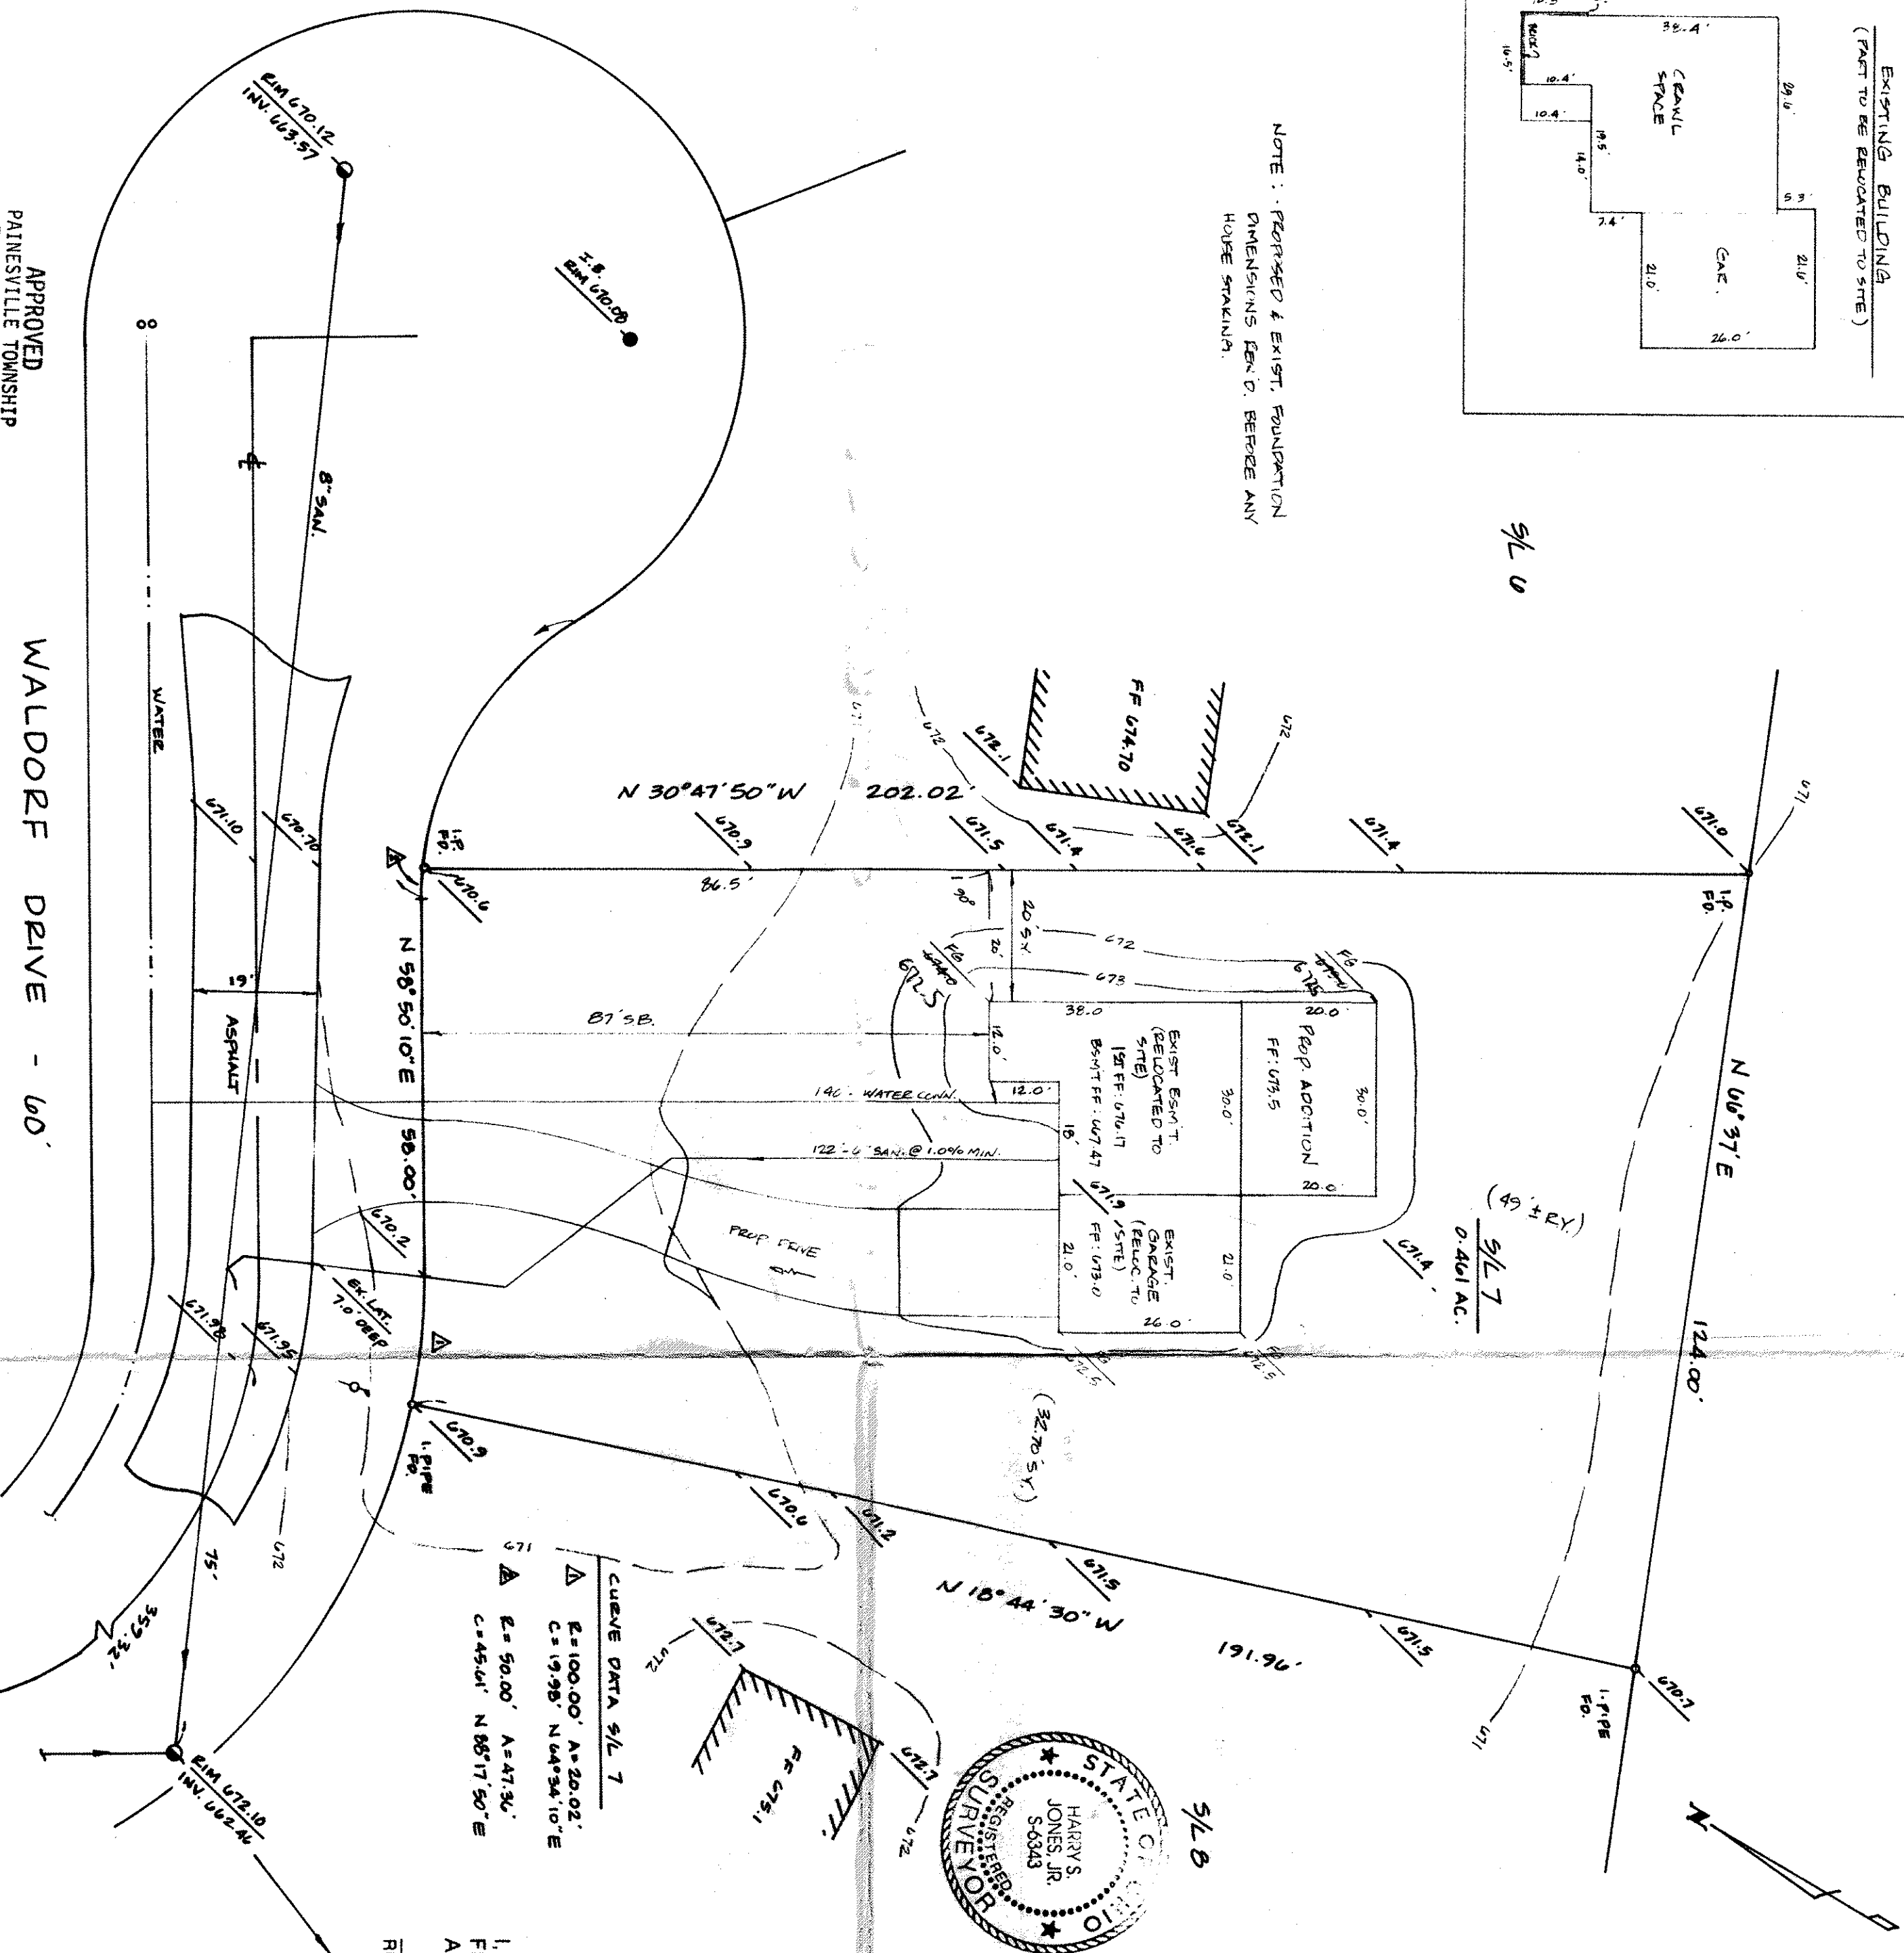

APPROVED
PAINESVILLE TOWNSHIP
ZONING DEPARTMENT
#95-0311
3/14/95

WALDORF DRIVE - 60'

JACKSON ST.

SITE PLAN

PAINESVILLE TWP., LAKE COUNTY, OHIO

for: DENNIS FALVEY

CLIENT OWNER

ADDRESS STREET CITY ZIP

WALDORF SUBDIVISION

SUBDIVISION L-2 NAME

VOL. PG. NAME

SUBLOT NO. WALDORF DRIVE STREET

LOT TRACT

VOLUME PLAT - 8 PAGE

PERMIT NO. STREET

LEGEND

SANITARY MANHOLE

STORM MANHOLE

INLET OR CATCH BASIN

HYDRANT

EXISTING CONTOURS

PROPOSED CONTOURS

EXIST. ELEV. 100.0' PROP. ELEV. 100.0'

REMARKS

ALL BOUNDARY DATA SHOWN WAS OBTAINED FROM (DEEDS, RECORDED
SUBDIVISION PLAT OR OTHER PUBLIC RECORDS)

LOCATIONS AS SHOWN OF ADJACENT WELLS AND SEPTIC TANKS OBTAINED FROM
LAKE COUNTY HEALTH DEPARTMENT

DESIGN CERTIFICATION

THIS PLAT WAS PREPARED BY ME, AND IS CORRECT
TO THE BEST OF MY KNOWLEDGE AND BELIEF.

NAME SURVEYOR REGISTRATION NO.

CHECK LIST

NO. OF BEDROOMS
DIMENSIONS
TIE TO NEAREST STREET
SUBLOT NO. PARCEL NO.
SURROUNDING OWNERS
BLDG. DIMENSIONS FIN. GR.
BLDG. TIE ELEV. GRADES
APPROX. TYPE WIDTH THICKNESS
SIDEWALK TYPE DIM. LENGTH
ROCK OUTCROPPINGS

PLAN PREPARED BY:

BABCOCK & JONES & ASSOCIATES, INC.

PAINESVILLE, OHIO

NO.	DATE	BY	SCALE	1" = 20'	PHONE NO.
1	3/8/95	147			357-1811
2	3/9/95				
3					
4					
5					

"AS BUILT" CERTIFICATION

I, HEREBY CERTIFY THAT THE CIRCLED GRADES ARE EXISTING
FINISH GRADES CHECKED IN THE FIELD ON 19
AND ARE CORRECT TO THE BEST OF MY KNOWLEDGE AND BELIEF.

REGISTERED SURVEYOR REG. NO.

BENCHMARK: BM SAN. MH @ CUL. DE. SAC

WALDORF DR., ELEV. = 670.12

Grading Plan Approved
as shown and/or noted
THOMAS P. GILLES, P.E.
Lake County Engineer

By: GJH Date: 3/16/95

Lower East Pg to 672.5