


SITE IMPROVEMENT PLAN - AS BUILT

FOR SUBLOT NUMBER 51 IN NORTH SHORE ESTATES AT LAKE ERIE SHORES OF PART OF LOT 4, TRACT 2 AND LOT 27, TRACT 1, AS SHOWN BY THE RECORDED PLAT IN VOLUME 50, PAGE 5 OF LAKE COUNTY MAP RECORDS. NOW IN THE TOWNSHIP OF PAINESVILLE, COUNTY OF LAKE, AND STATE OF OHIO.


FOR: MILLSTONE BUILDING COMPANY

1879 EAST AURORA ROAD
TWINSBURG, OHIO 44087
PHONE: 330-487-0911

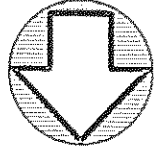

NORTH

SCALE: 1" = 20'
JANUARY 22, 2007

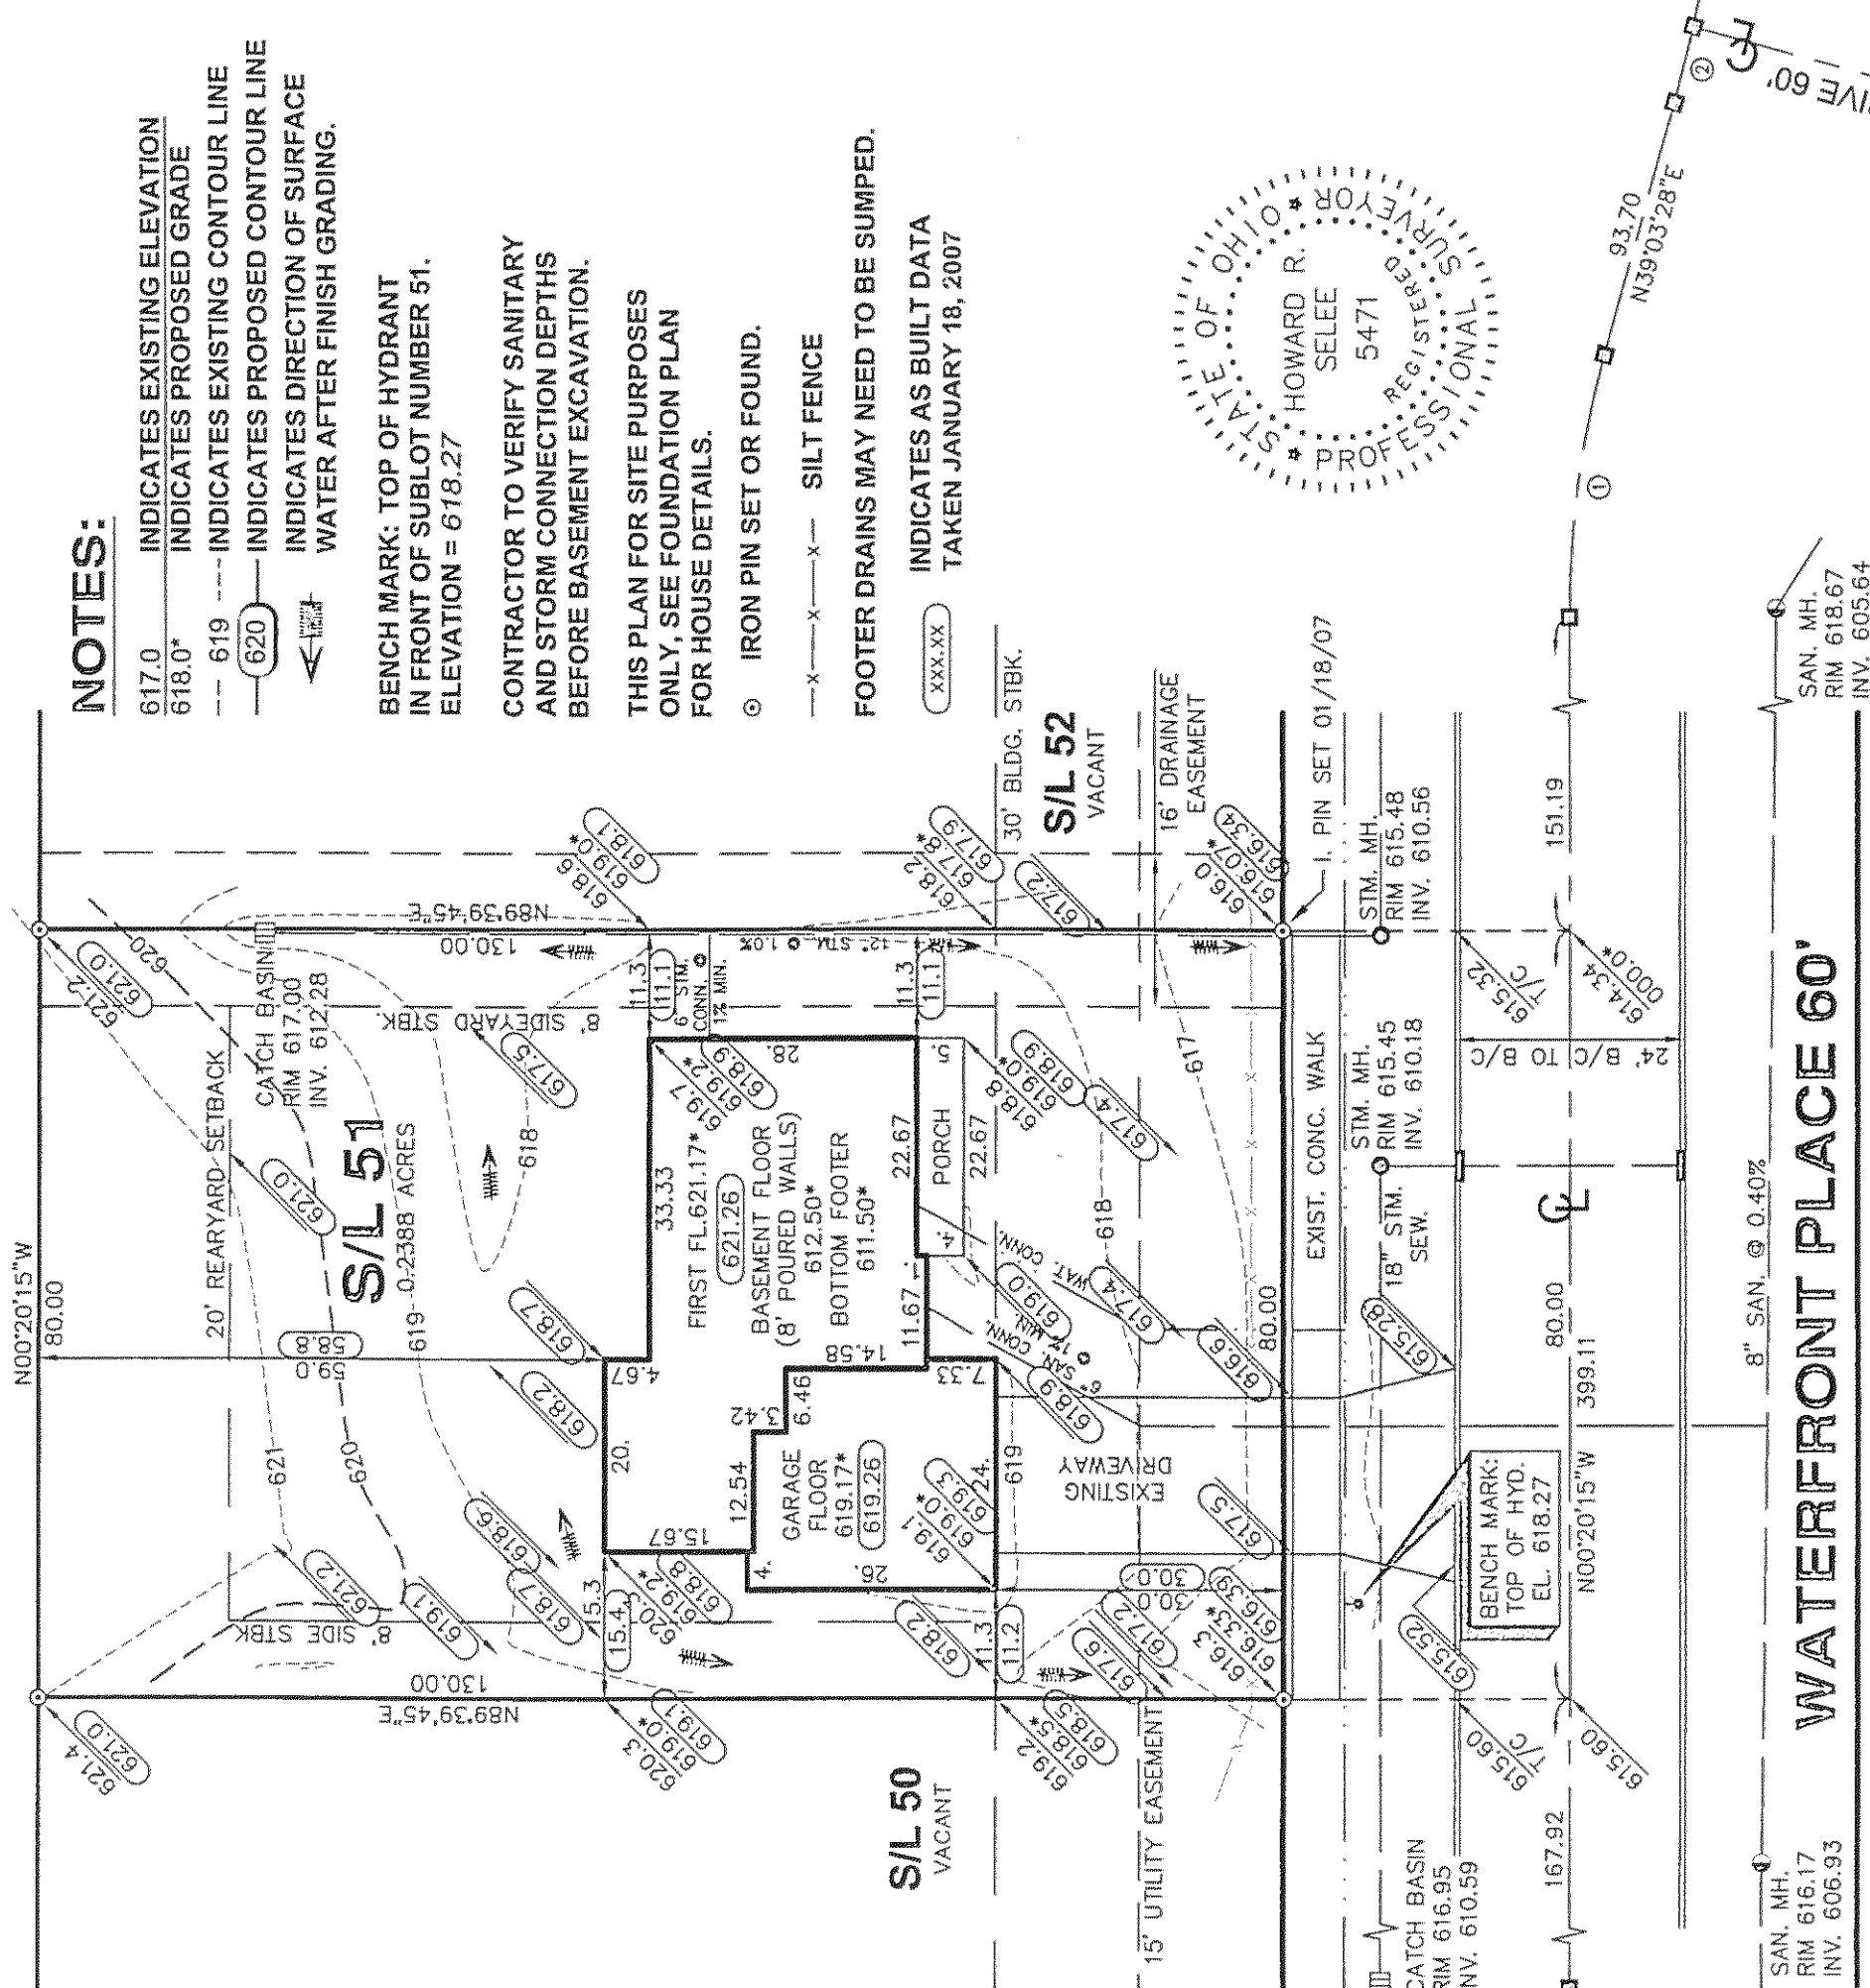

- ① R = 100.00
A = 39°23'48"
A = 68.76
C = 67.41
N19°12'34"E
- ② R = 150.00
A = 03°08'51"
A = 8.24
C = 8.24
N37°29'02"E

DIMENSIONS SHOWN ARE HEREON EXPRESSED IN FEET AND DECIMAL PARTS THEREOF. MONUMENTS WERE FOUND OR SET AS INDICATED HEREON. BEARINGS SHOWN ARE TO AN ASSUMED MERIDIAN AND ARE FOR THE SOLE PURPOSE OF DESCRIBING THE RELATIVE ANGULAR VALUE BETWEEN LINES, ALL OF WHICH I CERTIFY TO BE CORRECT TO THE BEST OF MY KNOWLEDGE AND BELIEF.

Howard R. Selee
HOWARD R. SELEE, REG. SURVEYOR #5471
DATE: Jan. 22 2007

HOWARD R. SELEE & ASSOCIATES, INC.
PROFESSIONAL LAND SURVEYORS
9701 BROOKPARK ROAD * SUITE 231 * CLEVELAND, OH 44129
(216) 398-0280
SCALE: 1" = 20' FILE NO. 05041-51-ab

"AS-BUILT"