
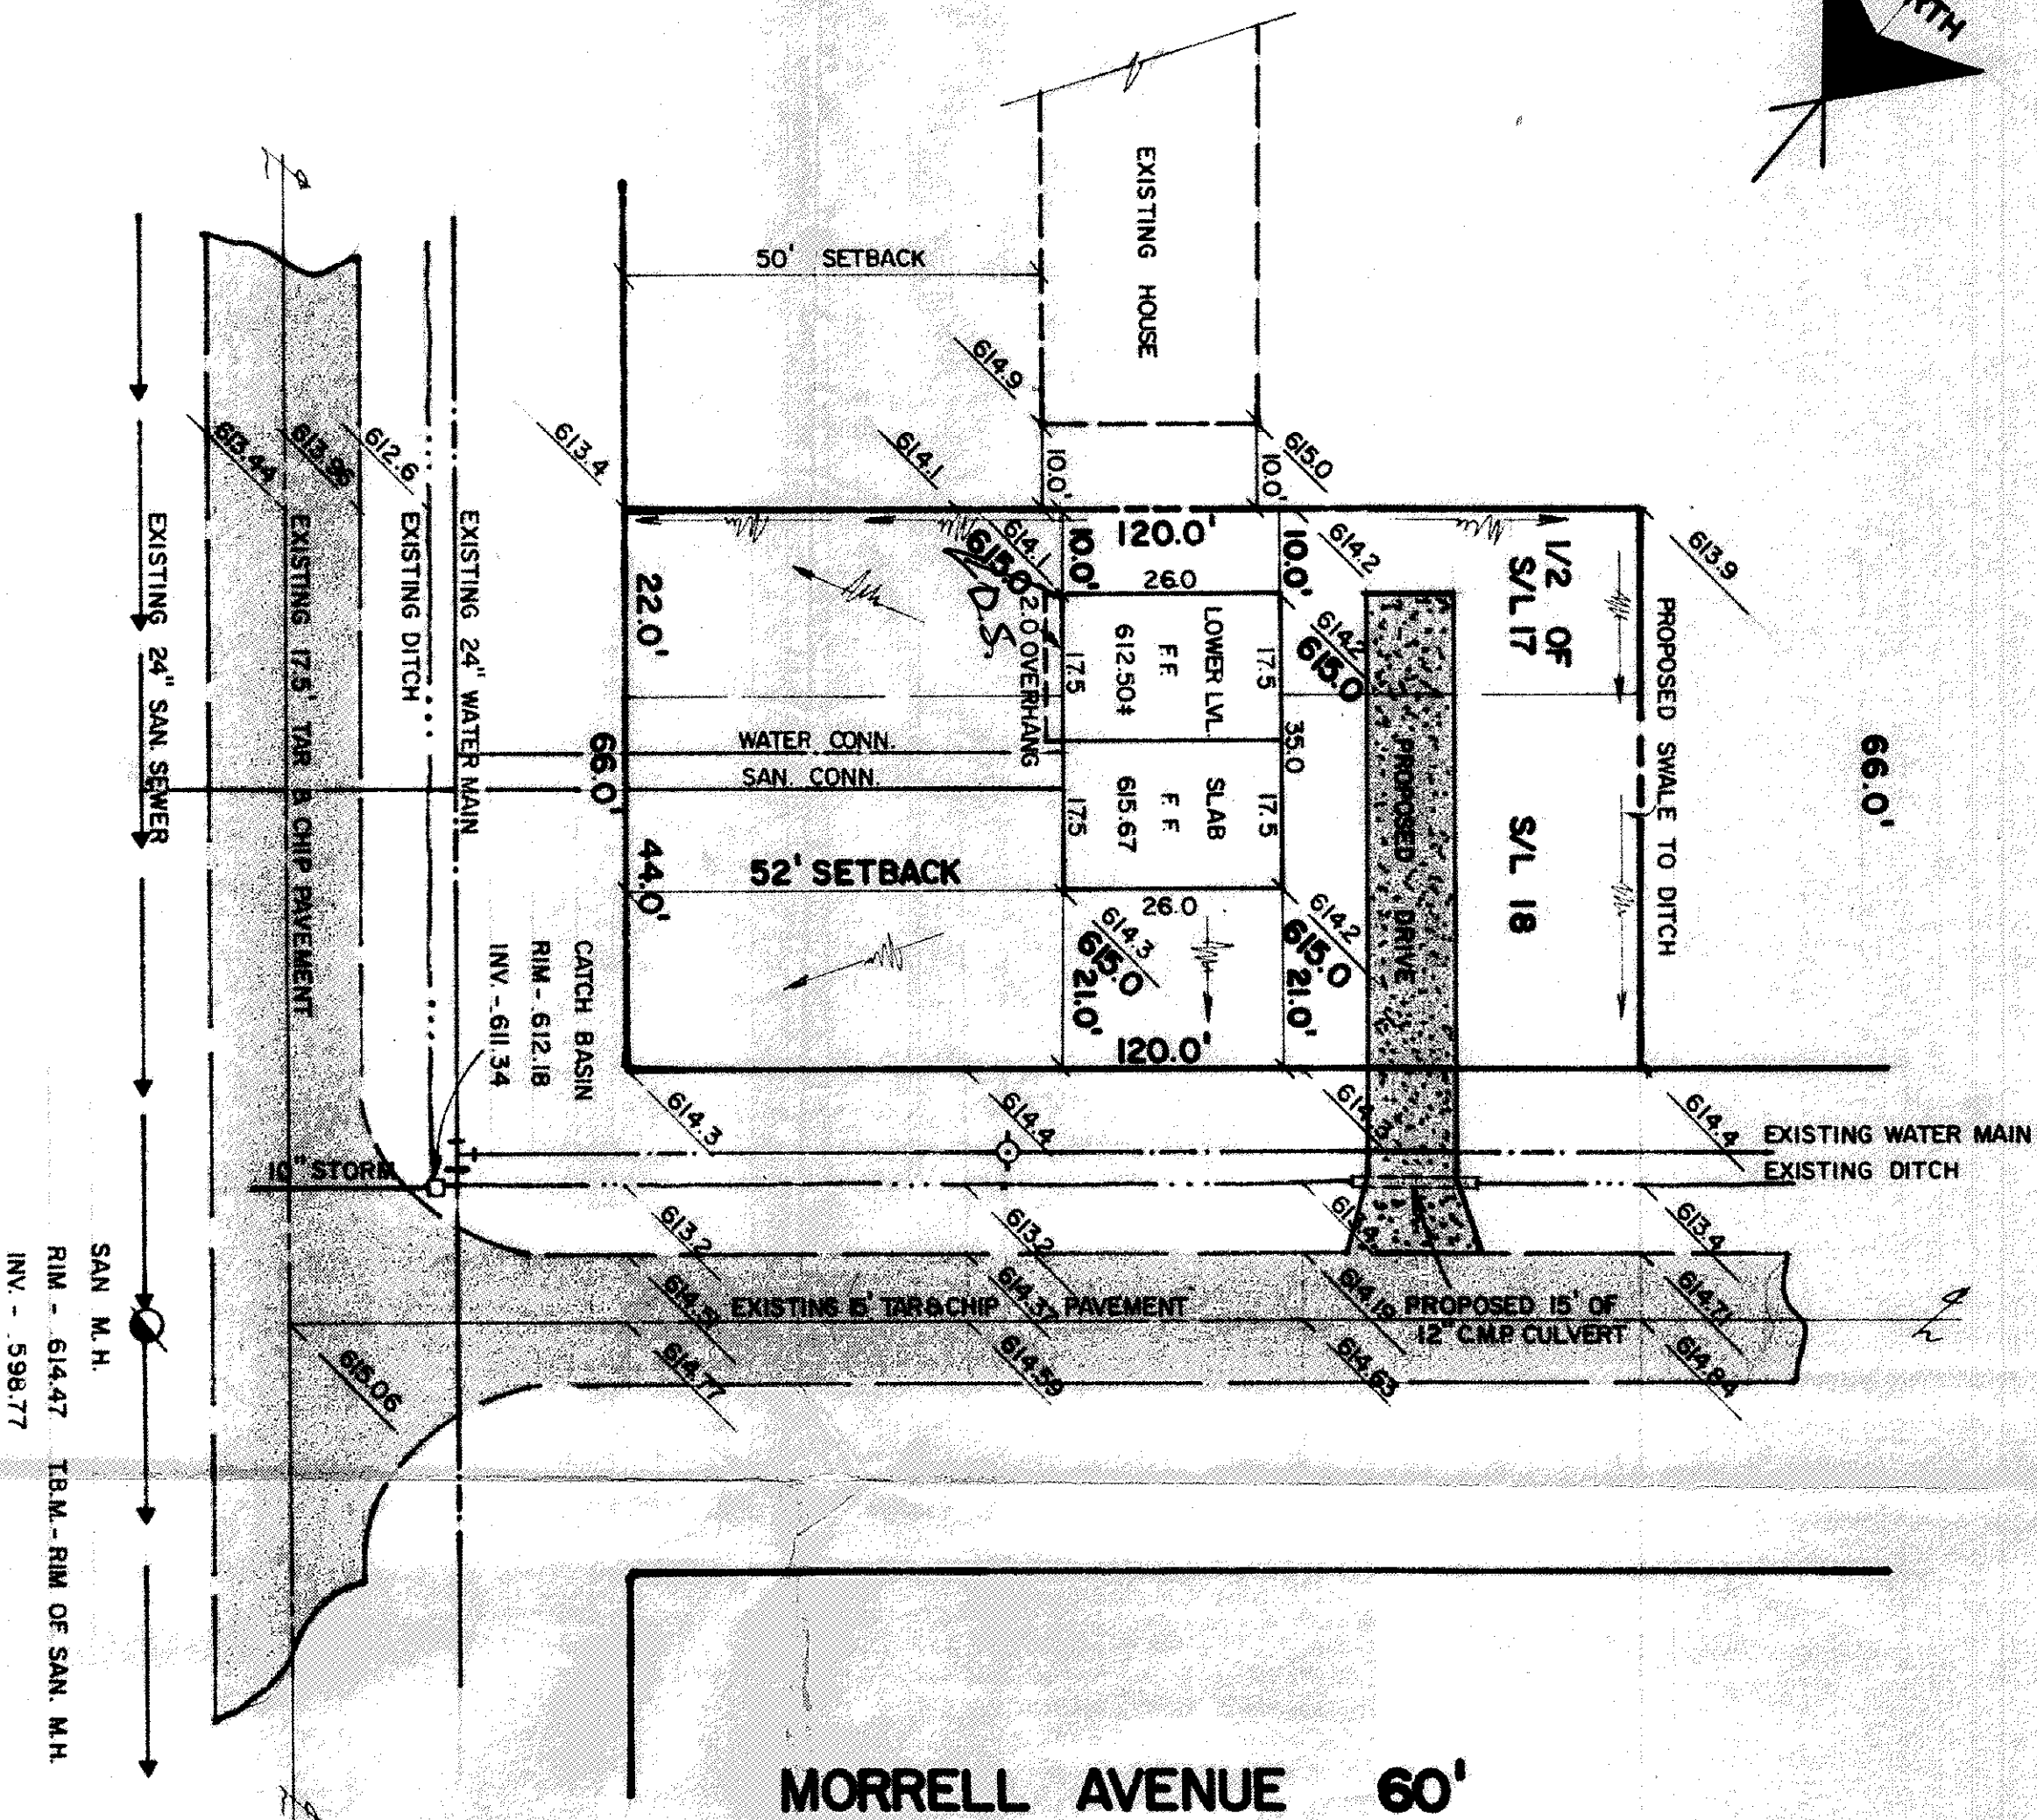


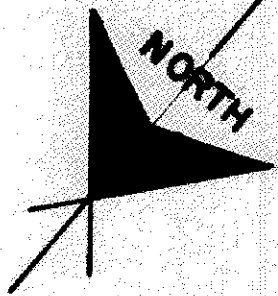

MEIGS AVENUE 80'

MORRELL AVENUE 60'

Grading Plan Approved  
as shown and/or noted  
THOMAS P. GILLES, P.E.  
Lake County Engineer  
Date 11-1-83

# SITE PLAN

PAINESVILLE LAKE COUNTY, OHIO

for: WAYNE HAWKINS

P.O. BOX 164 MENTOR, O. 44060

ADDRESS CITY

G.E. MEIGS RE - SURVEY  
SUBDIVISION A-37  
VOL. 17 B. 18 MEIGS AVENUE  
SHEET NO. 1

LOT TRACT  
VOLUME PAGE  
PERM. PARCEL NO. STREET

## LEGEND

SANITARY MANHOLE  
STORM MANHOLE  
INLET OR CATCH BASIN  
HYDRANT  
EXISTING CONTOURS  
PROPOSED CONTOURS  
EXIST. ELEV. 100.0  
PROP. ELEV. 100.0

WATER VALVE (GAS)  
WATER METER (GAS)  
AS BUILT ELEVATION  
INDICATES  
DIRECTION OF  
SURFACE DRAINAGE

## REMARKS

ALL BOUNDARY DATA SHOWN WAS OBTAINED FROM IDEEDS, RECORDED  
SUBDIVISION PLAT OR OTHER PUBLIC RECORDS  
LOCATIONS AS SHOWN OF ADJACENT WELLS AND SEPTIC TANKS OBTAINED FROM  
LAKE COUNTY HEALTH DEPARTMENT

## DESIGN CERTIFICATION

THIS PLAT WAS PREPARED BY ME, AND IS CORRECT  
TO THE BEST OF MY KNOWLEDGE AND BELIEF.

NAME SURVEYOR REGISTRATION NO. 4514

## CHECK LIST

NO. OF BEDROOMS  
DIMENSIONS  
SAN. SEWER SIZE & GR. LOC.  
SAN. MH. CAST. ELEV. INV. ELEV.  
SAN. CONN. SIZE, LOC. DEPTH  
STORM SEWER SIZE & GR. LOC.  
STORM MH. CAST. ELEV. INV. ELEV.  
PAV'T TYPE GRADE CURBS  
SEPTIC TANK LOCATION & DUPLICATION AREA  
WELL LOCATION  
ISOLATION RADIUS FROM WELL  
ROCK OUTCROPPINGS

## PLAN PREPARED BY:

DEBEVEC • SALO & ASSOCIATES, INC.

125 E. ERIE ST. PAINESVILLE, OHIO

| NO. | DATE | BY |
|-----|------|----|
| 1   |      |    |
| 2   |      |    |
| 3   |      |    |
| 4   |      |    |
| 5   |      |    |

|                             |                   |                       |
|-----------------------------|-------------------|-----------------------|
| DRAWN BY<br>L. L.           | SCALE<br>1" = 20' | PHONE NO.<br>352-9250 |
| CHECKED BY<br>OCT. 18, 1992 | DRAWING NO.       |                       |
| CREW<br>CHIEF               | APP'D.            | 5743                  |

## "AS BUILT" CERTIFICATION

I, HEREBY CERTIFY THAT THE CIRCLED GRADES ARE EXISTING  
FINISH GRADES CHECKED IN THE FIELD ON 19  
AND ARE CORRECT TO THE BEST OF MY KNOWLEDGE AND BELIEF.

REGISTERED SURVEYOR

REG. NO.

This Permit Expires

OCT 22 1983

PAINESVILLE TOWNSHIP

ZONING APPROVED

# 5629

12 M. H. H. H.

Zoning Inspector 10/22/83

OCT 20 1982