


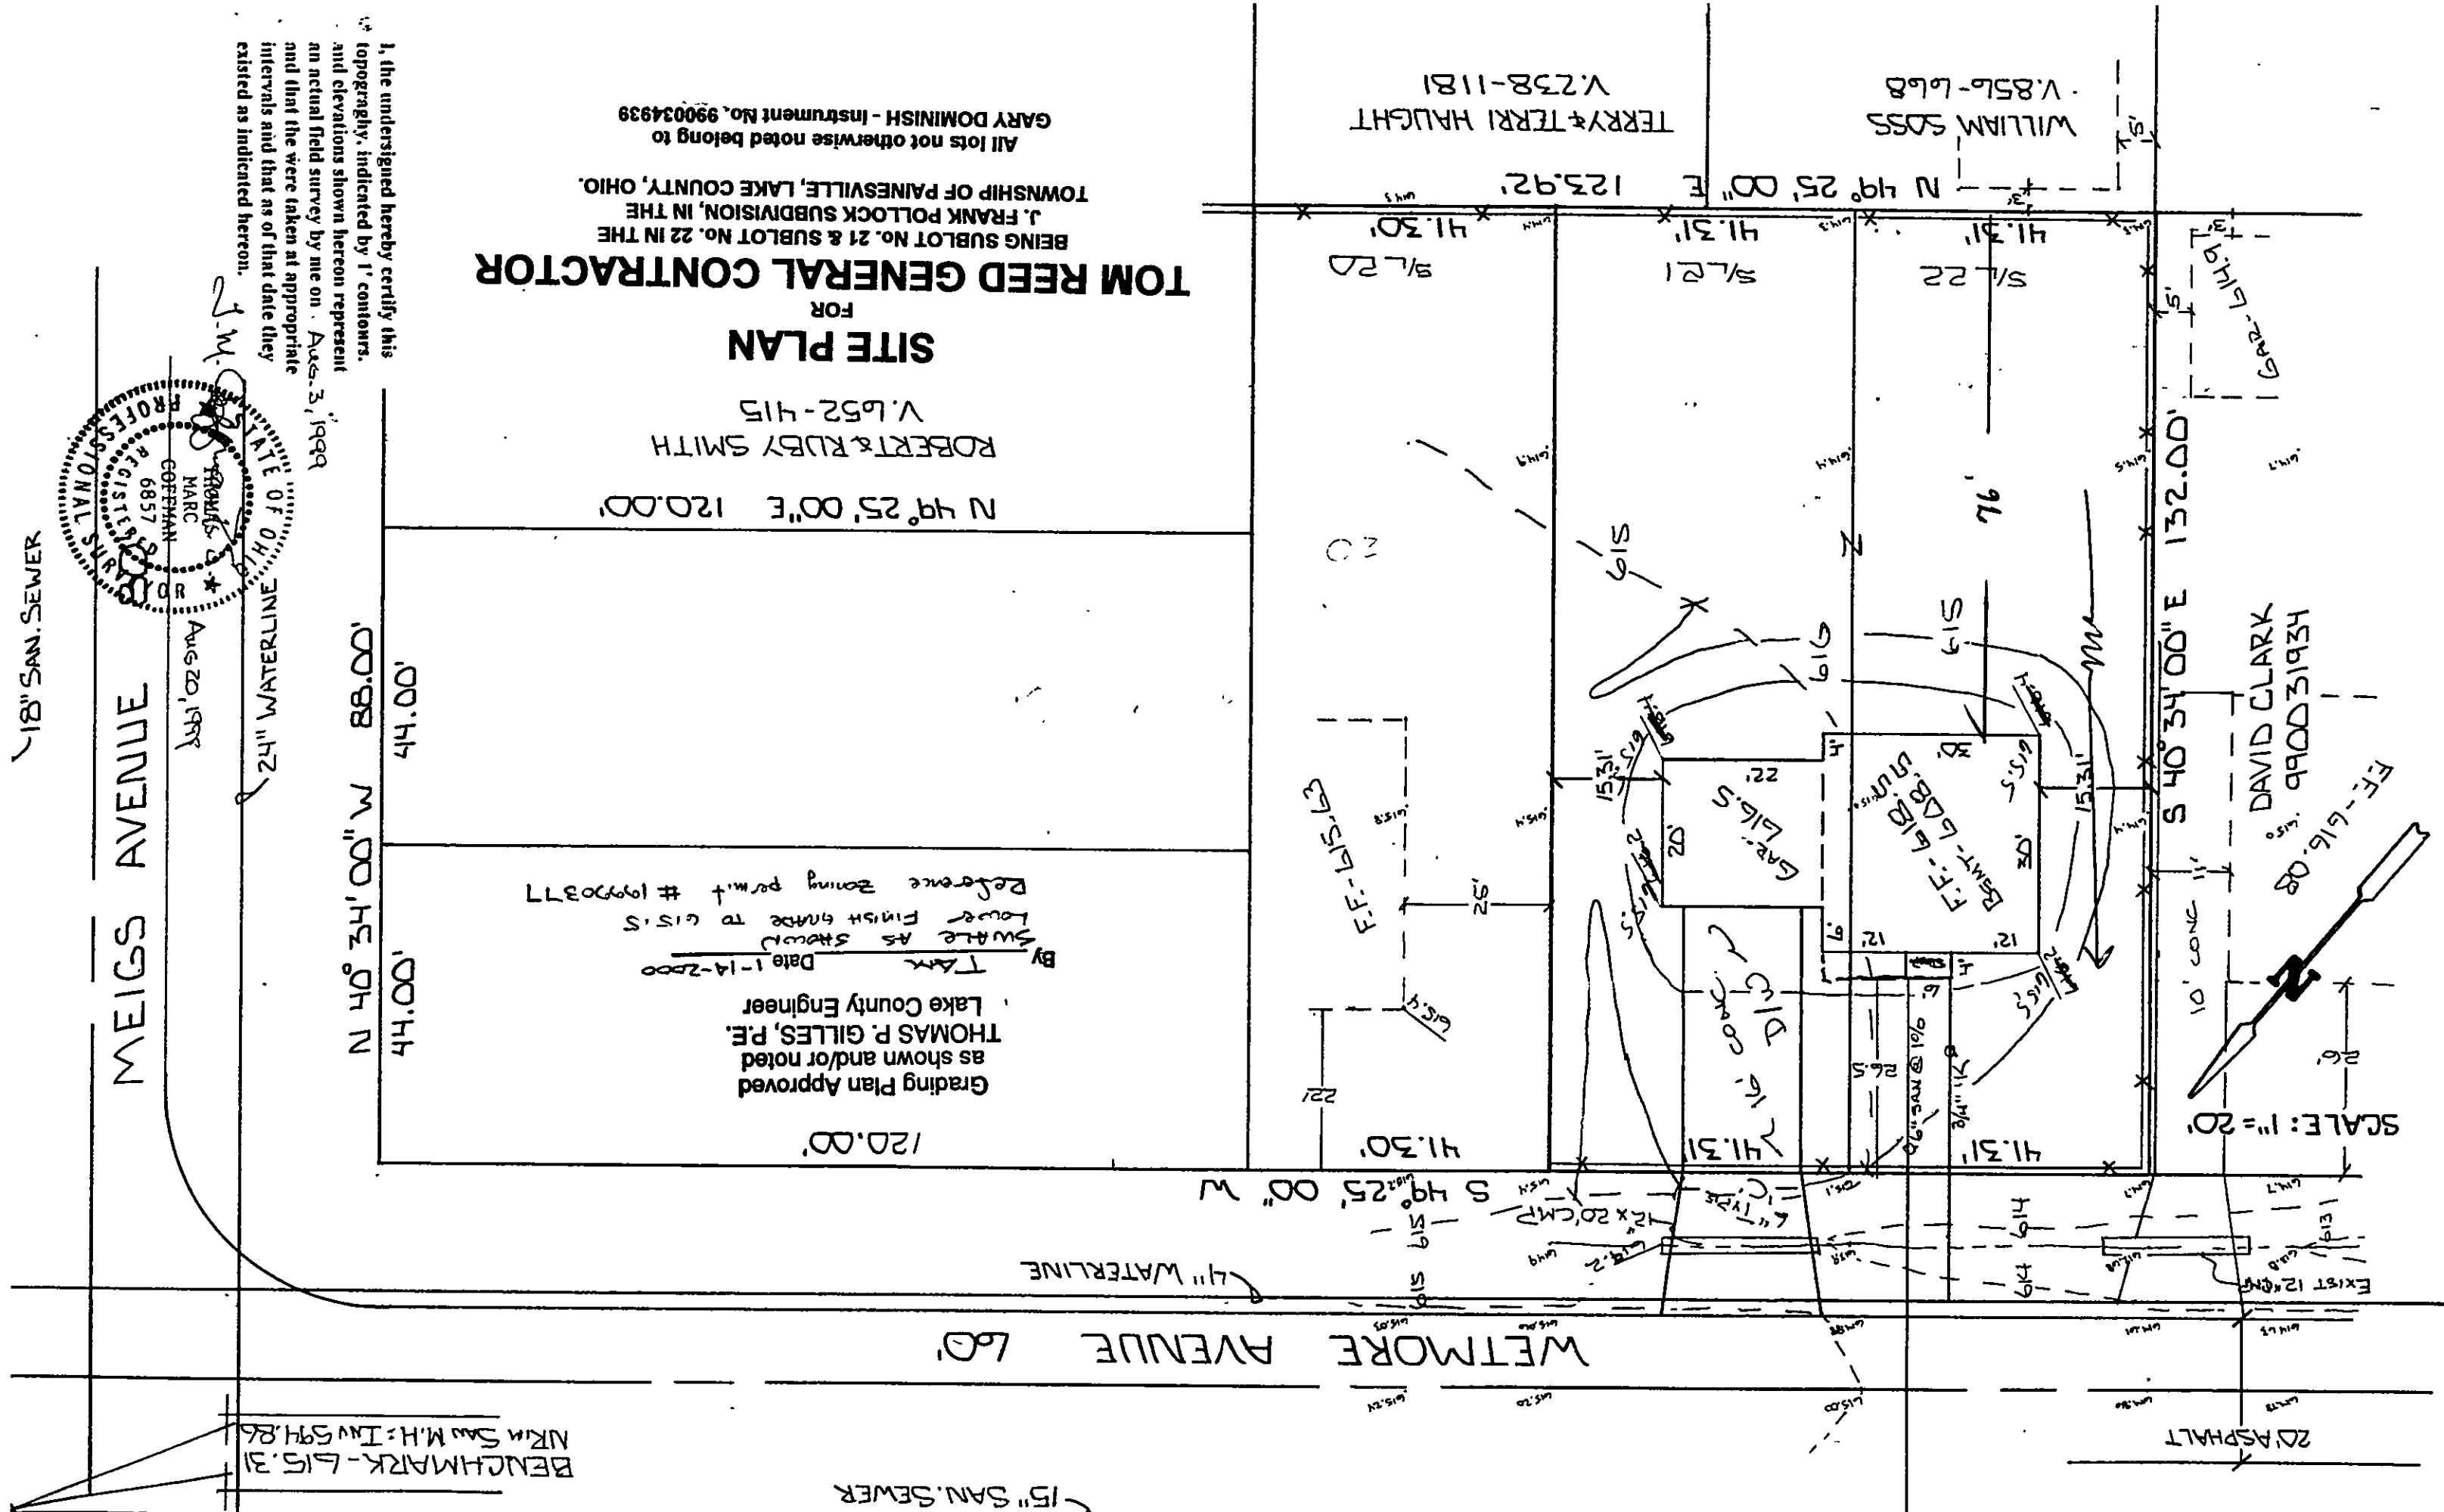

TOM REED GENERAL CONTRACTOR
FOR
SITE PLAN

ROBERT & RUBY SMITH
V. 652-415
N 49° 25' 00" E 120.00'

BEING SUBLOT NO. 21 & SUBLOT NO. 22 IN THE
J. FRANK POLLOCK SUBDIVISION, IN THE
TOWNSHIP OF PAINESVILLE, LAKE COUNTY, OHIO.
All lots not otherwise noted belong to
GARY DOMINISH - Instrument No. 990034939

I, the undersigned hereby certify this
topography, indicated by 1' contours,
and elevations shown hereon represent
an actual field survey by me on Aug. 3, 1999
and that the were taken at appropriate
intervals and that as of that date they
existed as indicated hereon.

STATE OF OHIO
J. M. Goffman
REGISTERED PROFESSIONAL ENGINEER
No. 6857
MARC GOFFMAN
Aug 20, 1999

MEIGS AVENUE

18" SAN. SEWER

BENCHMARK - 615.31
NRM SAN M.H. - INV 594.86

15" SAN. SEWER