


REG. SURVEYOR NO. 5244
 DESIGN CERTIFICATION
 THIS PLAN WAS PREPARED BY ME, AND IS CORRECT TO THE BEST OF MY KNOWLEDGE AND BELIEF.

REG. SURVEYOR NO.
 AS BUILT CERTIFICATION
 I HEREBY CERTIFY THAT THE CIRCLED GRADES ARE EXISTING FINISH GRADES CHECKED IN THE FIELD ON SURVEY IS CORRECT TO THE BEST OF MY KNOWLEDGE AND BELIEF.

COLPETZER • WOODS
 CONSULTANTS, INC.
 9470 MENTOR AVENUE • MENTOR, OHIO 44060 • (216) 357-7569

DATE: April 23, 1986
 SCALE: 1" = 20'
 DRAWN BY: UB
 CHECKED BY: 19.146-066
 JOB NO: 531
 PG. 77

SITE PLAN FOR:
EDWARD H. TRESSELER, INC.
 8100 DEERWOOD BLVD., MENTOR, OHIO
 NO. 2 IN PAINESVILLE TOWNSHIP, OHIO.

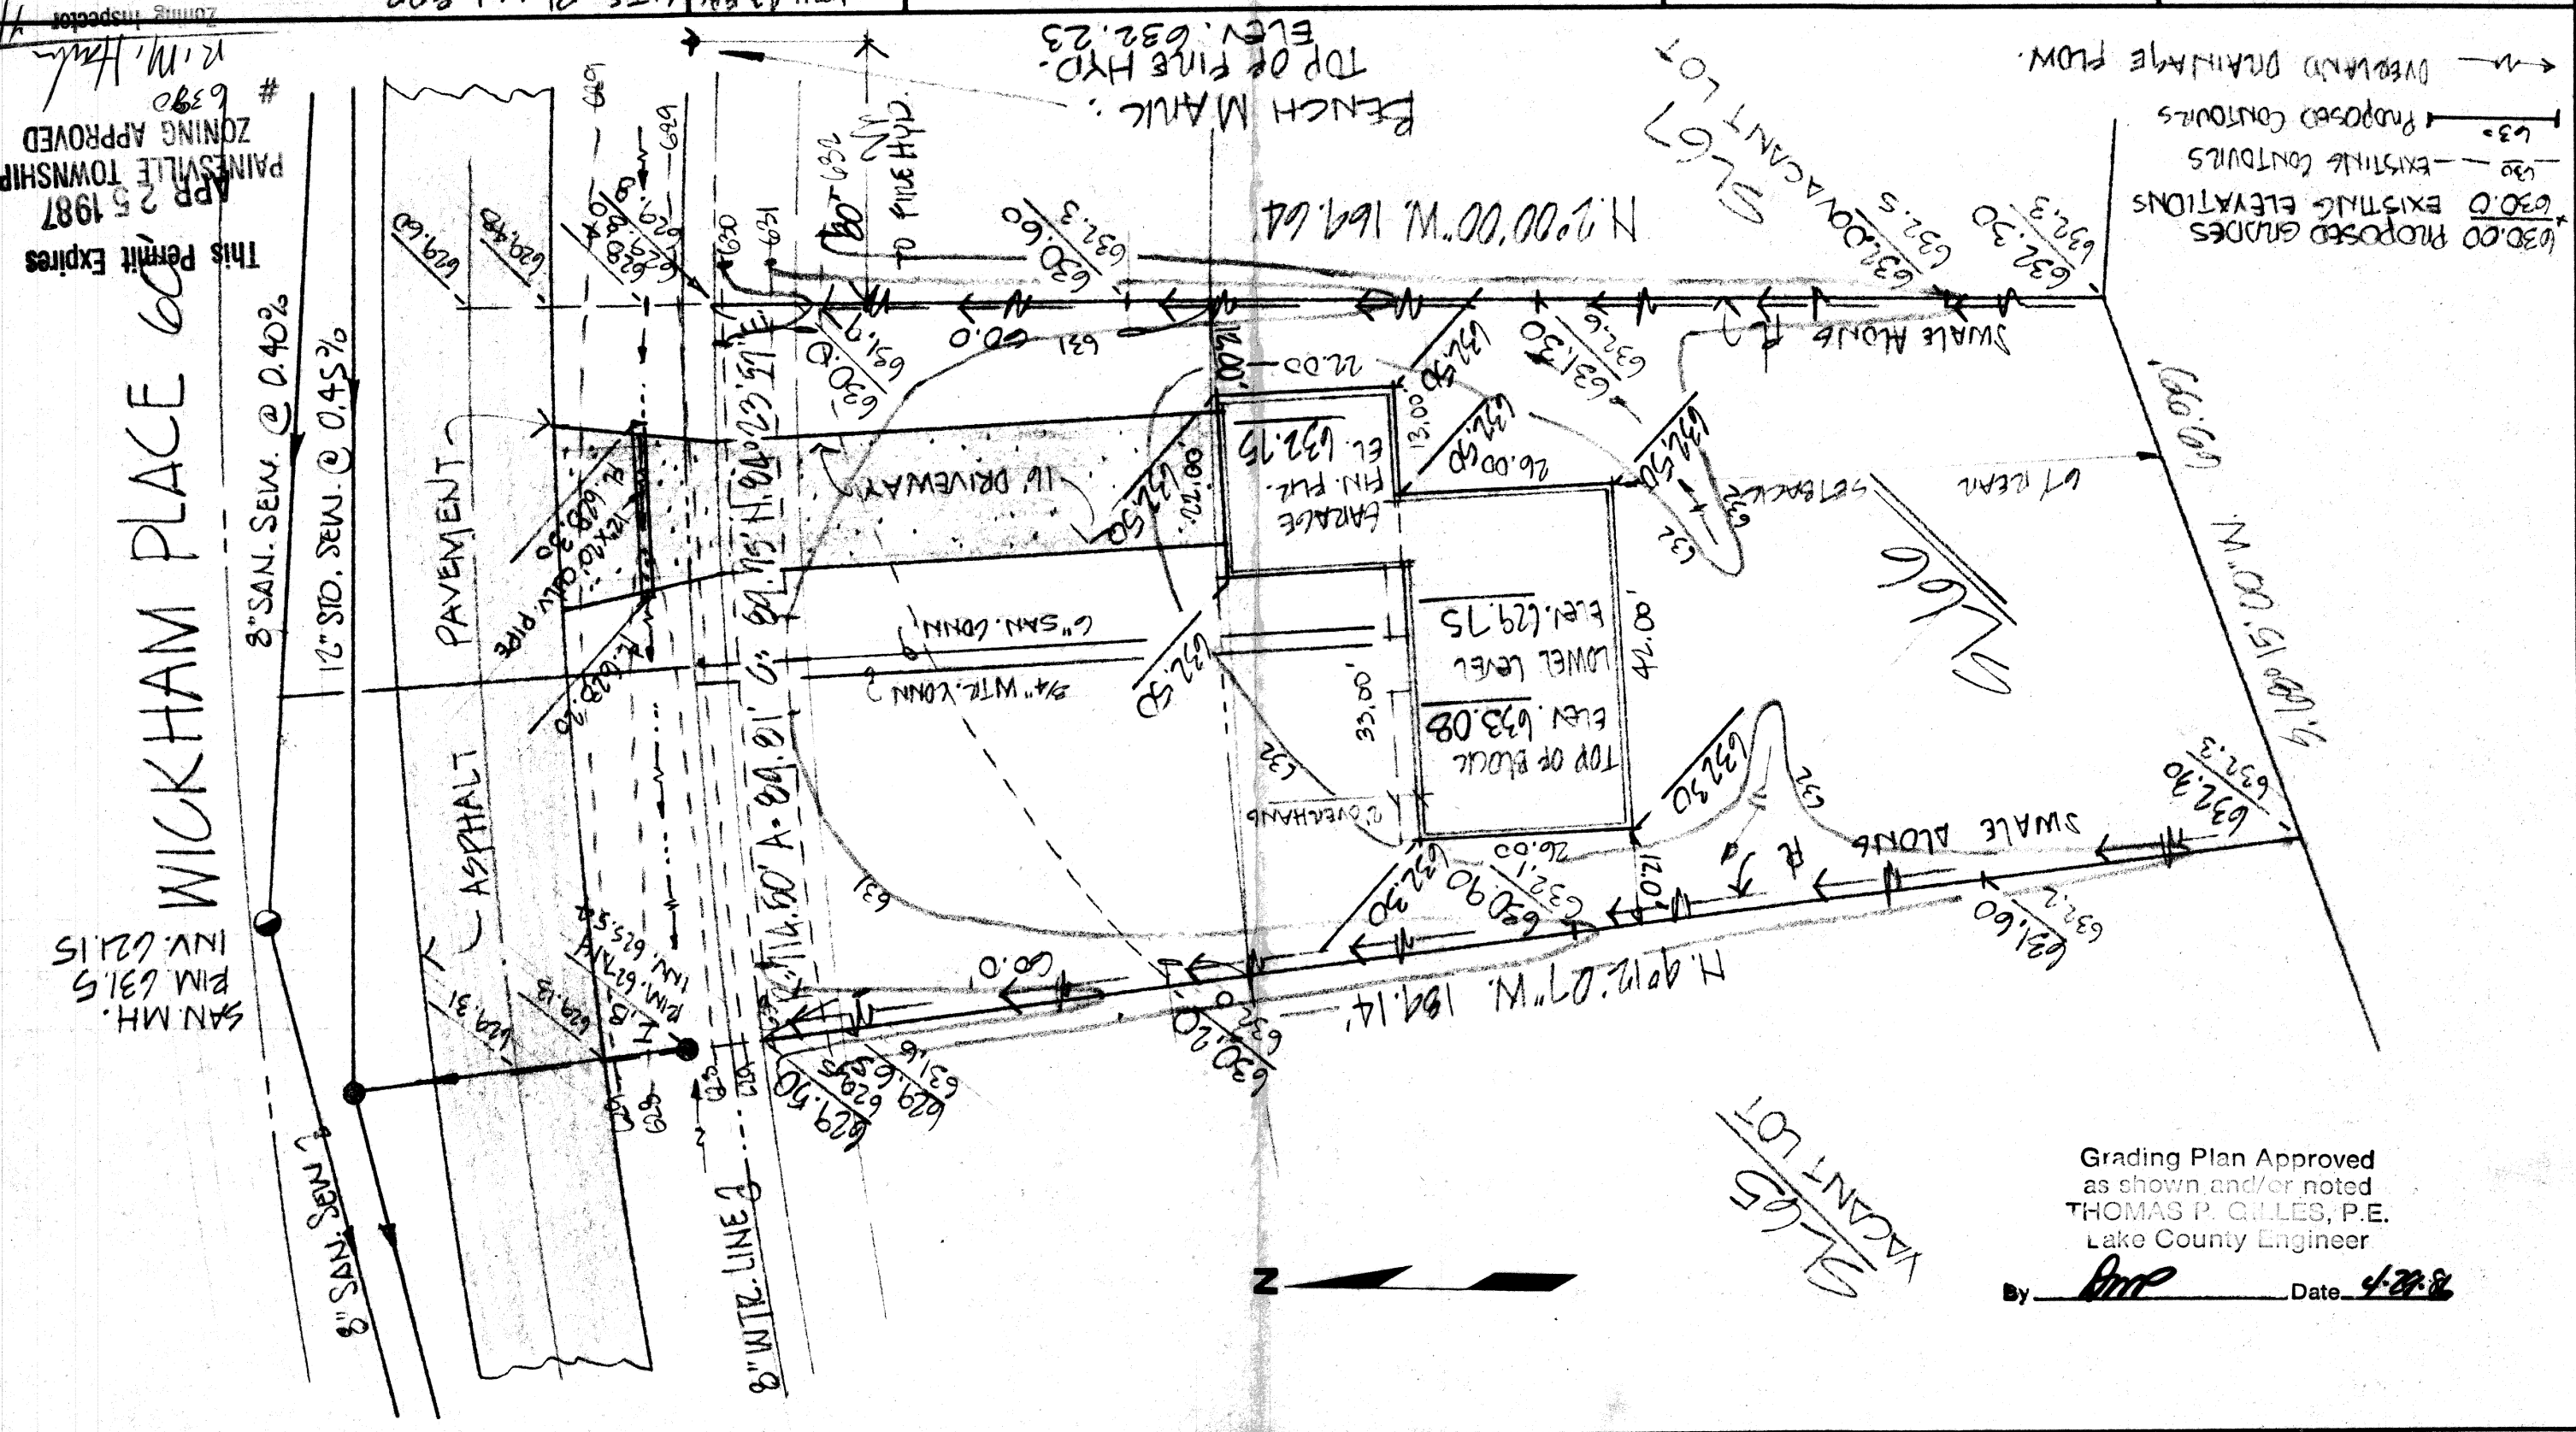

PAINESVILLE TOWNSHIP
 APR 25 1987
 ZONING APPROVED
 # 6380
 R.M. Hall
 This Permit Expires

Grading Plan Approved
 as shown and/or noted
THOMAS P. GILLES, P.E.
 Lake County Engineer
 By: *[Signature]* Date: 4-27-86