


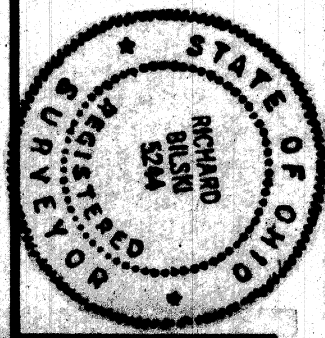

CERTIFICATION
THIS PLAN WAS PREPARED BY ME
AND IS CORRECT TO THE BEST OF
MY KNOWLEDGE AND BELIEF

AS BUILT CERTIFICATION
I HEREBY CERTIFY THAT THE CIRCLED GRADES
ARE EXISTING FINISH GRADES CHECKED IN THE
FIELD AND ARE CORRECT TO THE BEST OF MY
KNOWLEDGE AND BELIEF

DATE: 10/4/1985
SCALE: 1/2" = 10'
DRAWN BY: [Signature]
CHECKED BY: [Signature]
FAS 302A, 10-11-12

COLPETZER & WOODS
CONSULTANTS, INC.
MENTOR, OHIO 44060

SHEET 1 OF 1

WICKHAM PLACE

EDWARD H. TRESAER, INC.
9100 DEARBORN BLVD. MENTOR, OHIO
IN PAINESVILLE TWP. OHIO

