



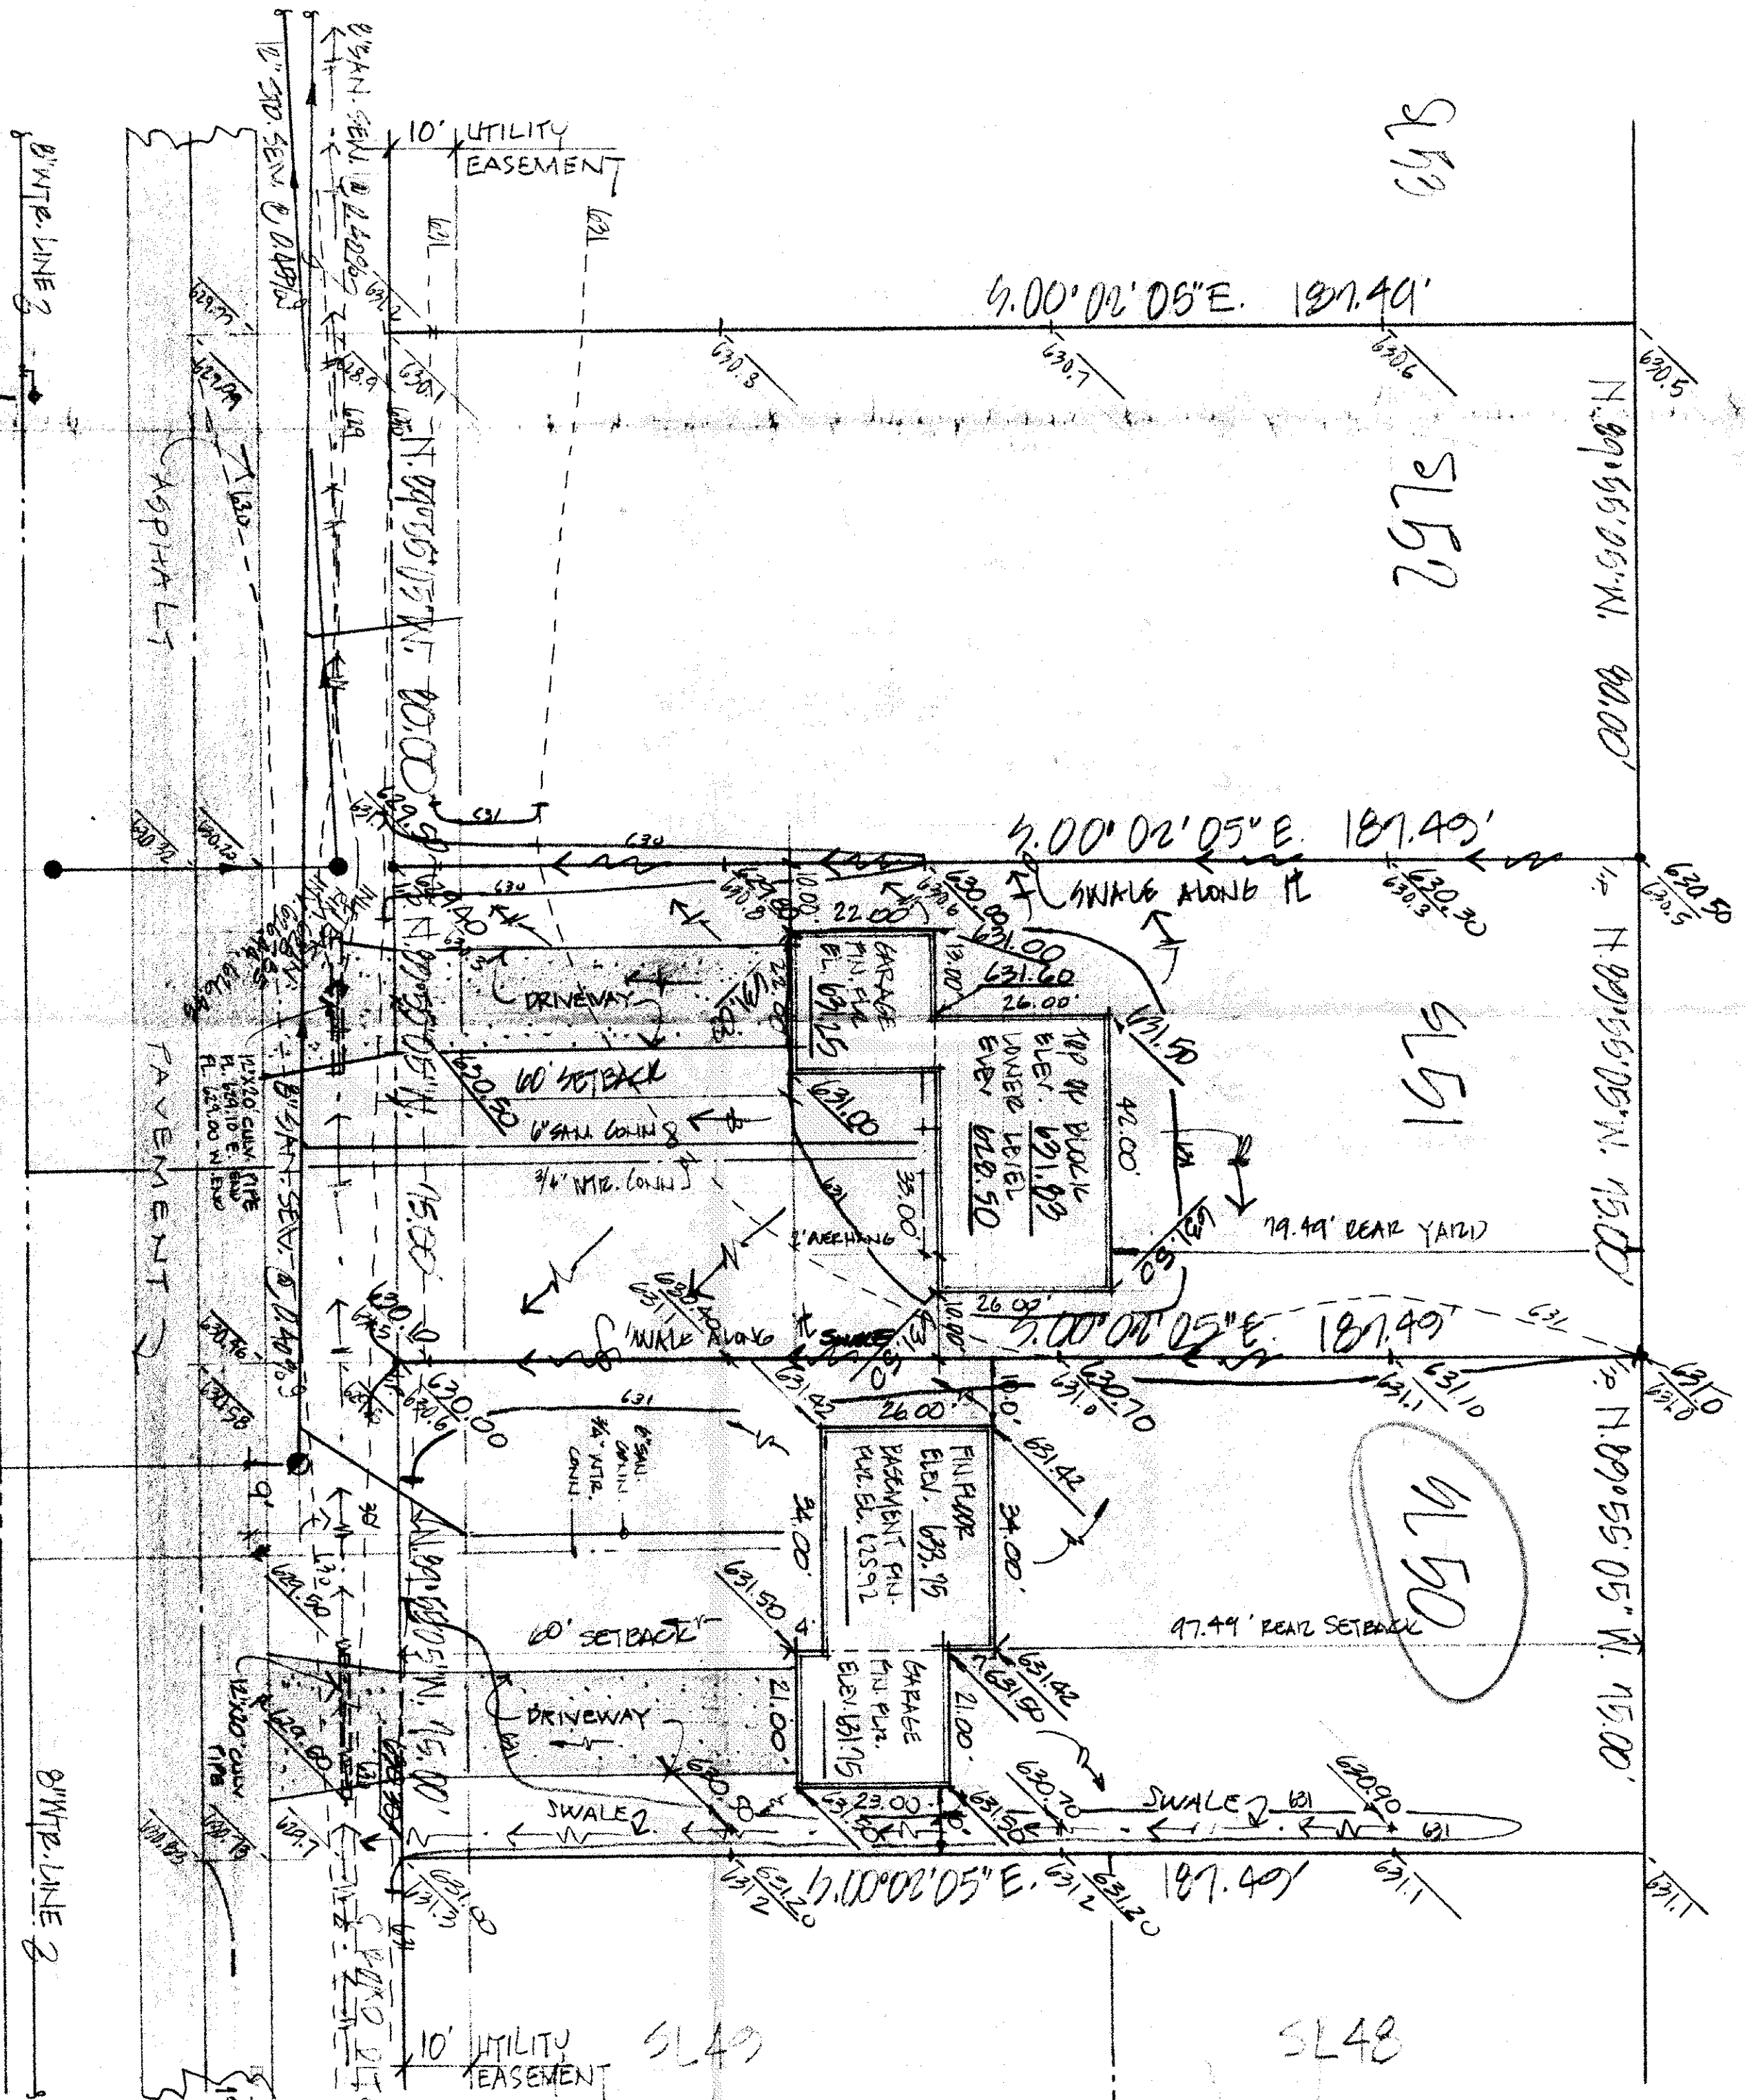

WICKHAM PLACE

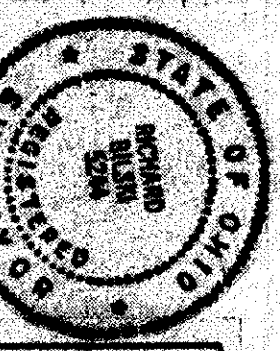

CERTIFICATION
THIS PLAN WAS PREPARED BY ME
AND IS CORRECT TO THE BEST OF
MY KNOWLEDGE AND BELIEF.

AS BUILT CERTIFICATION
I HEREBY CERTIFY THAT THE CIRCLED GRADES
ARE EXISTING FINISH GRADES CHECKED IN THE
FIELD ON 4/25/99 AND THAT
THE SURVEY IS CORRECT TO THE BEST OF MY
KNOWLEDGE AND BELIEF.

SITE PLAN FOR: EDWARD H. RESNER, INC.
BEING SUBLOT NO. 50, 51 AND 52 IN THE PINES SUBD. NO. 2
IN PAINESVILLE TWP. C.A.D.

DATE: 4/25/99
SCALE: 1/4" = 10'

DESIGNED BY: COLPETZER & WOODS
CHECKED BY: COLPETZER & WOODS
DATE: 4/25/99



COLPETZER & WOODS
CONSULTANTS, INC.
MENTOR, OHIO 44060

DATE: 4/25/99
SHEET: 1 OF 1

NOTE: UNDERLINED ELEVATIONS INDICATES PROPOSED GRADES

This Permit Expires
4-25-99
PAINESVILLE TOWNSHIP
ZONING APPROVED
6940
Linda E. M...
Zoning Inspector 4/25/99

Grading Plan Approved
as shown and/or noted
THOMAS P. GILLES, P.E.
Lake County Engineer

Date: 4/25/99