

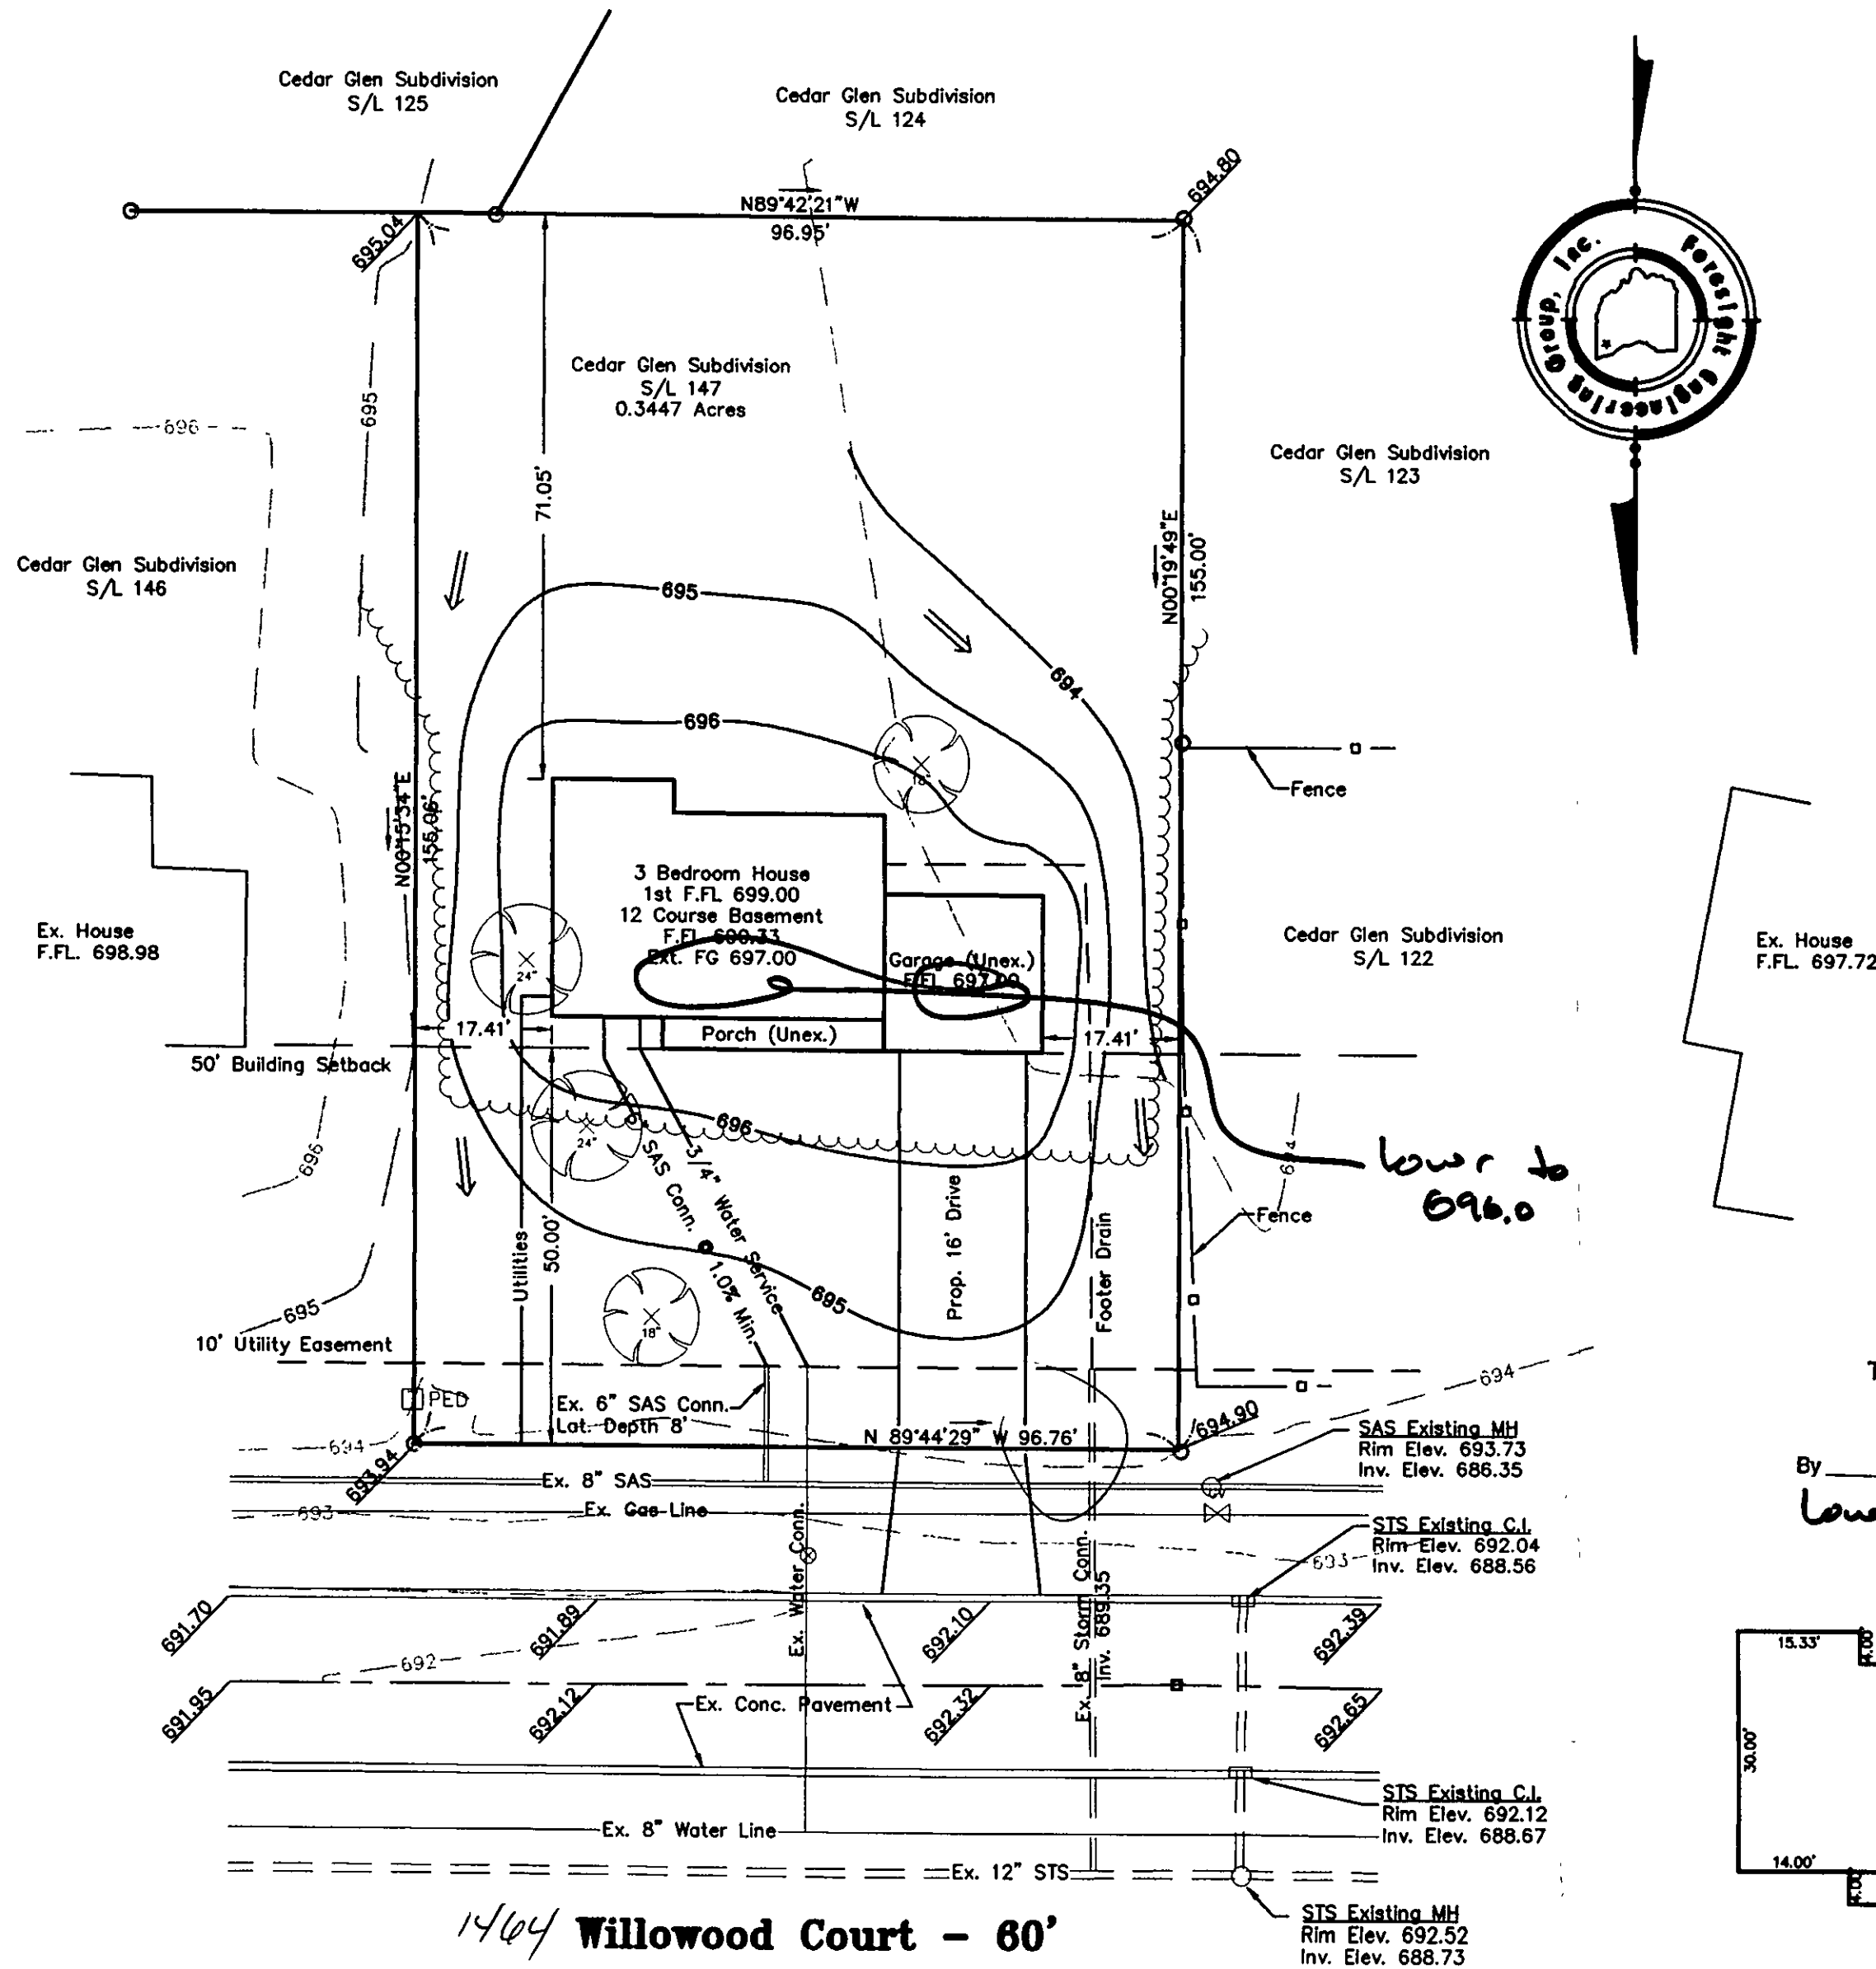


SYMBOL LEGEND	
	Iron Pin in Monument Found
	Manhole
	Iron Pin Found
	Telephone SAC Box
	Water Shut Off Valve
	Curb Inlet
	Gas Valve

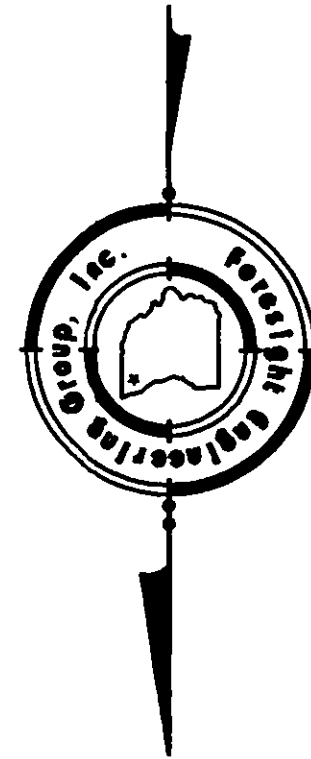

Grading Plan Approved
as shown and/or noted
THOMAS P. GILLES, P.E.
Lake County Engineer

By GJH Date 7.23.98
Lower Fg to 696.0

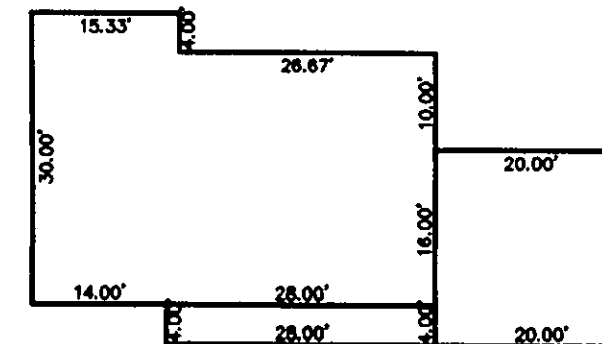

Zoning District R-1
Front Setback 50'
Side Setback 10'
Rear Setback 25'

APPROVED
PAINESVILLE TOWNSHIP
ZONING DEPARTMENT
19980214
DKH

SITE PLAN
for : R. L. Moore Homes
CLIENT
7121 Revenna Road Concord Ohio 44077
ADDRESS CITY STATE ZIP

147 Cedar Glen
SUBLOT No. SUBDIVISION NAME VOL. PAGE
Painesville Ohio
LOT TRACT CITY STATE

Foresight Engineering Group
Engineers & Surveyors
440 286-1010
440 286-1034 fax
320 Center Street, Unit F
Chardon, Ohio 44024

DESIGN CERTIFICATION

This Site Plan was prepared by Foresight Engineering Group, Inc.,
and is correct to the best of my knowledge and belief.

Steven N. Roessner
NAME

CHECK LIST

LOT DIMENSIONS & BEARINGS
TIE TO NEAREST STREET
SUBLOT No. (PARCEL No.)
SURROUNDING OWNERS
BUILDING DIMENSIONS
SETBACK, SIDEYARD, REARYARD
FINISH GRADES
DRIVE & APRON TYPE, WIDTH, THICKNESS
SIDEWALK TYPE, WIDTH, THICKNESS
CULVERT TYPE, DIAM., LENGTH
WATER MAIN SIZE, LOCATION
SAN. SEWER SIZE, % GRADE, LOC.
SAN. MH. CAST. ELEV., INV. ELEV.
SAN. CONN. SIZE, % GRADE, LOC.
STORM SEWER SIZE, % GRADE, LOC.
STORM MH. CAST. ELEV., INV. ELEV.
PAVT TYPE, GRADE, CURBS
GAS LINE LOC., SIZE
SEPTIC SYSTEM & DUPLICATION
WELL LOCATION & ISOLATION RADIUS



STATE SEAL

"AS BUILT" CERTIFICATION

I hereby certify that the circled information is existing as
obtained on the site _____ 19__ and is
correct to the best of my knowledge and belief.


NAME _____

SCALE : 1" = 20	1
FILE NAME: I:\Rim19810\sl147.Dwg	2
DATE : July 20, 1998	3

BENCHMARK: SAS MH. Rim Elev. = 693.73

"I, the undersigned hereby certify that this topography, indicated by 6", 1' or 2'
contours, and the elevations shown hereon represent an actual field survey made
by Foresight Engineering Group, Inc. on the June day of 29
191998, and that the elevations were taken at appropriate intervals and
that as of that date they existed as indicated hereon."

Steven N. Roessner
NAME

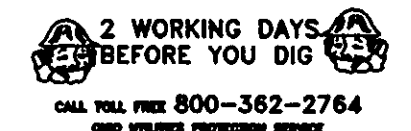

EXISTING UNDERGROUND UTILITIES NOTES:

The location both horizontal and vertical of the underground utilities
shown hereon, have been obtained by a diligent and comprehensive
search of available records. Verification by field observation, has been
conducted where practical. However, Foresight Engineering Group, Inc.
does not guarantee the completeness nor accuracy thereof.