

LAKE COUNTY
390771 0028C DATED 1/2/80

100 year Flood
zone
Elev ~ 619.0



~~GRAND~~

REVIEWED BY: [Signature]
DATE: 2-15-01
SIGNATURE: David B. Norris

SEMI-ANNUAL DISPOSAL PERMIT MUST BE OBTAINED BY A LAKE COUNTY LICENSED INSTALLER BEFORE INSTALLATION IS STARTED.

685' S.B.

19.9 AC,
11A-5-247

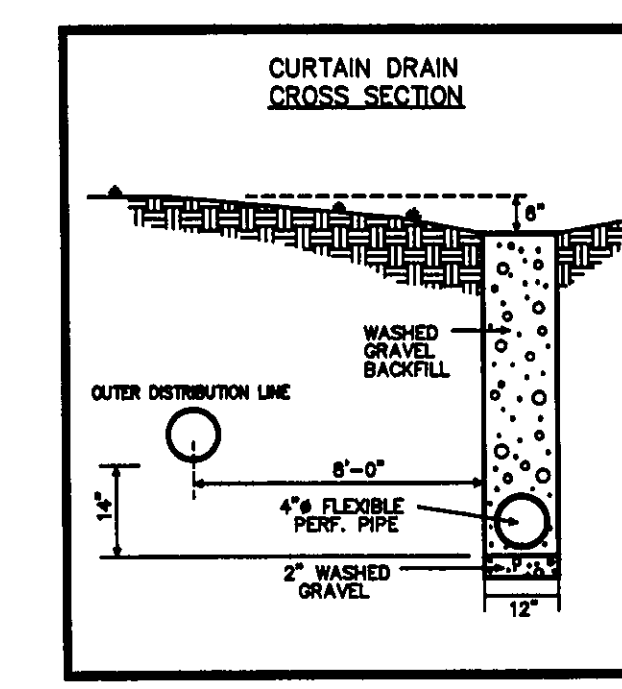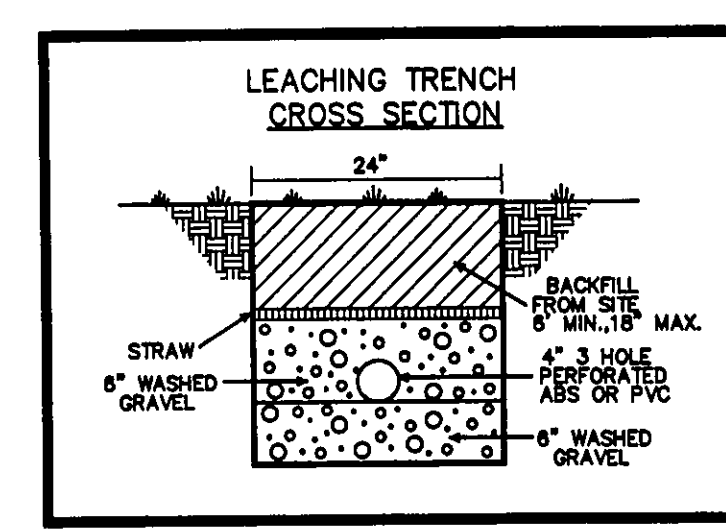


Grading Plan Approved
as shown and/or noted
JAMES R. GILLS, P.E.
Lake County Engineer

By JRM Date 2/26/01 As to
Driveway should have a 10% grade MAXIMUM.

"I, the undersigned hereby certify that this topography indicated by 6", 1", or 2' contours, and elevations shown hereon represent an actual field survey made by me on the 10th day of Jan, 2001 and that the elevations were taken at appropriate intervals and that as of that date they existed as indicated hereon."

Name Harry Jones Reg. No. #6343

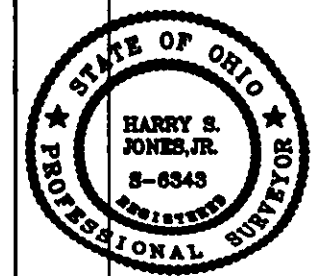

1/11/01	SITE PLAN FOR JIM MAUTER PAINESVILLE TOWNSHIP LAKE COUNTY	SCALE: 1"=30'
H.J.		JOB NO 01-001
T.R.		SHEET 1 OF 1
H.J.		

bj BABCOCK, JONES AND ASSOCIATES, INC
CIVIL ENGINEERS - SURVEYORS - LAND PLANNERS
PAINESVILLE OHIO 44077

[illegible]