


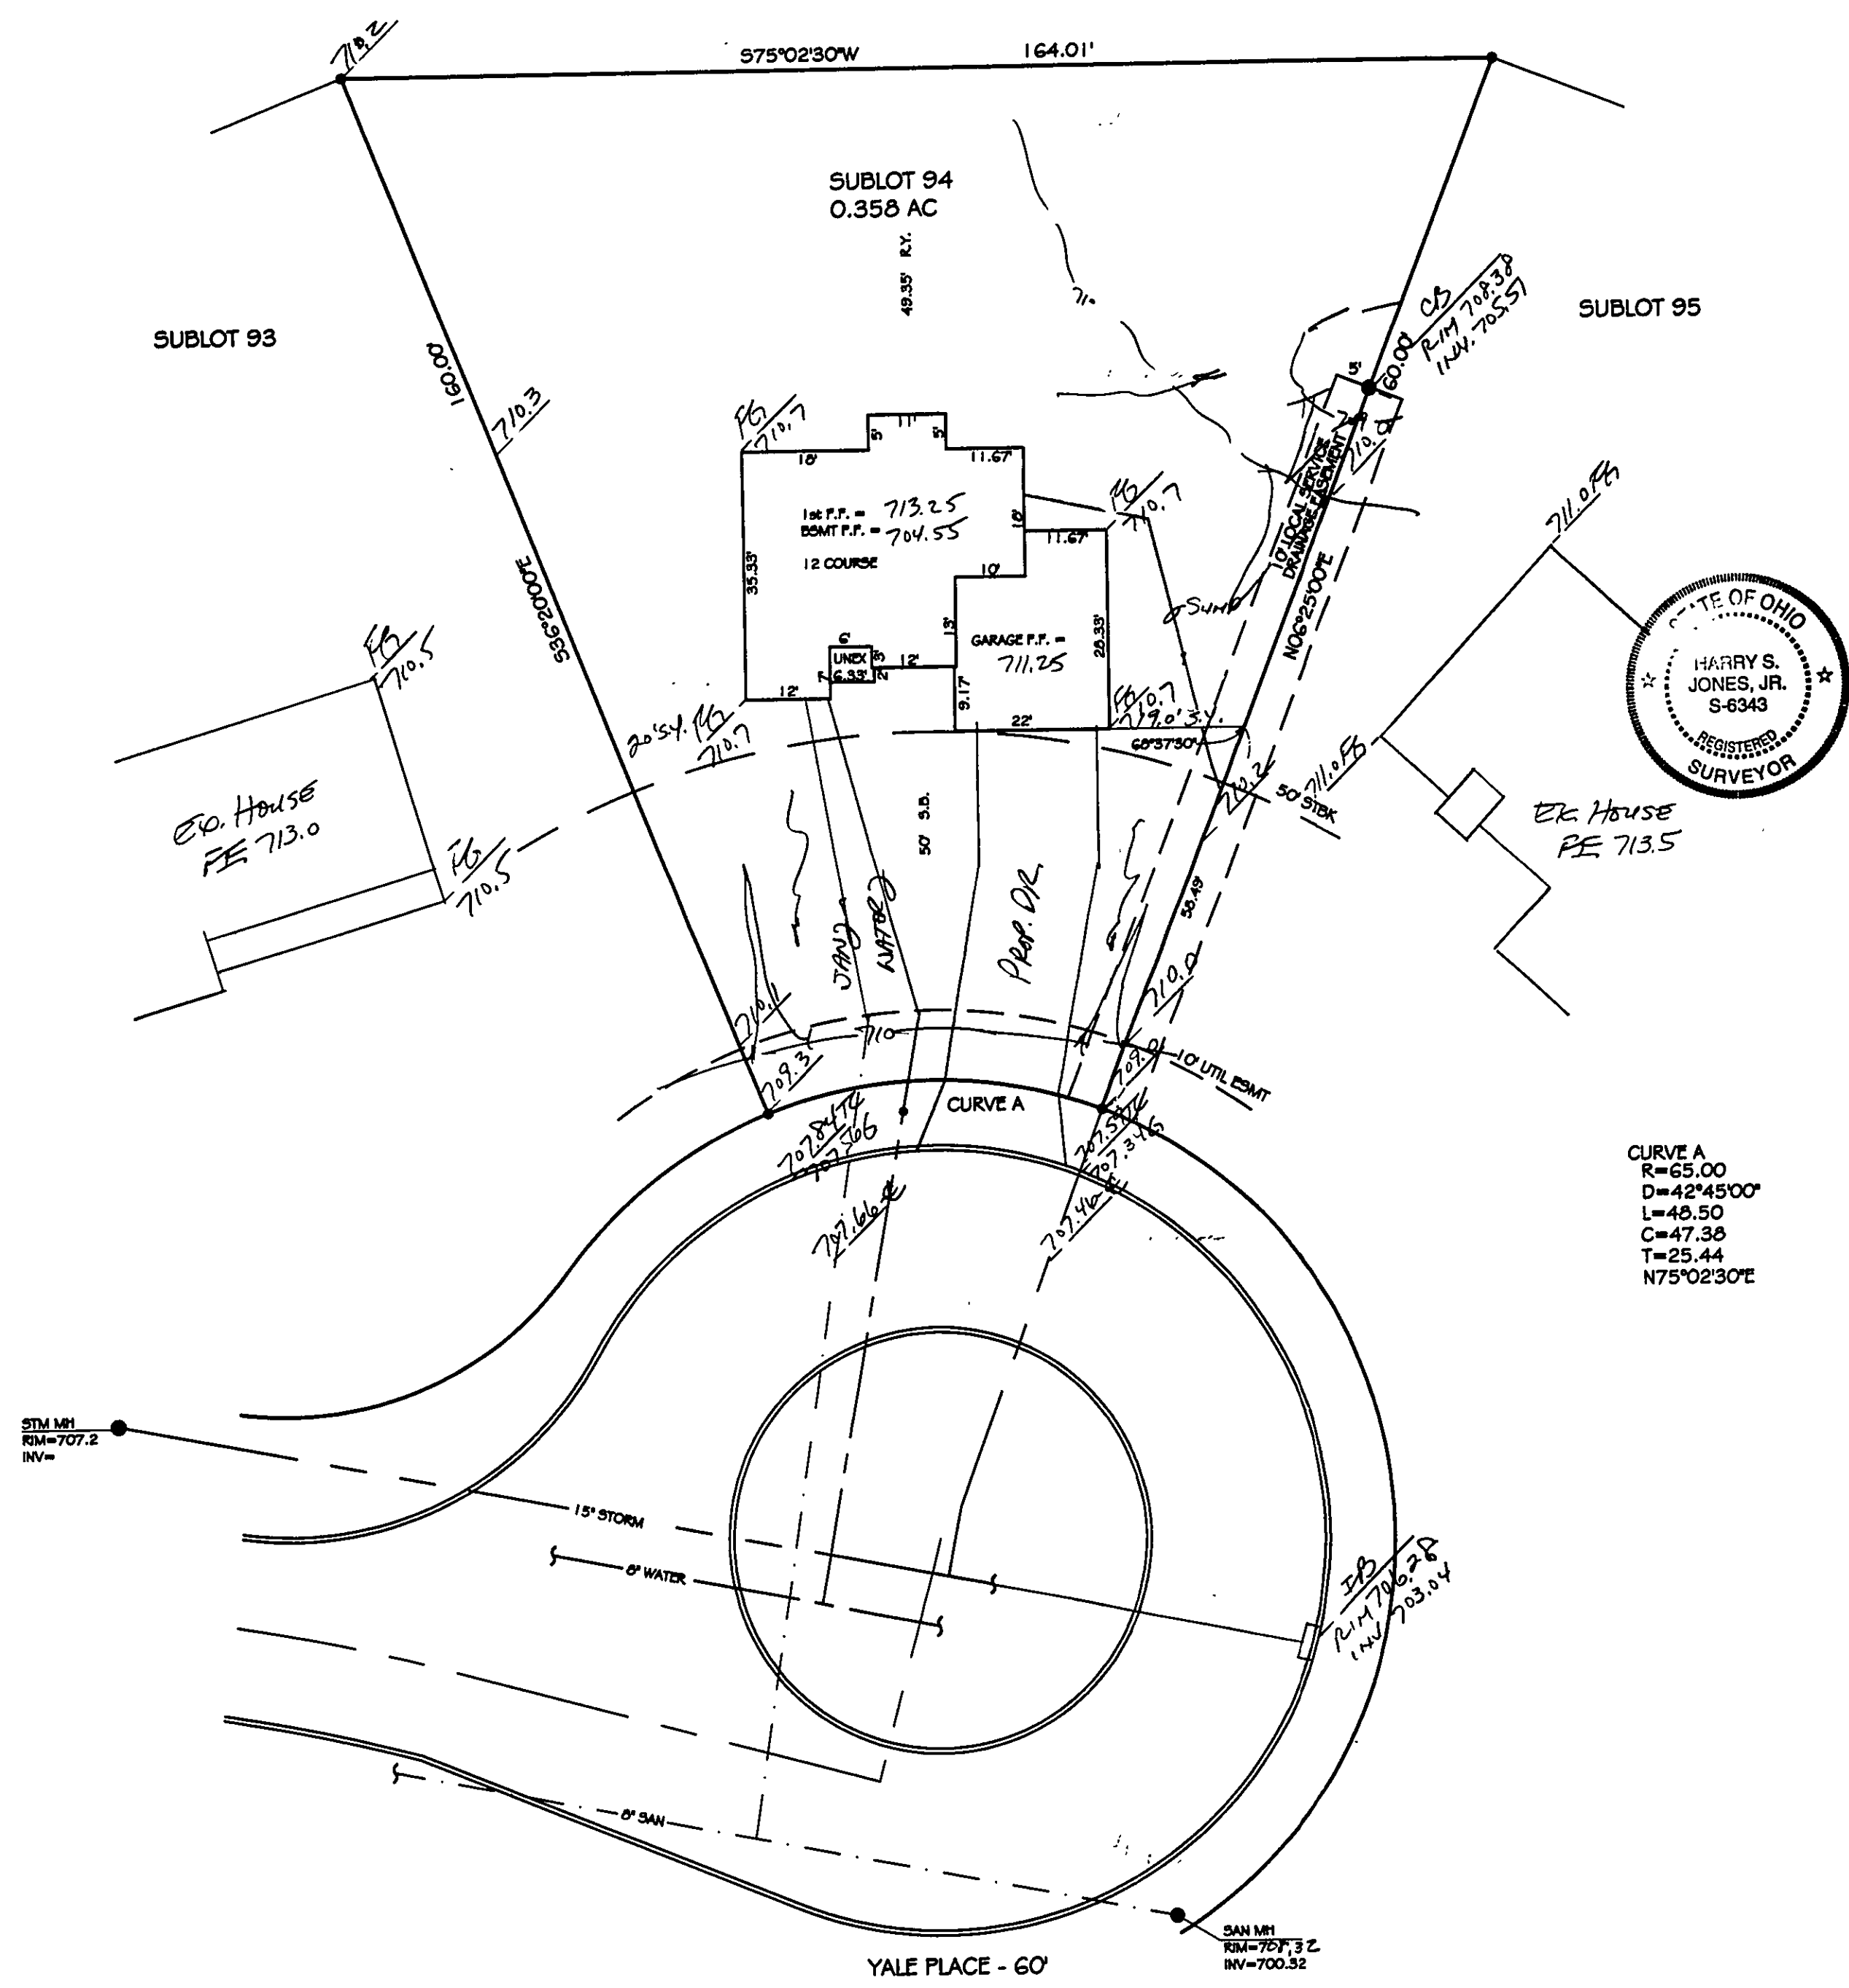

SITE PLAN

PAINESVILLE TWP., LAKE COUNTY, OHIO

for: MALKAMAKI BUILDERS

CLIENT

OWNER

ADDRESS

STREET

CITY

ZIP

HEATHERSTONE SUB

SUBDIVISION

NAME

TRACT

81-21

VOL-PG

LOT

STREET

94

YALE PLACE

SUBLOT NO.

STREET

VOL-PG

PERM. PARCEL NO.

LEGEND

SANITARY MANHOLE

STORM MANHOLE

INLET OR CATCH BASIN

HYDRANT

EXISTING CONTOURS

PROPOSED CONTOURS

EXIST. ELEV. 100.0

100.0 ± 2 PROP. ELEV.

AS BUILT ELEVATION

INDICATES DIRECTION OF SURFACE DRAINAGE

REMARKS

ALL BOUNDARY DATA SHOWN WAS OBTAINED FROM (DEEDS, RECORDED SUBDIVISION PLAT OR OTHER PUBLIC RECORDS)

LOCATIONS AS SHOWN OF ADJACENT WELLS AND SEPTIC TANKS OBTAINED FROM LAKE COUNTY HEALTH DEPARTMENT

DESIGN CERTIFICATION

THIS PLAT WAS PREPARED BY ME, AND IS CORRECT TO THE BEST OF MY KNOWLEDGE AND BELIEF.

NAME

SURVEYOR

REGISTRATION NO.

Harry S. Jones, Jr.

S-6343

CHECK LIST

NO. OF BEDROOMS

DIMENSIONS

BEARINGS

TIE TO NEAREST STREET

SUBLOT NO. PARCEL NO.

SURROUNDING OWNERS

BLDG. DIMENSIONS FIN GR.

BLDG. TIES FL'R. GRADES

APRON TYPE WIDTH THICKNESS

SIDEWALK TYPE WIDTH THICKNESS

CULVERT TYPE DIA. LENGTH

ROCK OUTCROPPINGS

WATER MAIN SIZE, LOCATION

SAN. SEWER SIZE & GR. LOC.

SAN. MH. CAST. ELEV. INV. ELEV.

SAN. CONN. SIZE, LOC. DEPTH

STORM SEWER SIZE & GR. LOC.

STORM MH. CAST ELEV. INV. ELEV.

PAVT TYPE GRADE CURBS

GAS LINE LOC. SIZE PRESSURE

SEPTIC TANK LOCATION & DUPLICATION AREA

WELL LOCATION

ISOLATION RADIUS FROM WELL

REVISIONS

NO.	DATE	BY
1		
2		
3		
4		
5		

PLAN PREPARED BY:

BABCOCK JONES & ASSOCIATES, INC.

PAINESVILLE, OHIO

DRAWN BY

SCALE

PHONE NO.

CHK'D.

DATE

DRAWING NO.

CREW CHIEF

APP'D

H.J.

92-186-94

I, **HARRY S. JONES, JR.**, REGISTERED SURVEYOR, DO HEREBY CERTIFY THAT THE CIRCLED GRADES ARE EXISTING FINISH GRADES CHECKED IN THE FIELD ON **7/20/98**, 19__ AND ARE CORRECT TO THE BEST OF MY KNOWLEDGE AND BELIEF.

REGISTERED SURVEYOR

REG. NO.

TBM - RIM SAN M.H.

ELEV = 708.32

Grading Plan Approved as shown and/or not

THOMAS P. GILLES, P.E.

Lake County Engineer

By **G/H** Date **7.28.98**

APPROVED

PAINESVILLE TOWNSHIP

ZONING DEPARTMENT

19980220

D/K