

CURVE DATA ☒

R=4970.00'
A= 85.05'
C= 85.05'
B= N 87°18'26"W

Grading Plan Approved
as shown and/or noted
by **THOMAS P. GILLES, P.E.**
Lake County Engineer

By THM Date 8/25/92
Lower F6 to S718

SITE PLAN

FOR

STERLING BUILDERS

BEING KNOWN AS S/L 21 IN THE MOORE'S
LANDING SUBDIVISION IN MADISON TWP.,
LAKE COUNTY, OHIO.


SCALE: 1"=20'



EXIST.
PROP.

MADISON APPROVED TOWNSHIP ZONING
DATE 8/25/92
BY THM

BENCHMARK - N. RIM SAN. M.H.
589.45 INV. = 579.24

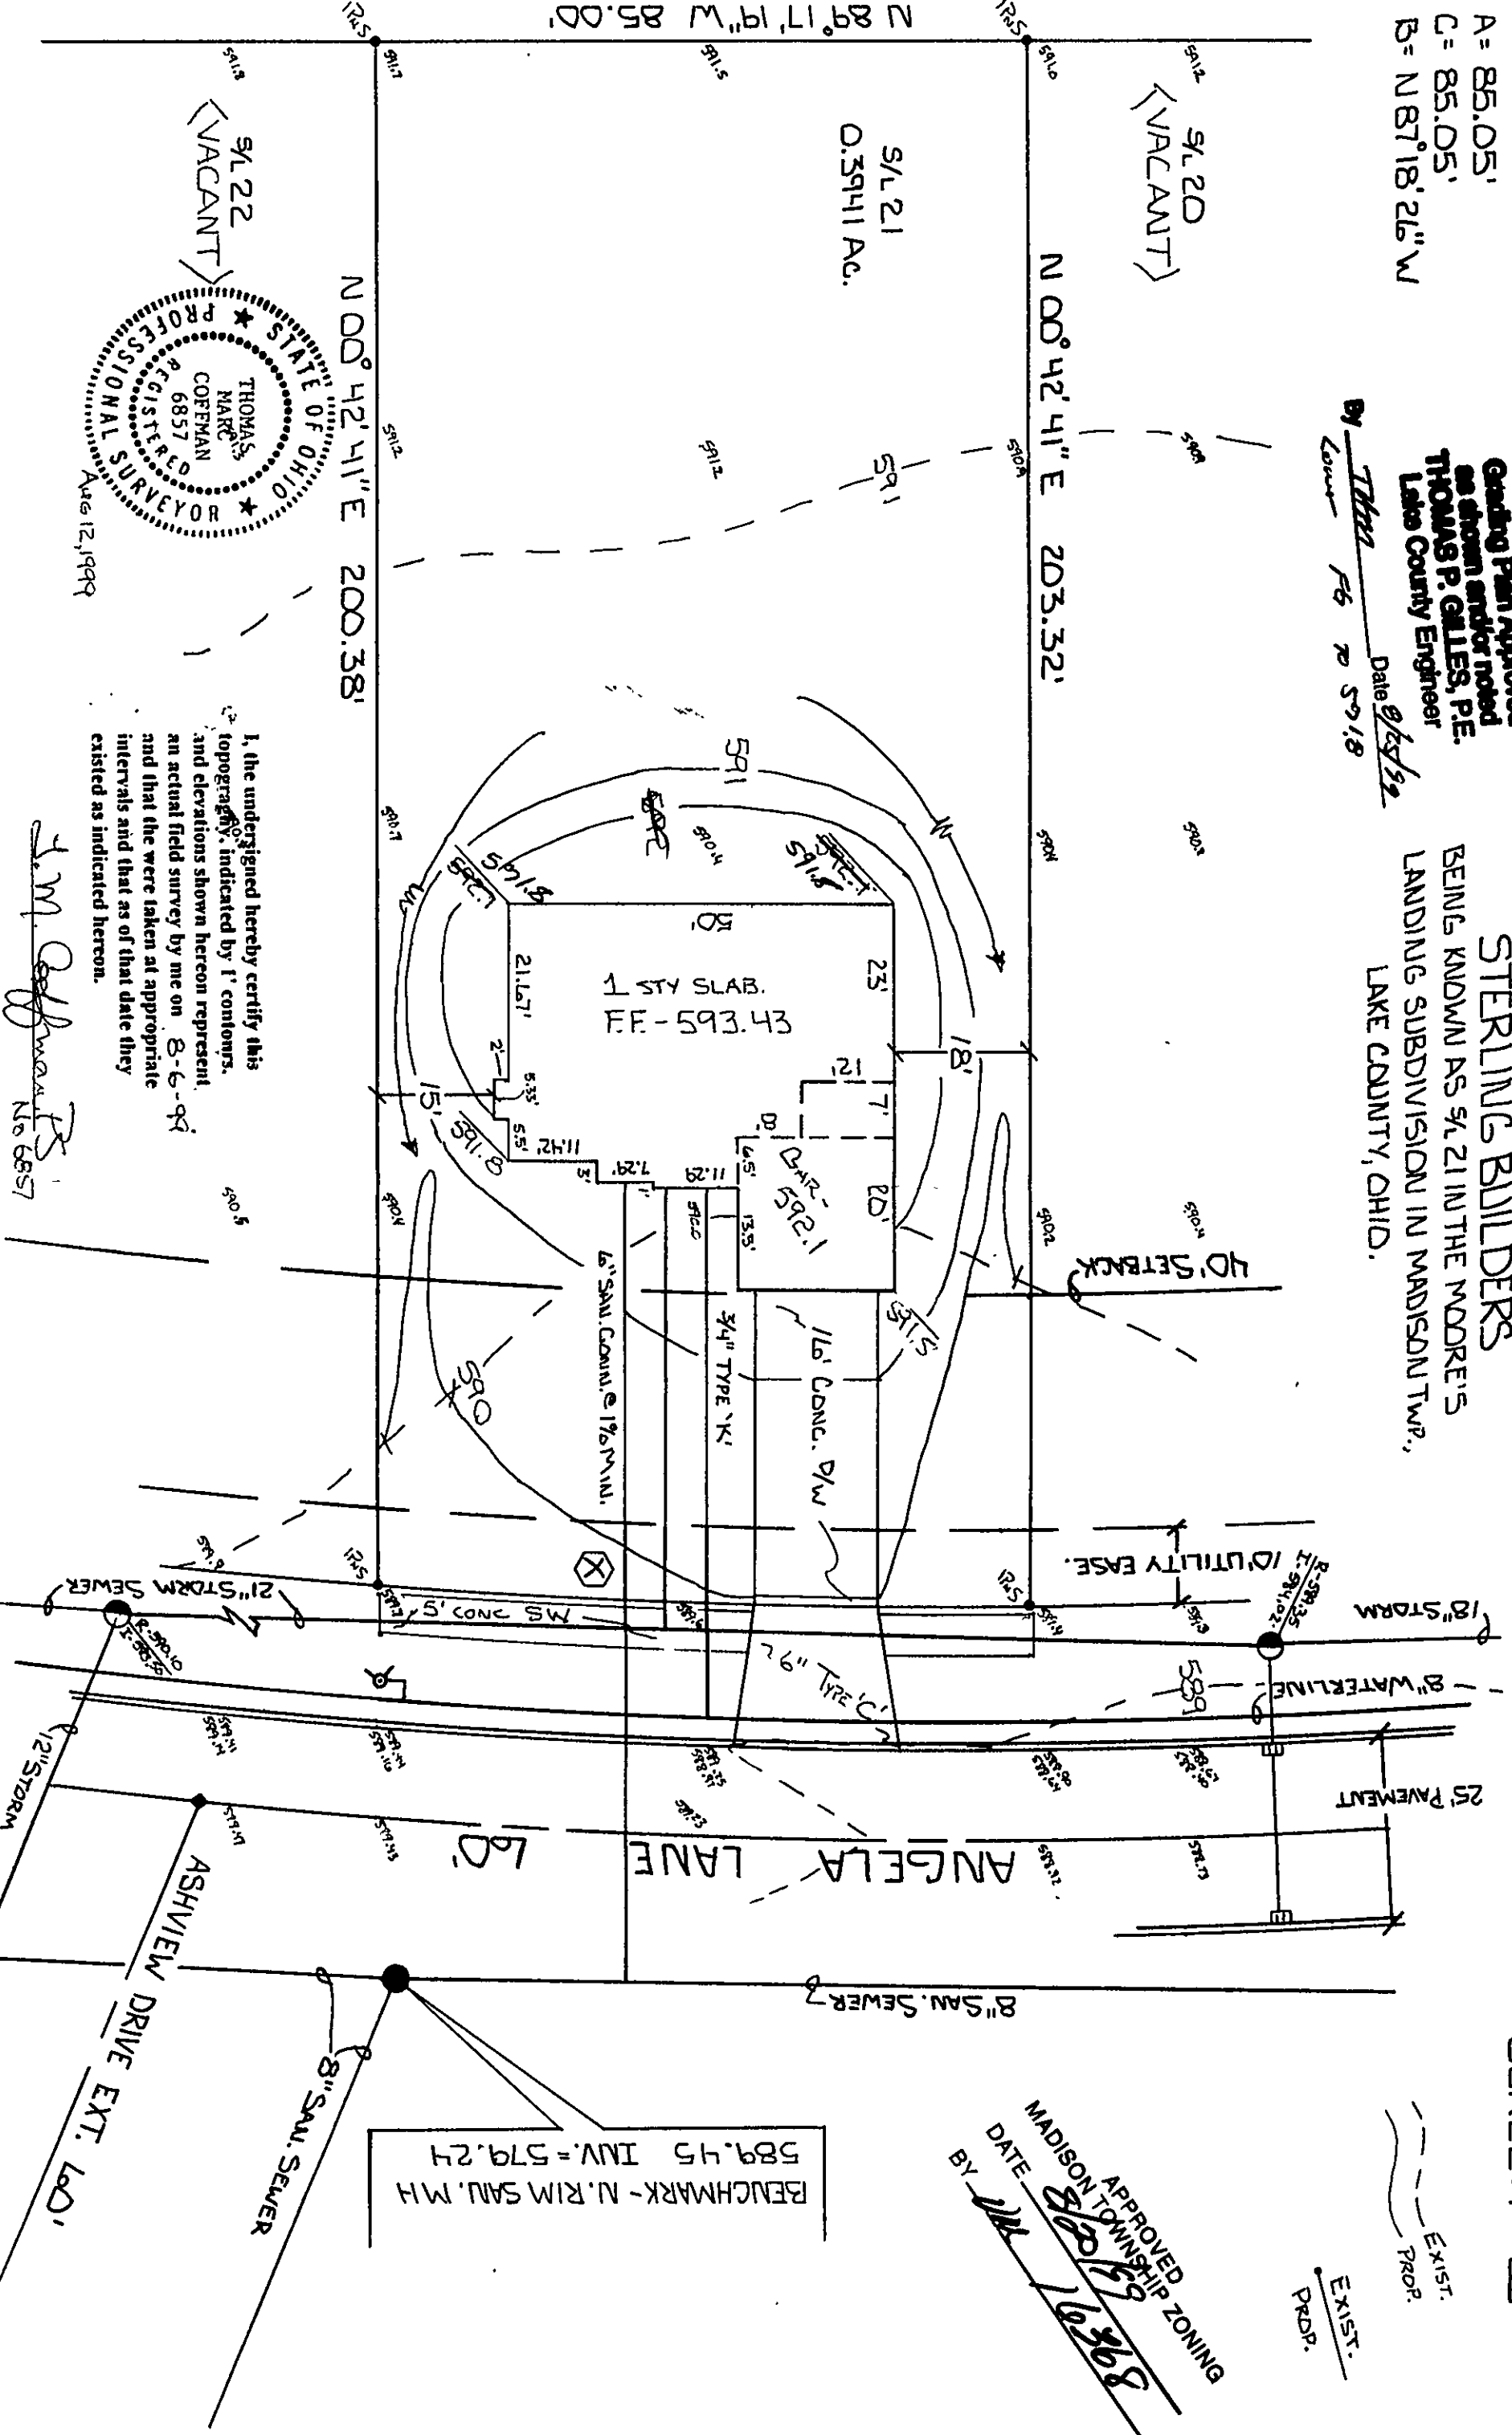

I, the undersigned hereby certify this
topography, indicated by 'f' contours,
and elevations shown hereon represent
an actual field survey by me on 8-6-92
and that the were taken at appropriate
intervals and that as of that date they
existed as indicated hereon.

J.M. Coffman No 6857

