

REVISIONS	BY

Barrington

CONSULTING GROUP, INC.

9114 TYLER BLVD., MENTOR, OHIO 44060

PHONE 440.205.1260 FAX 440.205.1262


www.BarringtonCGL.com

STATE OF OHIO

DAVID W. NOVAK

5-7507

REGISTERED SURVEYOR

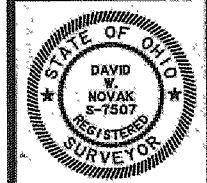

SITE PLAN

3325 AZALEA RIDGE DR. PERRY TWP. OHIO 44081

SIL 17 AZALEA RIDGE SUBDIVISION VPL 52 PG. 25

W. R. DAWSON CONSTRUCTION, LLC.

DRAWN WSO

CHECKED DWN


DATE MAY 20, 2014

SCALE 1" = 20'

JOB NO. 13041-017

SHEET 2/3

13041-017

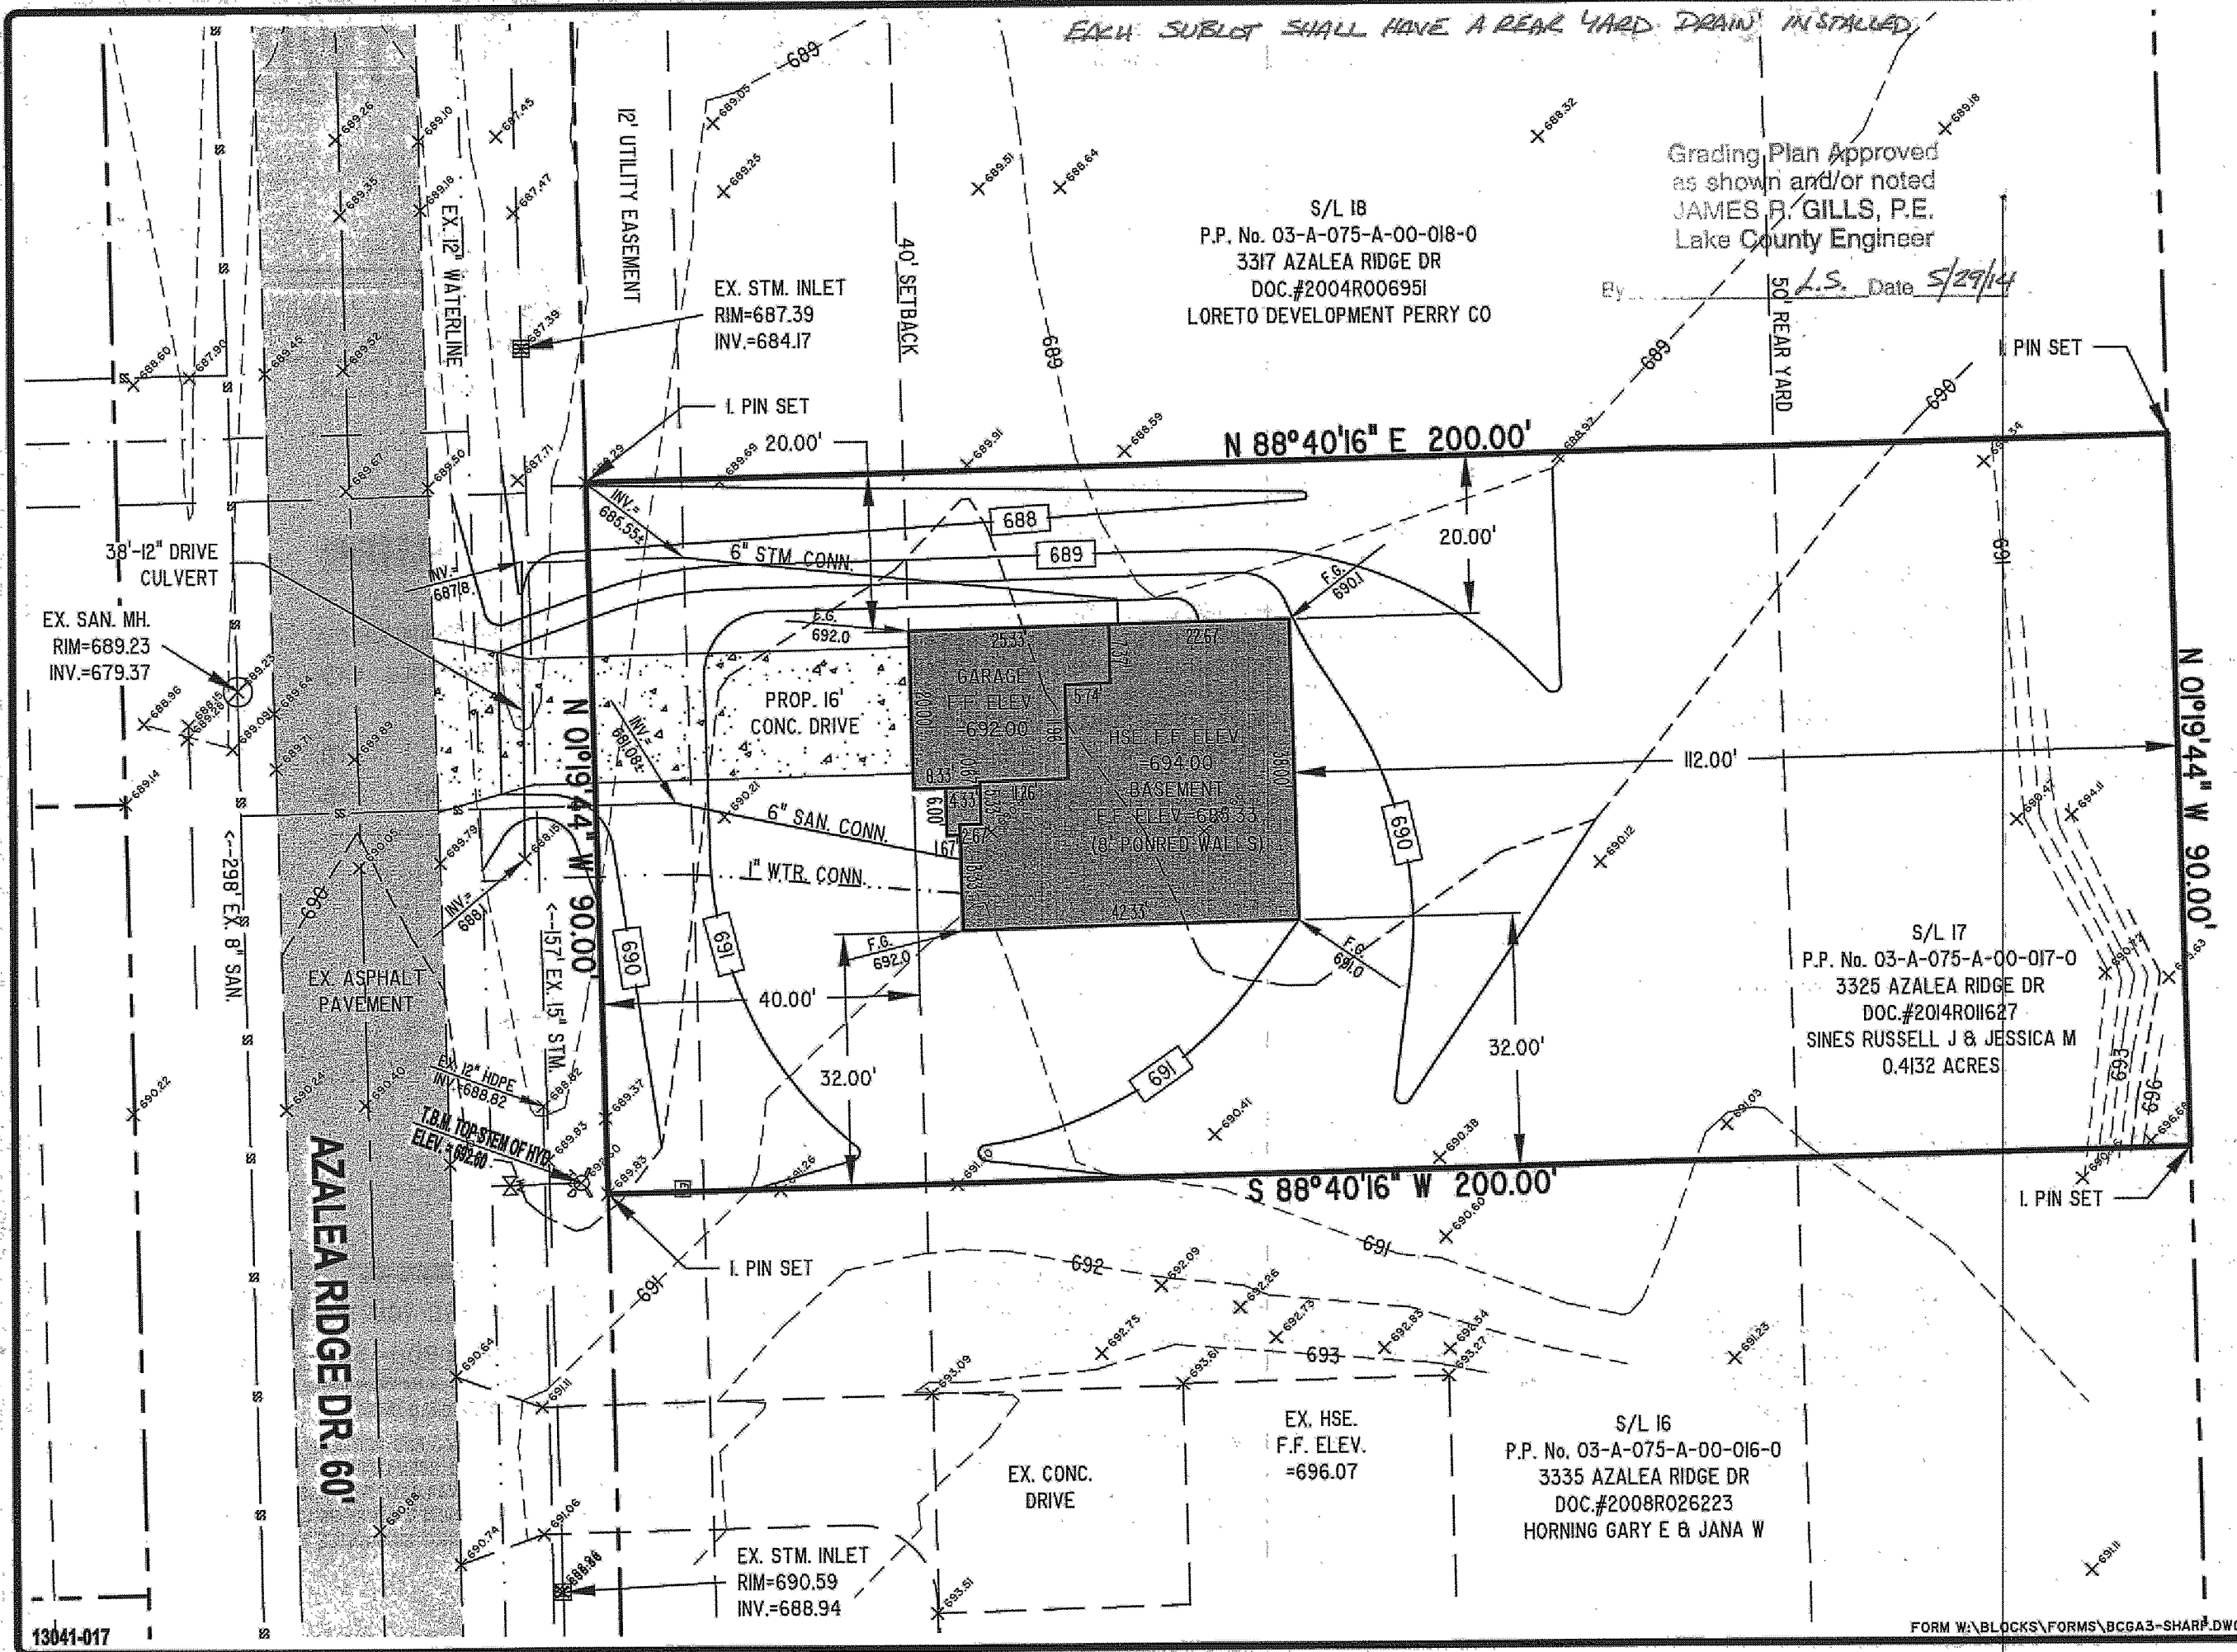

Barrington

CONSULTING GROUP, INC.

9114 TYLER BLVD., MENTOR, OHIO 44060

PHONE 440.205.1260 FAX 440.205.1262

www.BarringtonCGL.com

Civil Engineers - Surveyors - Land Planners

* SEE DECLARATION OF COVENANTS & RESTRICTIONS SECT. 19 YARD DRAIN

EACH SUBLET SHALL HAVE A REAR YARD DRAIN INSTALLED

S/L 18
P.P. No. 03-A-075-A-00-018-0
3317 AZALEA RIDGE DR
DOC.#2004R006951
LORETO DEVELOPMENT PERRY CO

Grading Plan Approved
as shown and/or noted
JAMES R. GILLS, P.E.
Lake County Engineer

By _____ L.S. Date 5/29/14

S/L 17
P.P. No. 03-A-075-A-00-017-0
3325 AZALEA RIDGE DR
DOC.#2014R011627
SINES RUSSELL J & JESSICA M
0.4132 ACRES

S/L 16
P.P. No. 03-A-075-A-00-016-0
3335 AZALEA RIDGE DR
DOC.#2008R026223
HORNING GARY E & JANA W