


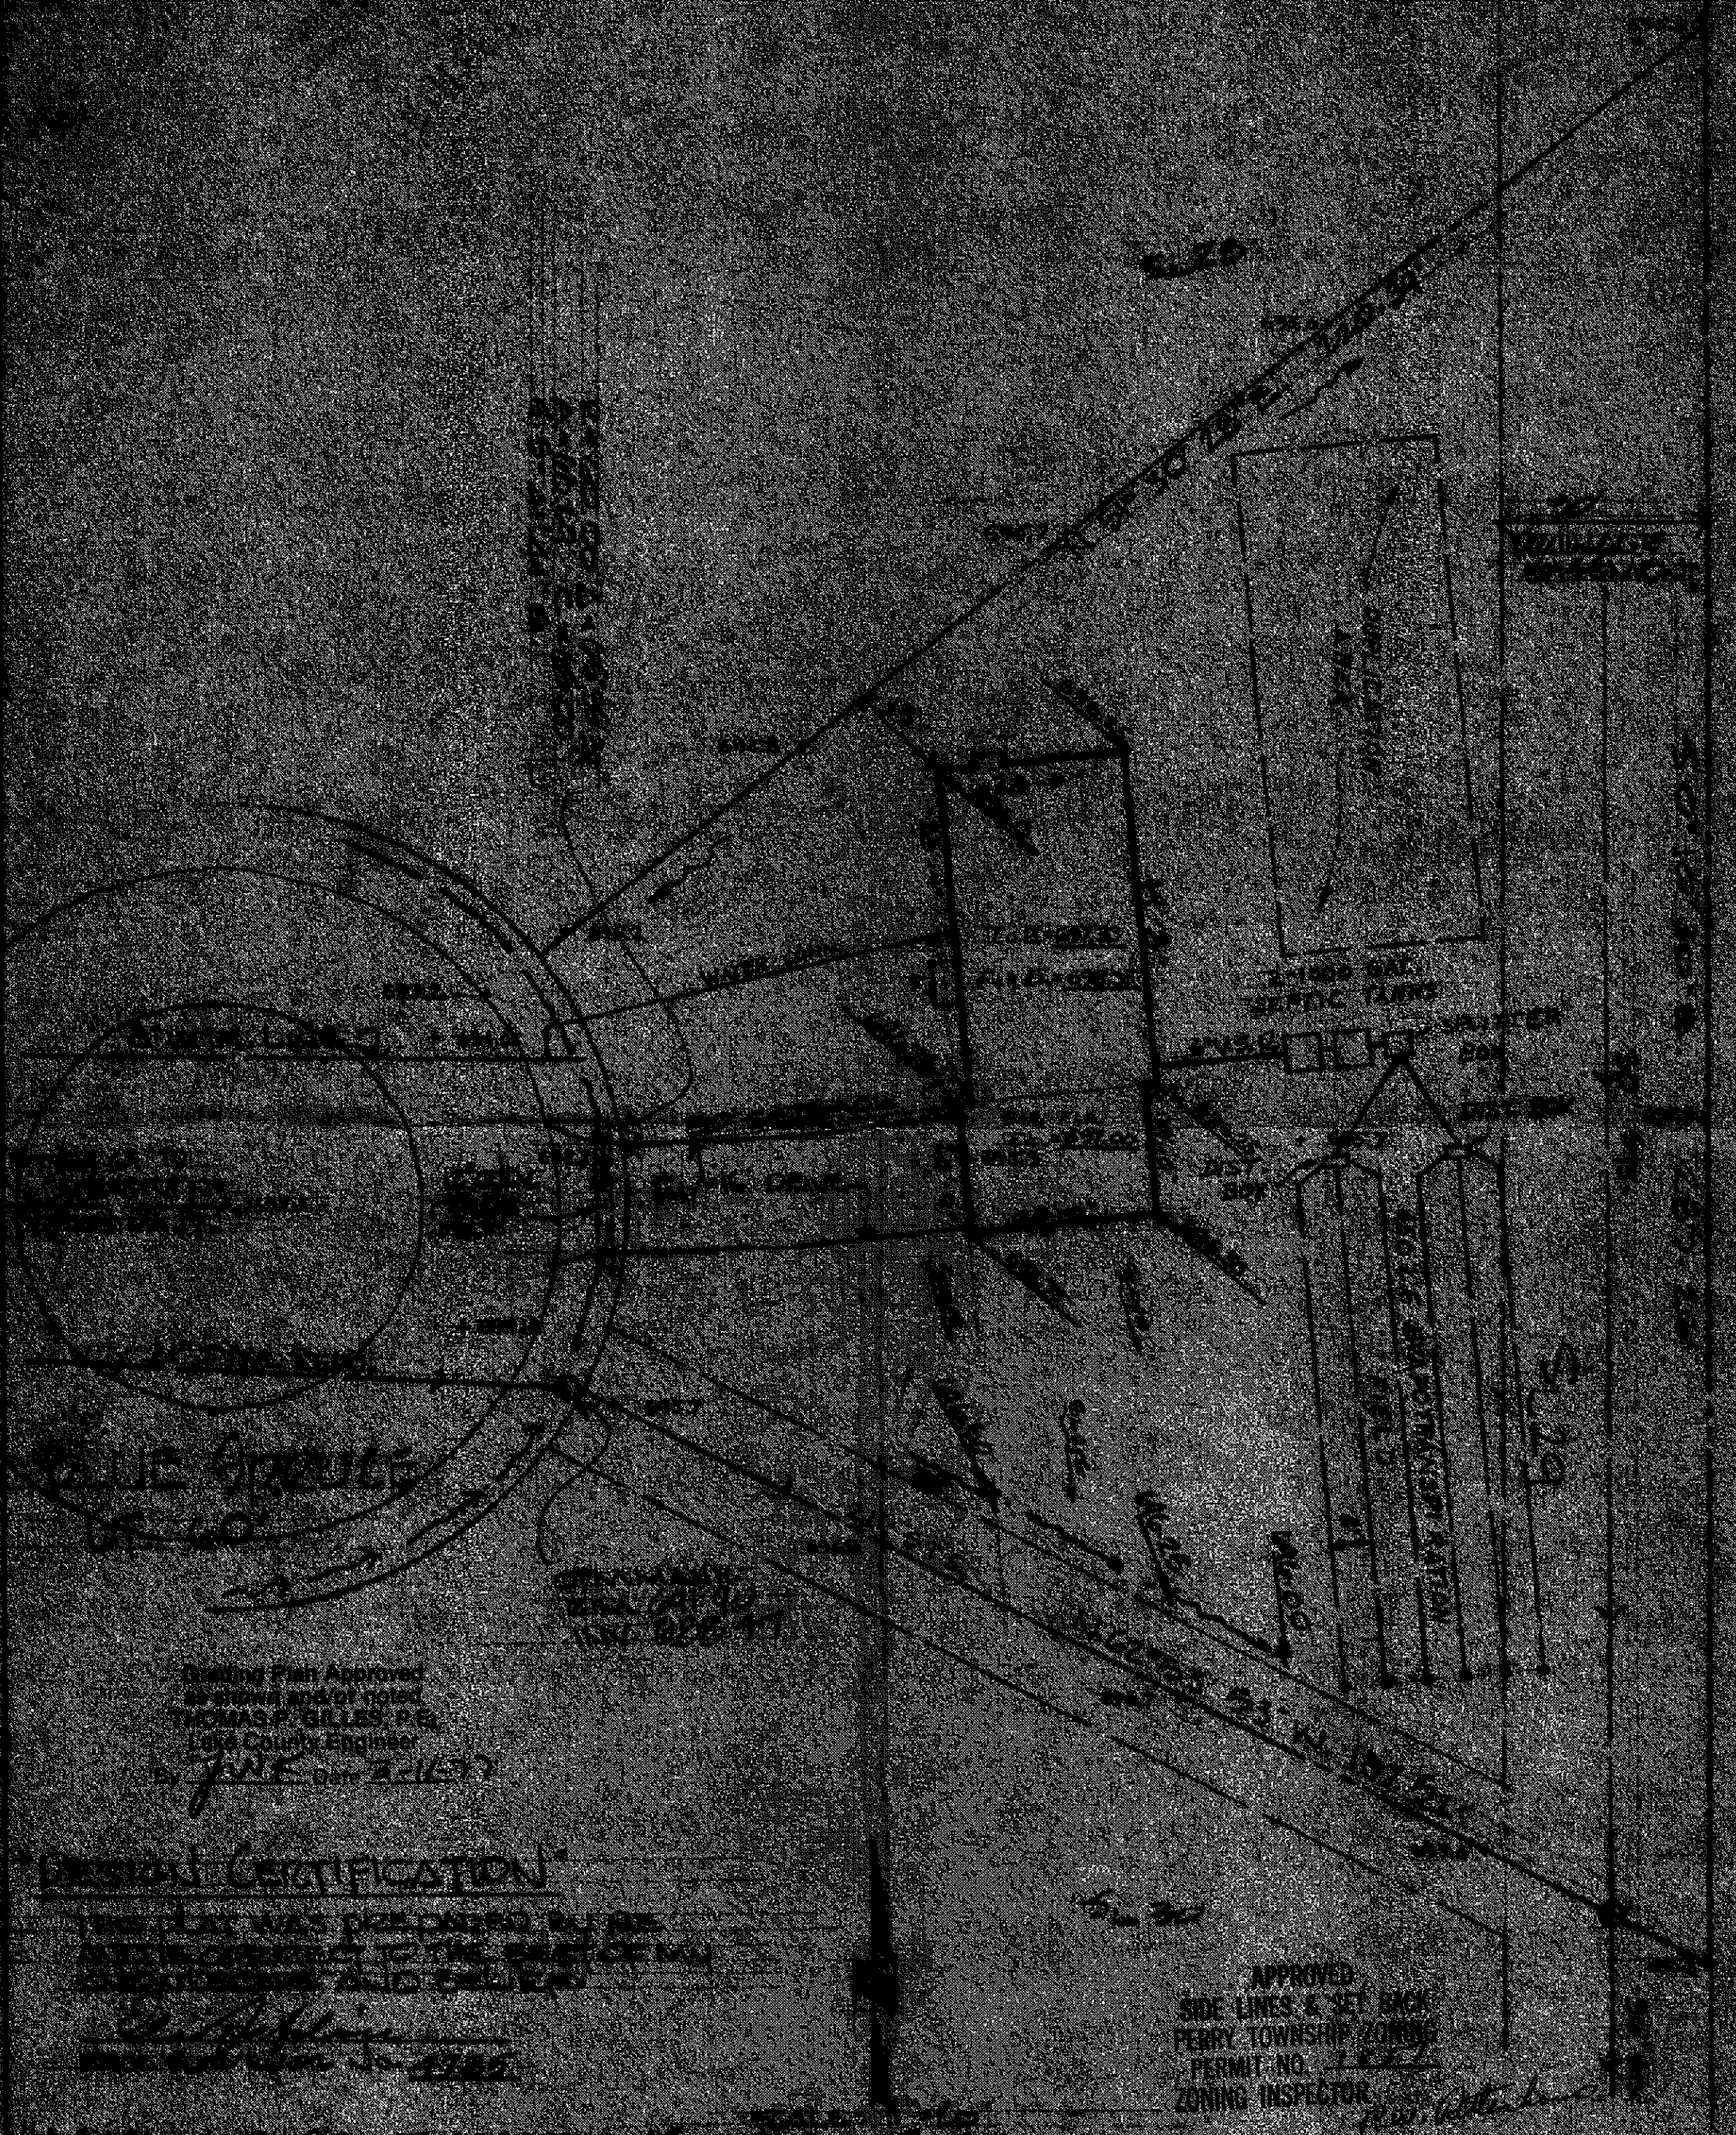

Drawing Plan Approved
 as shown and/or noted
 THOMAS P. GILES, P.E.
 Lake County Engineer
 By J.W.E. Date 2-11-77

DESIGN CERTIFICATION

This plan was prepared by me
 and is correct to the best of my
 knowledge and belief.

Thomas P. Giles
 Date 2-11-77

AS BUILT CERTIFICATION

I hereby certify that the above
 plan was built in accordance
 with the approved plan and
 is correct to the best of my
 knowledge and belief.

Thomas P. Giles
 Date 2-11-77

APPROVED
 SIDE LINES & SET BACK
 PERRY TOWNSHIP ZONING
 PERMIT NO. 7-2-77
 ZONING INSPECTOR

Ray W. Hume

See Drawing Enclosed