


SEWAGE DISPOSAL PERMIT MUST BE OBTAINED BY A LAKE COUNTY LICENSED INSTALLER BEFORE INSTALLATION IS STARTED.

Reviewed and Accepted
LAKE COUNTY GENERAL HEALTH DISTRICT
Date 8-13-86
JOEL LUCIA, R. S., M. P. H.
Health Commissioner
BY Dorell B. Morris

LOA FOR WATER
TREATMENT REQUIRED
GALL: _____
Shower head _____
Toilet _____

to be understood to be a permanent fixture
to be understood to be a permanent fixture
to be understood to be a permanent fixture

Grading Plan Approved
as shown and after tested
THOMAS P. GALLER, P.E.
Lake County Engineer
Date 8-25-86

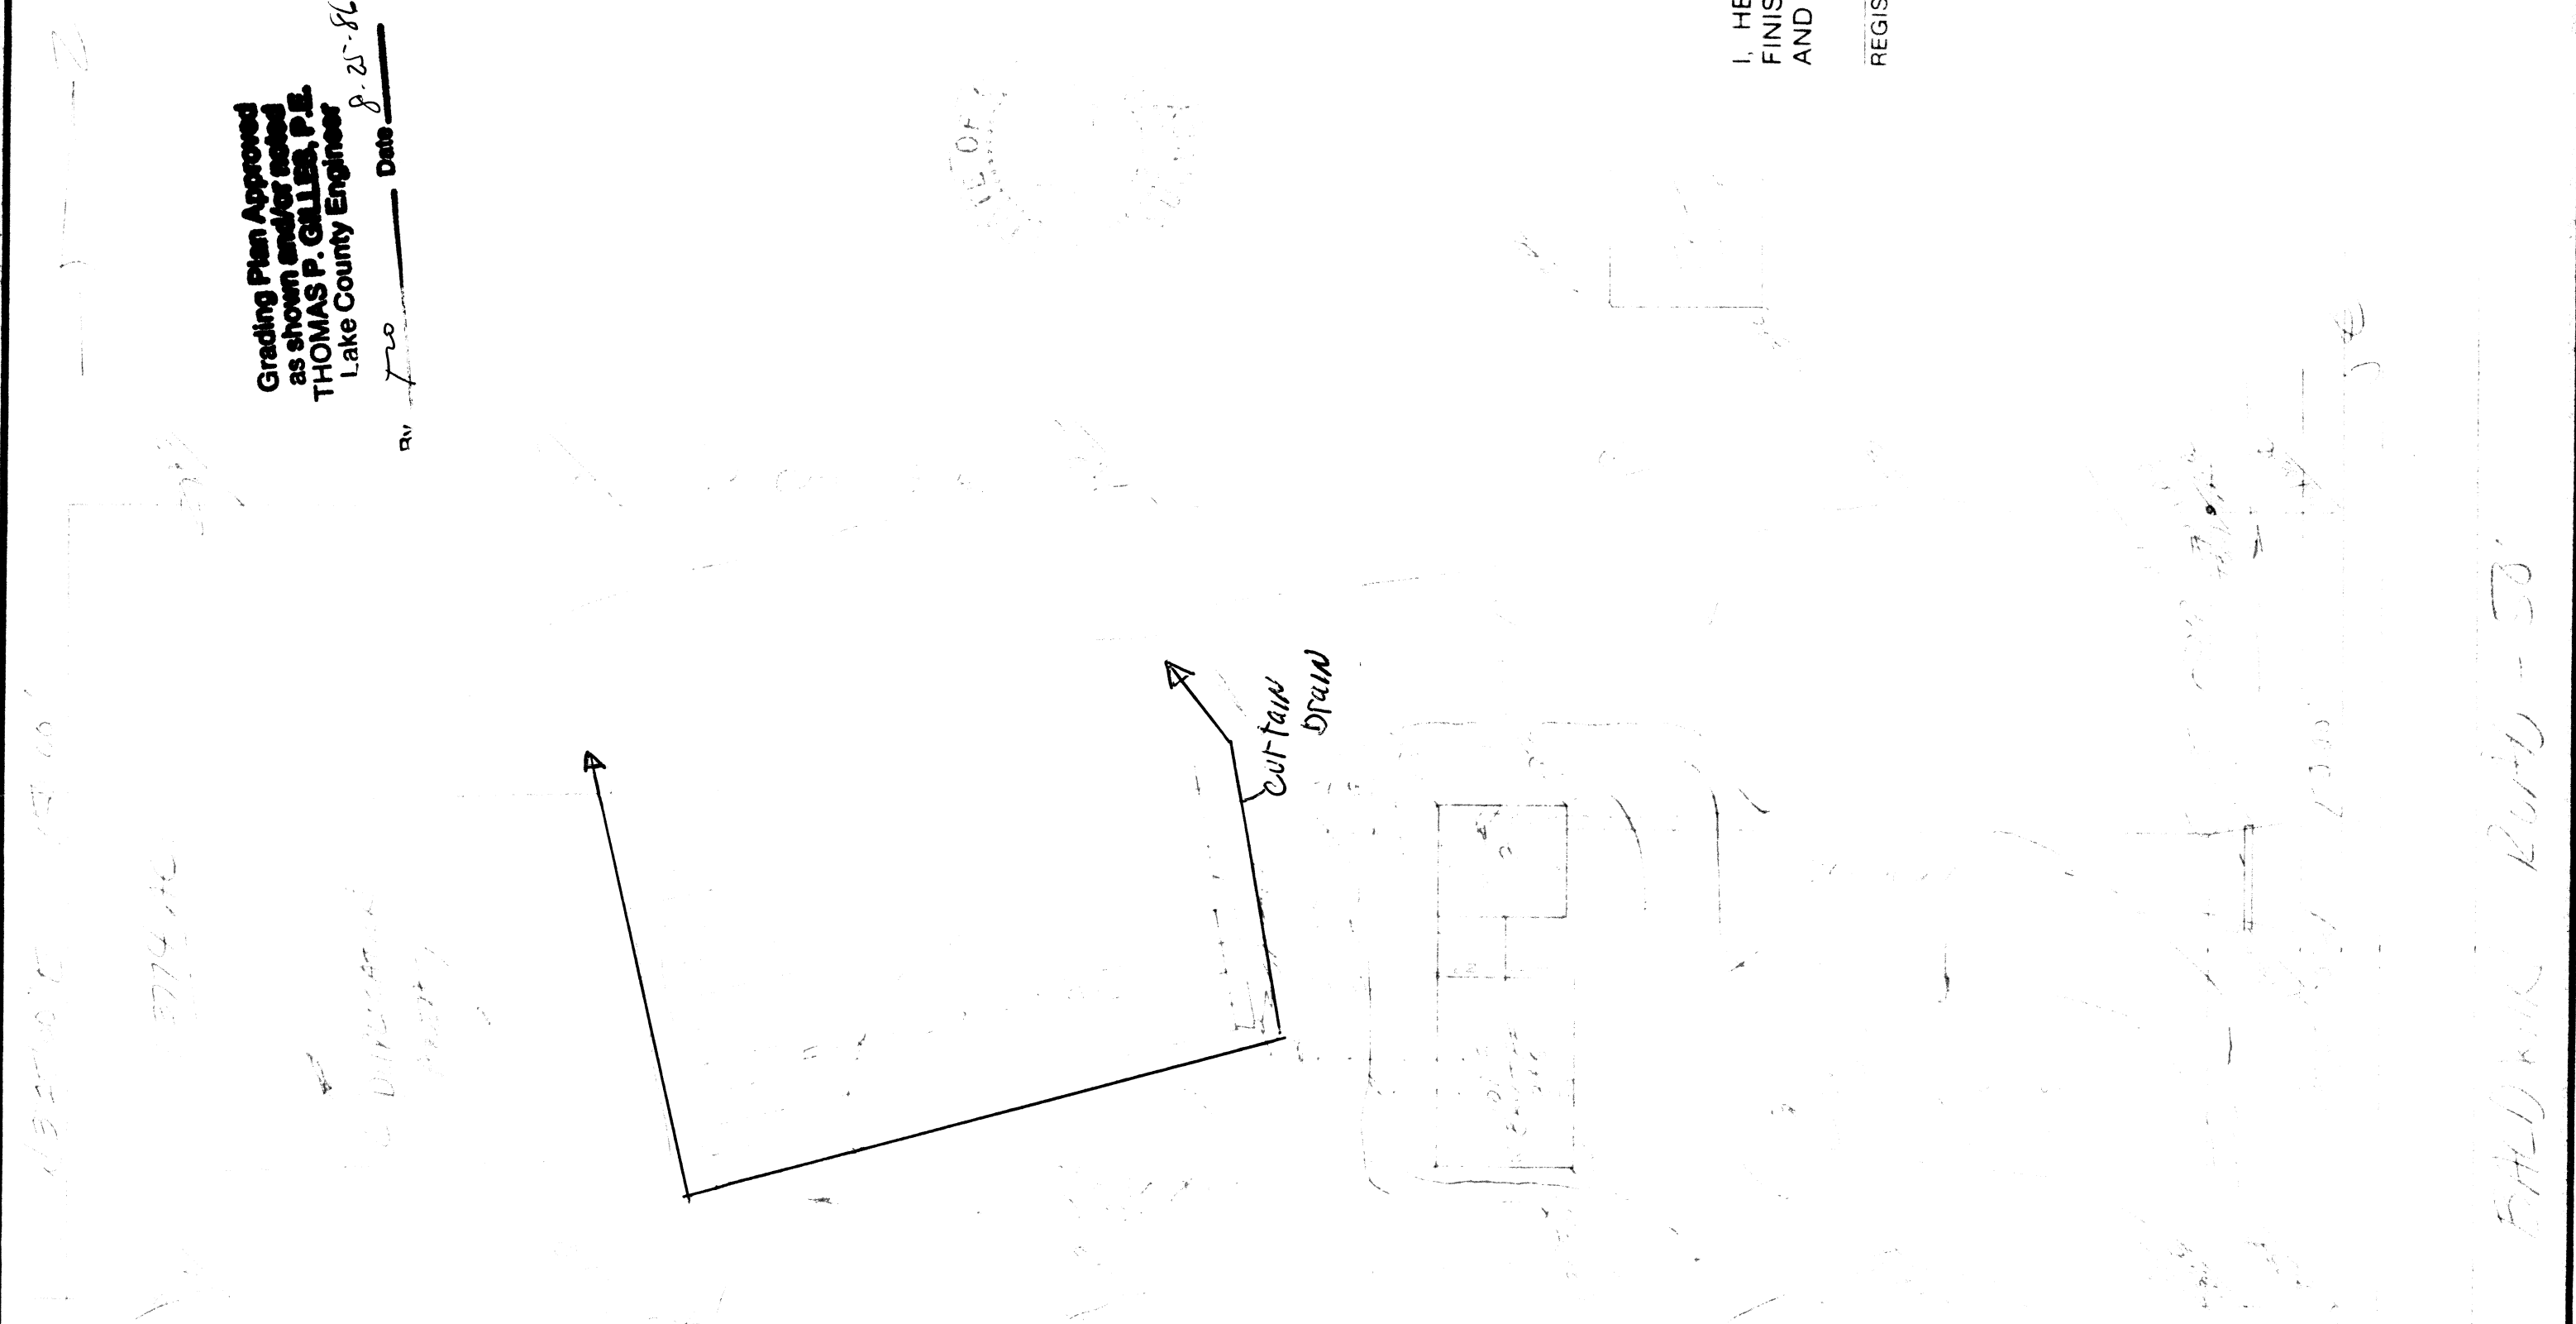

SITE PLAN

for: Client OWNER ADDRESS STREET CITY ZIP

SUBDIVISION VOL. - PG. NAME STREET LOT TRACT VOLUME PAGE PERM. PARCEL NO. STREET

LEGEND
SANITARY MANHOLE
STORM MANHOLE
INLET OR CATCH BASIN
HYDRANT
EXISTING CONTOURS
PROPOSED CONTOURS
EXIST. ELEV. 100.0 PROP. ELEV. 100.0
WATER VALVE (GAS)
WATER METER (GAS)
AS BUILT ELEVATION
INDICATES DIRECTION OF SURFACE DRAINAGE

REMARKS
ALL BOUNDARY DATA SHOWN WAS OBTAINED FROM (DEEDS, RECORDED SUBDIVISION PLAT OR OTHER PUBLIC RECORDS)
LOCATIONS AS SHOWN OF ADJACENT WELLS AND SEPTIC TANKS OBTAINED FROM LAKE COUNTY HEALTH DEPARTMENT

DESIGN CERTIFICATION
THIS PLAT WAS PREPARED BY ME, AND IS CORRECT TO THE BEST OF MY KNOWLEDGE AND BELIEF.

CHECK LIST
NAME SURVEYOR REGISTRATION NO.
NO. OF BEDROOMS
DIMENSIONS
REARINGS
TIE TO NEAREST STREET
SUBLOT NO. PARCEL NO.
SURROUNDING OWNERS
BLDG. DIMENSIONS FIN. GR.
BLDG. TIES TO GRADES
APRON TYPE WIDTH THICKNESS
SIDEWALK TYPE WIDTH THICKNESS
CULVERT TYPE DIAL LENGTH
ROCK OUTCROPPINGS
WATER MAIN SIZE LOCATION
SAN. SEWER SIZE % GR. LOC.
SAN. MH. CAST ELEV. INV. ELEV.
SAN. CONN. SIZE LOC. DEPTH
STORM SEWER SIZE % GR. LOC.
STORM MH. CAST ELEV. INV. ELEV.
PAV'T TYPE GRADE CURVES
GAS LINE LOC. SIZE PRESSURE
SEPTIC TANK LOCATION & DUPLICATION AREA
WELL LOCATION
ISOLATION RADIUS FROM WELL

PLAN PREPARED BY:
BABCOCK • JONES & ASSOCIATES, INC.
PAINESVILLE, OHIO
REVISIONS
NO. DATE BY
1
2
3
4
5
DRAWN BY SCALE 1" = 30' PHONE NO. 357-1811
CHK'D. DATE DRAWING NO.
CREW CHIEF APP'D.

"AS BUILT" CERTIFICATION
I, HEREBY CERTIFY THAT THE CIRCLED GRADES ARE EXISTING FINISH GRADES CHECKED IN THE FIELD ON 19 AND ARE CORRECT TO THE BEST OF MY KNOWLEDGE AND BELIEF.

REGISTERED SURVEYOR REG NO.

APPROVED
SIDE LINES & SET BACKS
PERMIT TO BE ISSUED
TO BE USED FOR RECORD
JULIO G. TORRES