
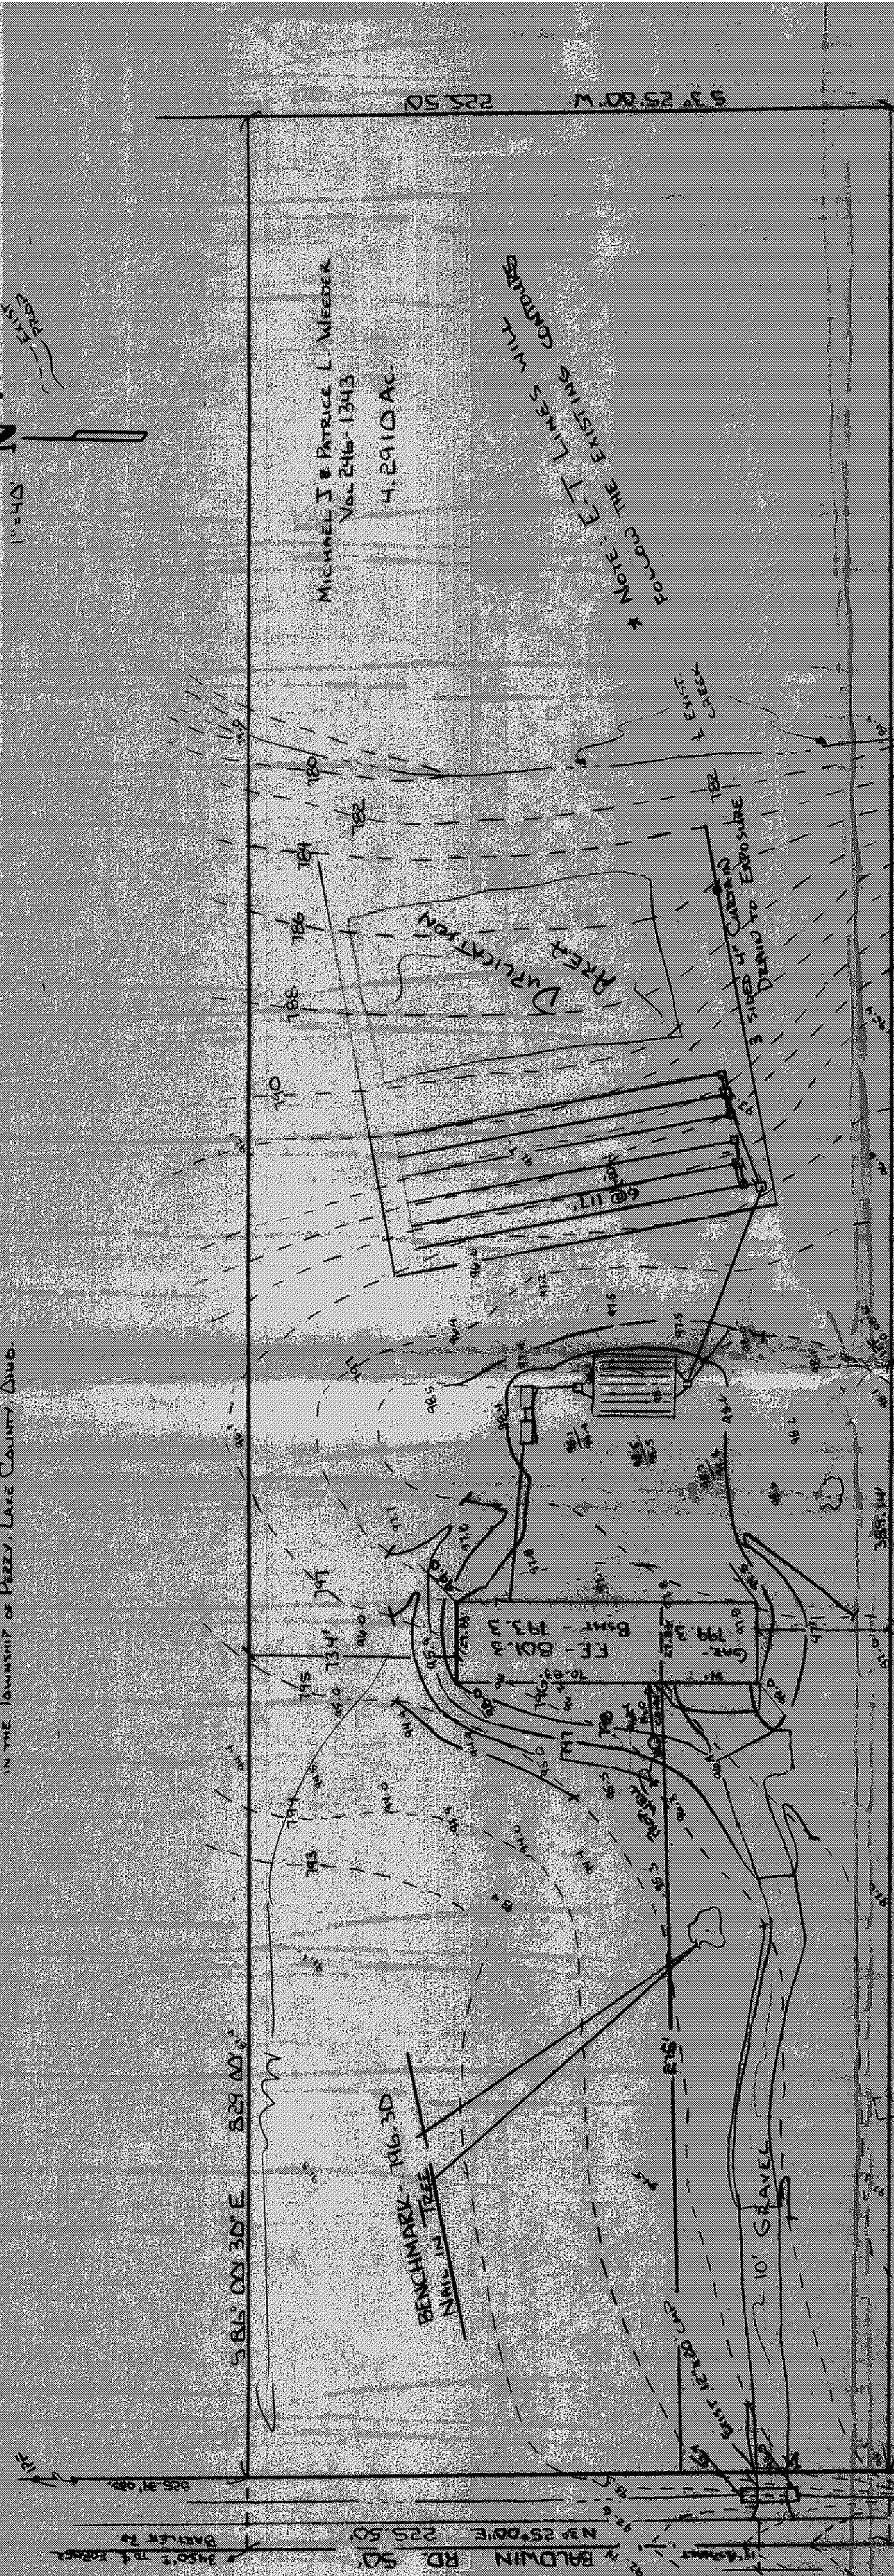


FOR SITE PLAN

MIKE WEEDER

BEING THE SOUTHERLY 225.50 FEET OF
SURREY No. 11, PERRY ALLEN'S COUNTRY SUBD.
IN THE TOWNSHIP OF PERRY, LAKE COUNTY, IND.

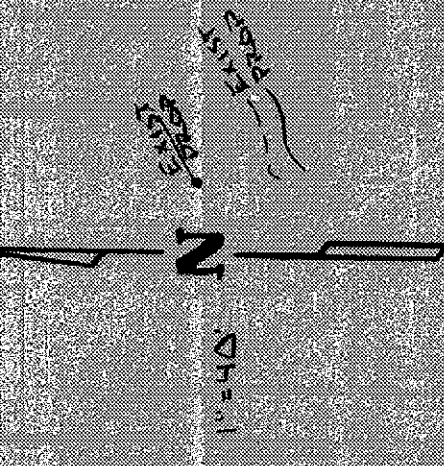


LOW YIELD WATER
FIXTURES REQUIRED
ON ALL:
Shower Head
Toilet

Reviewed and Accepted
LAKE COUNTY GENERAL HEALTH DISTRICT
Date 12-1-92
JOEL LUCHA, R.S., M.P.H.
Health Commissioner
BY N. NUNNO

HYDRAULIC PROFILE
VERT. 1" = 3' HORIZ. 1" = 50'
4 BEDROOM HOME
10' GRAVEL
3' SIDWALK
3' SIDWALK

FF-801.3

TO BE BUILT
10' GRAVEL
3' SIDWALK
3' SIDWALK

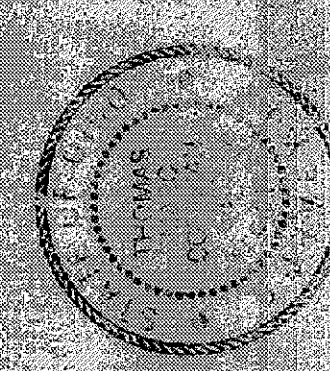

- A. To be brought to finished grade
1. Septic tank manhole covers
 2. Splitter box cover
 3. Distribution box cover
- B. No footer drains or downspouts
to be discharged into septic tanks
- C. All waste water to be discharged
into septic tanks



SEWAGE DISPOSAL PERMIT MUST BE
OBTAINED BY A LAKE COUNTY LICENSED
INSTALLER BEFORE INSTALLATION IS
STARTED.

Grading Plan Approved
as shown and/or noted
THOMAS P. GILLES, P.E.
Lake County Engineer

BY GWH Date 12-1-92

APPROVED
SIDE LINES & SET BACK
PERRY TOWNSHIP ZONING
PERMIT NO. 12-1-92
ZONING INSPECTOR

VILLAGE SURVEYING CO.
202 Third St. Fairport Harb. Ct. 40077
(357-1359)

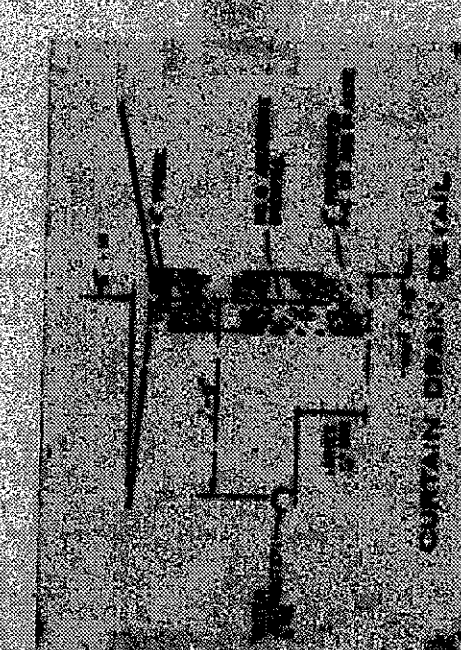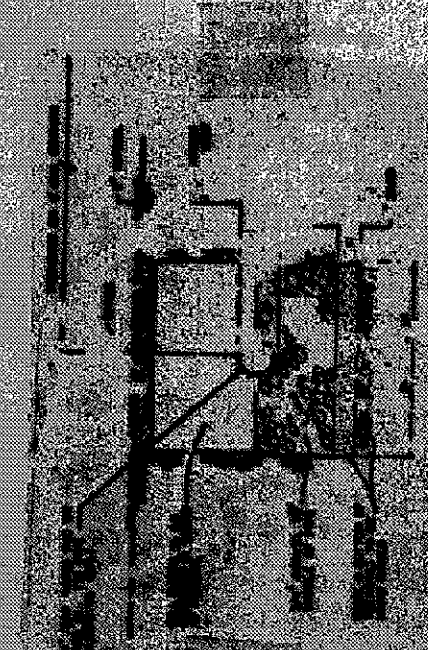

R.I. & P.M. LYNCH
Vol. 342-182