



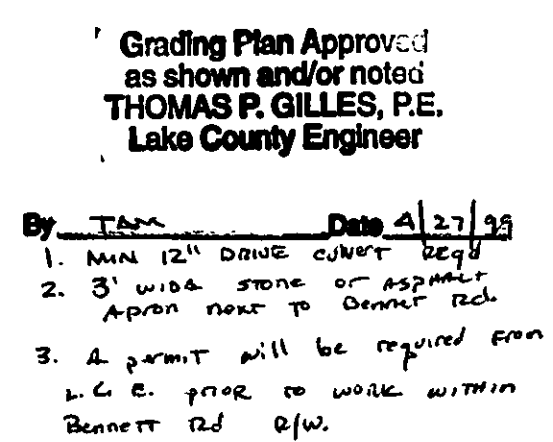

STATE OF OHIO
★
STAN R. LOCH
63332
REGISTERED
PROFESSIONAL ENGINEER ★

J R Lh 4-23-99
REG ENGINEER #63332

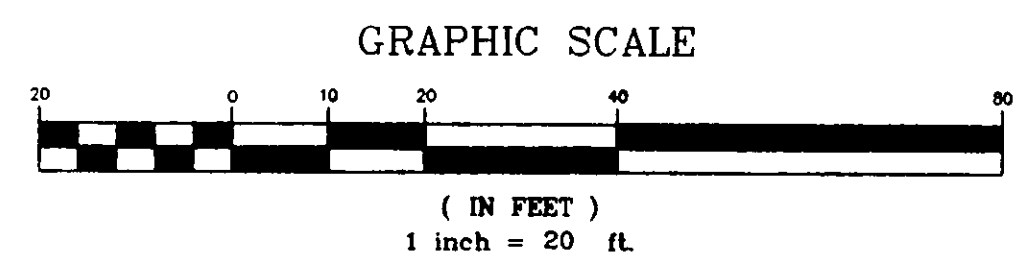

HORIZ. SCALE: 1" = 20'	VERT. SCALE:	 ENGINEERING and SURVEYING Civil Engineering · Land Surveying	5704 HERBLEY ROAD MENTOR OHIO 44060 440-639-9950	FAX 639-9790	APPROVED MADISON TOWNSHIP ZONING DATE <u>4/23/99</u> BY <u>KRK 10/15/94</u>							
DRAWN BY: KRK	DATE: 4/22/99											
CHECKED BY: SRL	DRAWING NO.: AZT-559											
JOB NO.: 99712	SHEET 1 OF 1											
							NO.	DATE	DESCRIPTION	BY		