

JOE KOZLOWSKI
BEING 9/10, WELLINGTON RIDGE ESTATES,
LOT NO. 34 IN THE TOWNSHIP OF PAINEVILLE
COUNTY OF LAKE, STATE OF OHIO




FSR

VILLAGE SURVEYING CO.
202 THIRD STREET, FAIRPORT HARBOR, OHIO 44077
(216) 357-1359



I, the undersigned hereby certify that
this topography, indicated by 1" = 30',
and elevations shown herein represent an
actual field survey made by me on 3-11-91
and that the elevations were taken at
appropriate intervals and that as of that
date they existed as indicated herein.

J M Gilles P.E.
No. 25921

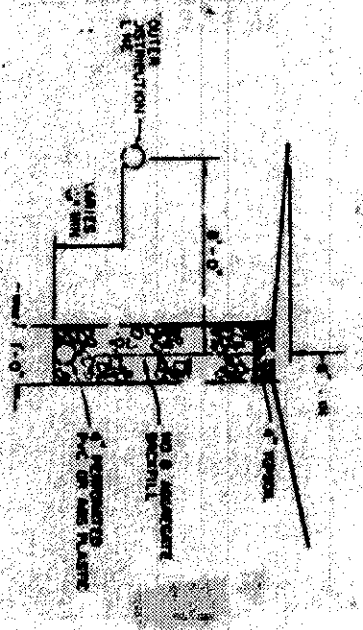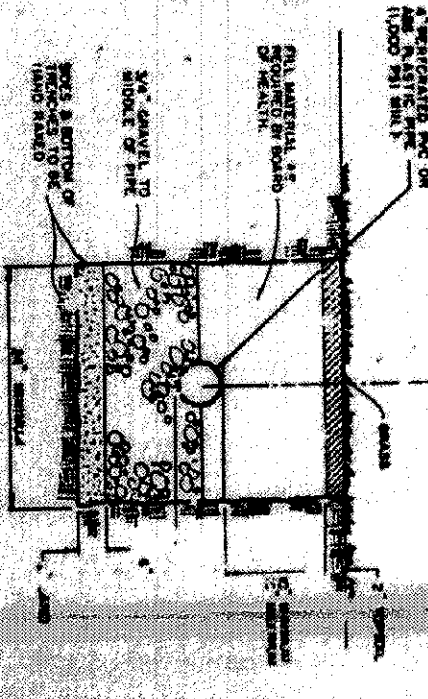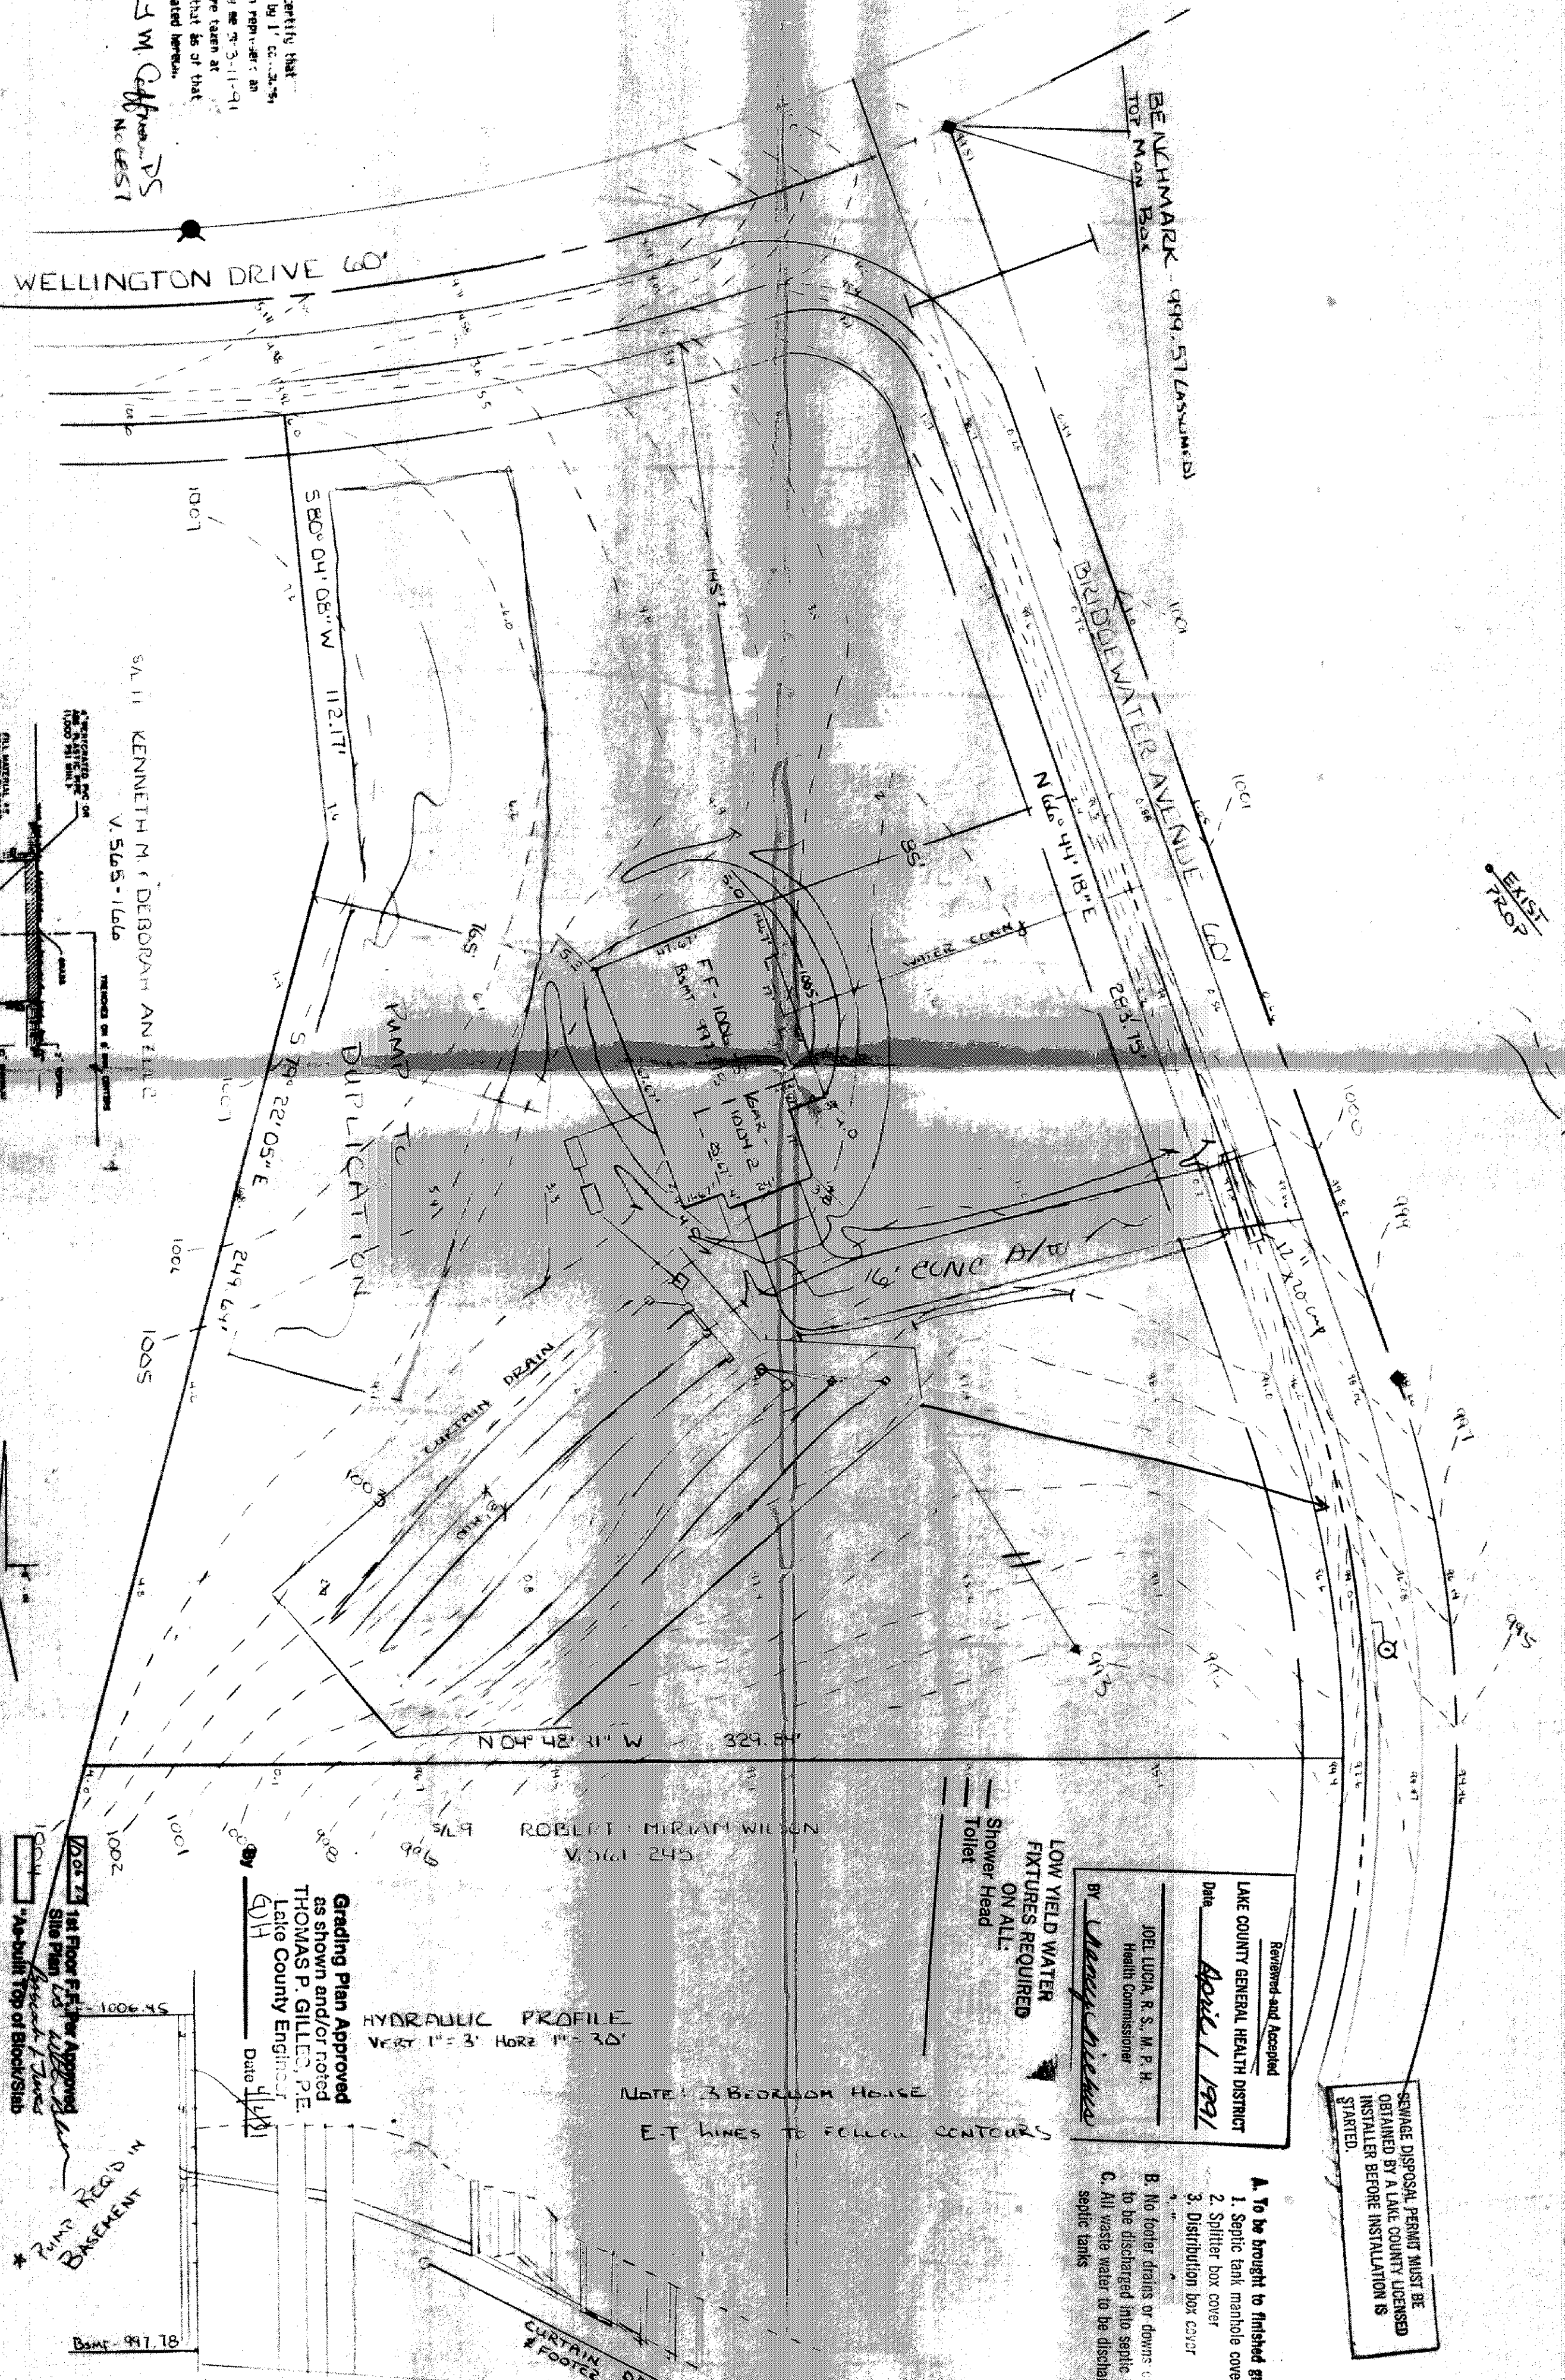

Grading Plan Approved
as shown and/or noted
THOMAS P. GILLES, P.E.
Lake County Engineer
Date 4/1/91

1st Floor F.F. Per "As-Built"
Site plan APPROVED
SIDE LINES & SET BACK
PERRY TOWNSHIP ZONING
PERMIT NO. 25921
ZONING INSPECTOR [Signature]

2nd Floor F.F. Per "As-Built"
Site plan APPROVED
SIDE LINES & SET BACK
PERRY TOWNSHIP ZONING
PERMIT NO. 25921
ZONING INSPECTOR [Signature]

2nd Floor F.F. Per "As-Built"
Site plan APPROVED
SIDE LINES & SET BACK
PERRY TOWNSHIP ZONING
PERMIT NO. 25921
ZONING INSPECTOR [Signature]

Reviewed and Accepted	
LAKE COUNTY GENERAL HEALTH DISTRICT	
Date	April 1, 1991
JOEL LUDIA, R.S., M.P.H. Health Commissioner	
By: [Signature]	

- A. To be brought to finished grade**
1. Septic tank manhole covers
 2. Splitter box cover
 3. Distribution box cover
- B. No footer drains or down cuts**
to be discharged into septic tanks
- C. All waste water to be discharged into**
septic tanks

SEWAGE DISPOSAL PERMIT MUST BE
OBTAINED BY A LAKE COUNTY LICENSED
INSTALLER BEFORE INSTALLATION IS
STARTED.

