

JIM PETER LAND SURVEY
4759 CROSBY - COOK RD
ROME, OHIO 44085

PARCEL NO. 1, LOT 53 PERRY
TOWNSHIP
LAKE COUNTY, OHIO


SITE PLAN
FOR
LEE LYDIC I

LEGEND:
— P PROPERTY LINE
--- 96-- EXISTING CONTOUR
--- 99-- PROPOSED CONTOUR

SCALE 1" = 20 ft
14 AUGUST 1991

APPROVED
SIDE LINES & SET BACK
PERRY TOWNSHIP ZONING
PERMIT NO. 4525
ZONING INSPECTOR *[Signature]*

Grading Plan Approved
as shown and/or noted
THOMAS P. GILLES, P.E.
Lake County Engineer
By *[Signature]* Date 8/12/91

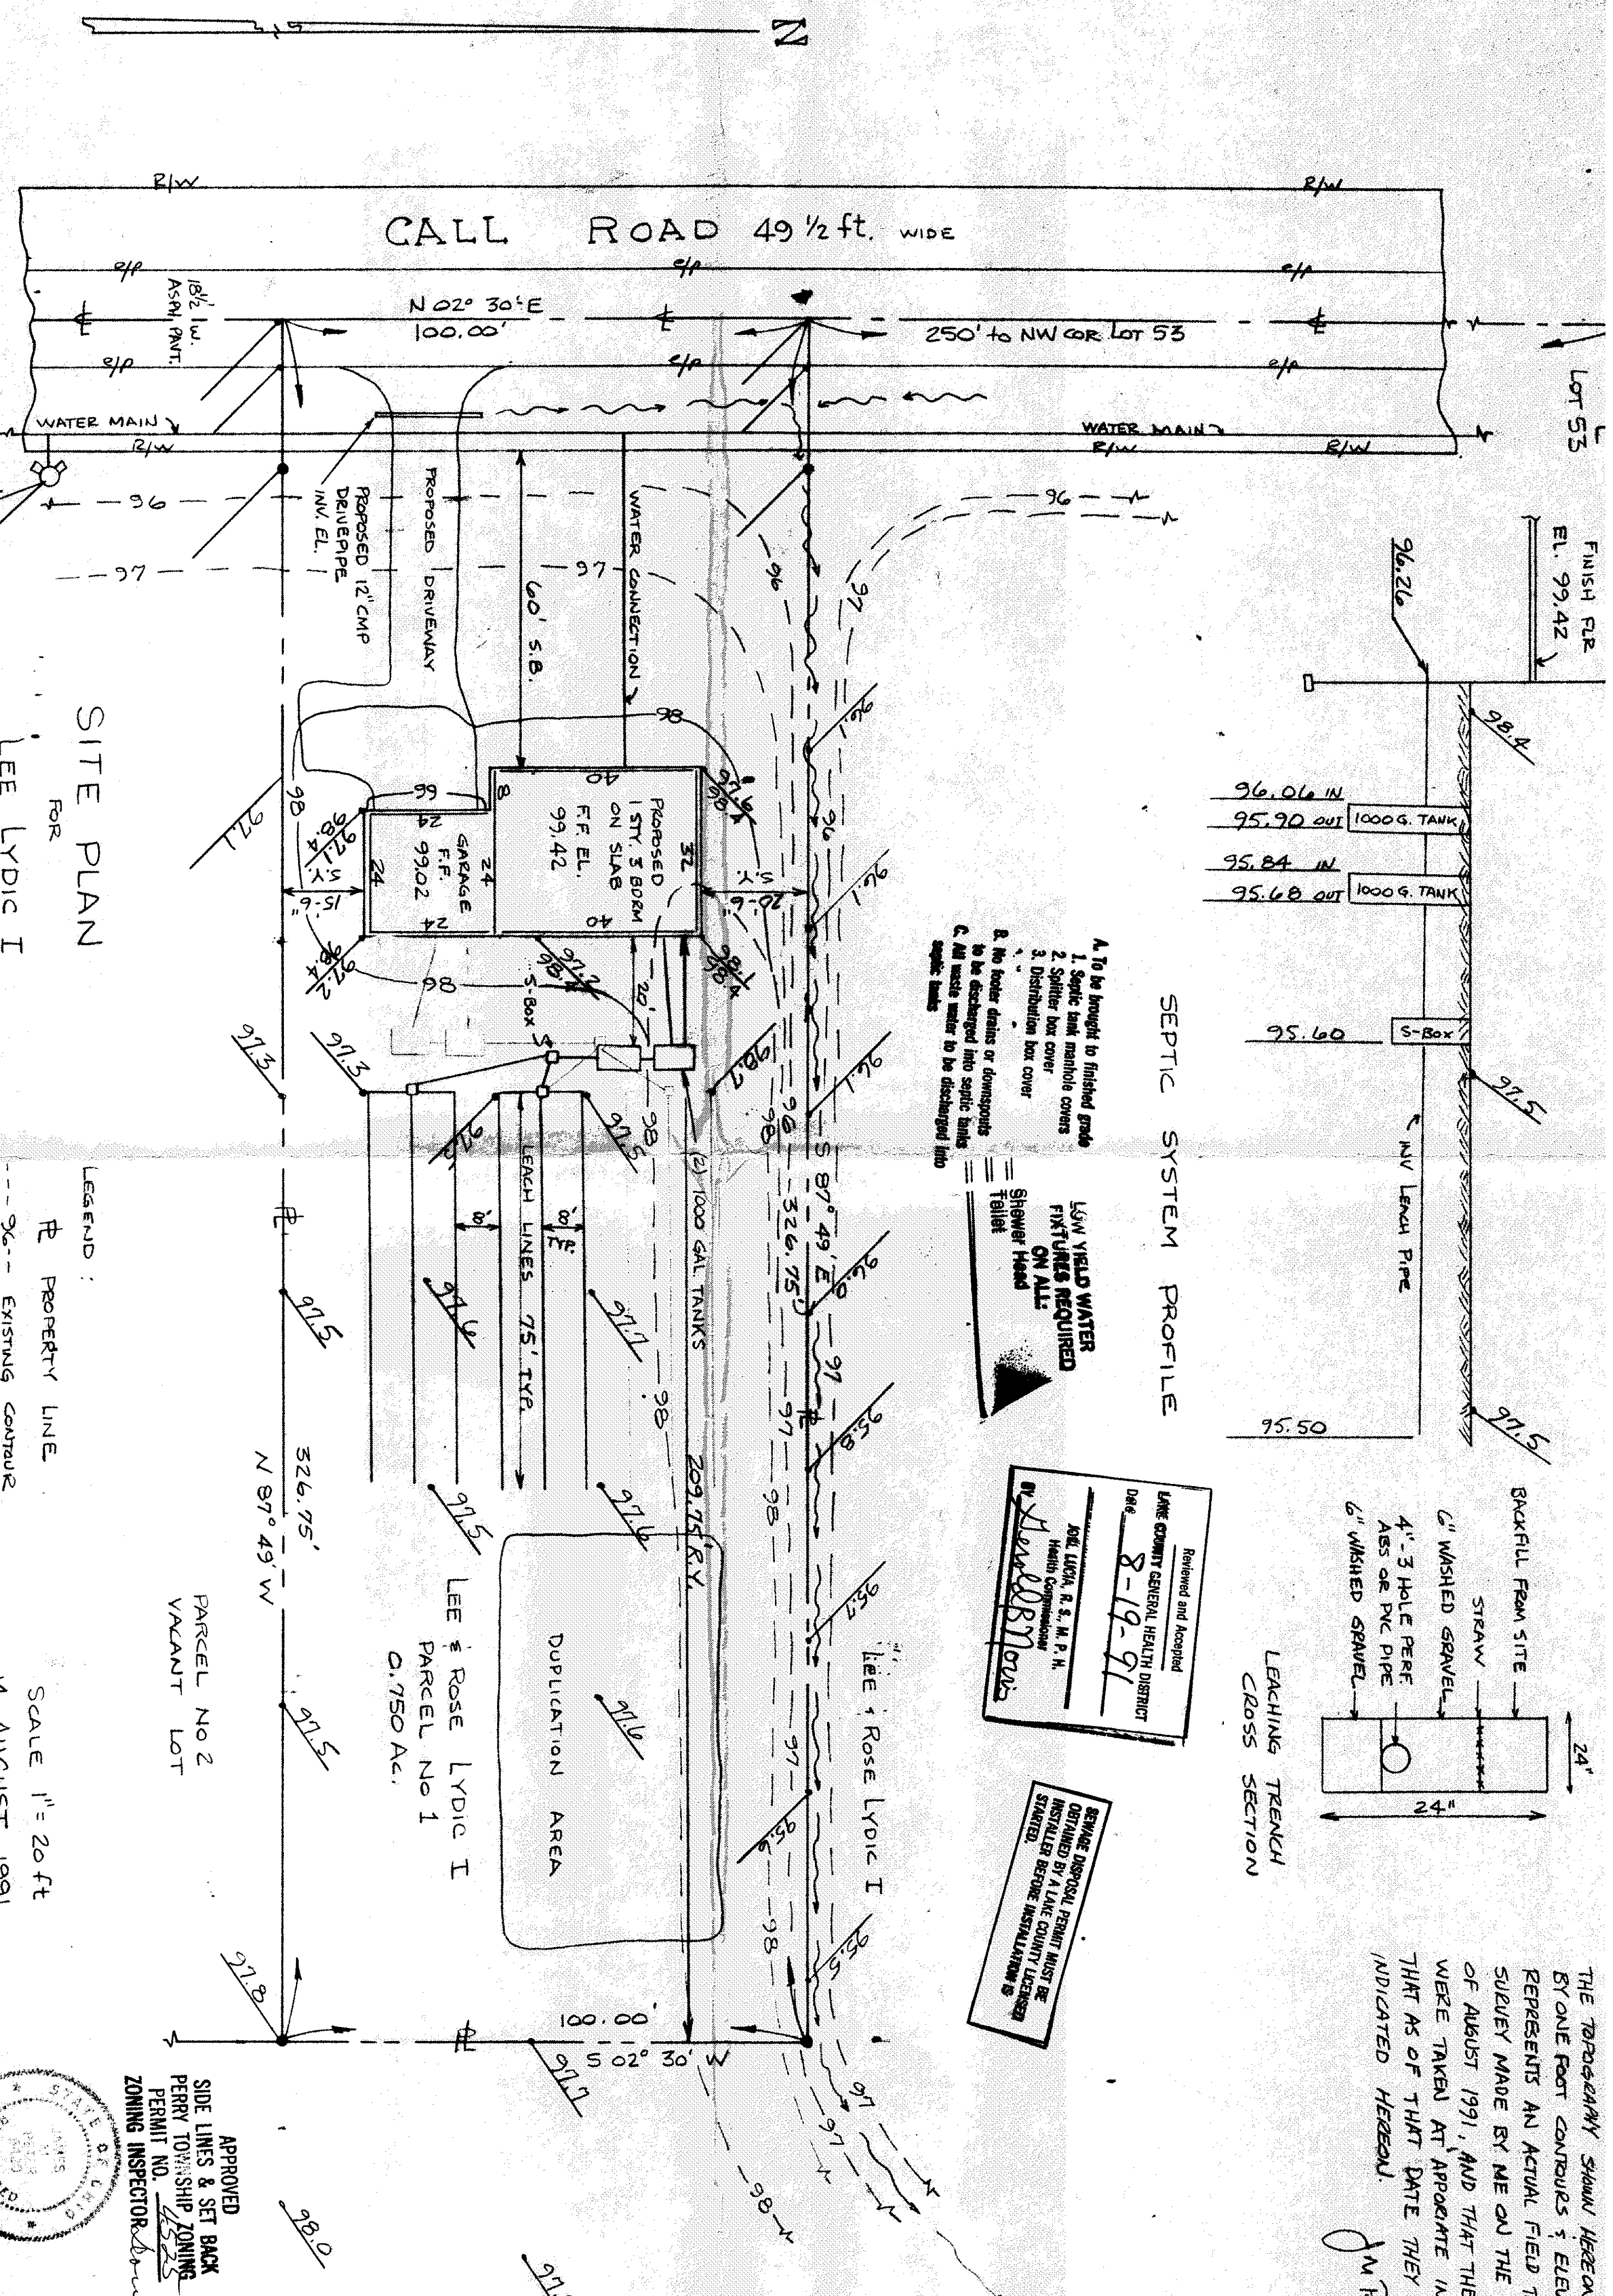

THE TOPOGRAPHY SHOWN HEREON INDICATED BY ONE FOOT CONTOURS & ELEVATIONS REPRESENTS AN ACTUAL FIELD TOPOGRAPHIC SURVEY MADE BY ME ON THE 12TH DAY OF AUGUST 1991, AND THAT THE ELEVATIONS WERE TAKEN AT APPROPRIATE INTERVALS & THAT AS OF THAT DATE THEY EXISTED AS INDICATED HEREON.

[Signature]