




I, THE UNDERSIGNED HEREBY CERTIFY THAT THE TOPOGRAPHY SHOWN HEREON, INDICATED BY ONE FOOT CONTOURS & ELEVATIONS REPRESENTS AN ACTUAL FIELD TOPOGRAPHIC SURVEY MADE BY ME ON THE 12TH DAY OF MARCH, 1991 AND THAT THE ELEVATIONS WERE TAKEN AT APPROPRIATE INTERVALS & THAT AS OF THAT DATE THEY EXISTED AS INDICATED HEREON.

jm 2/21

LEACHING TRENCH CROSS SECTION

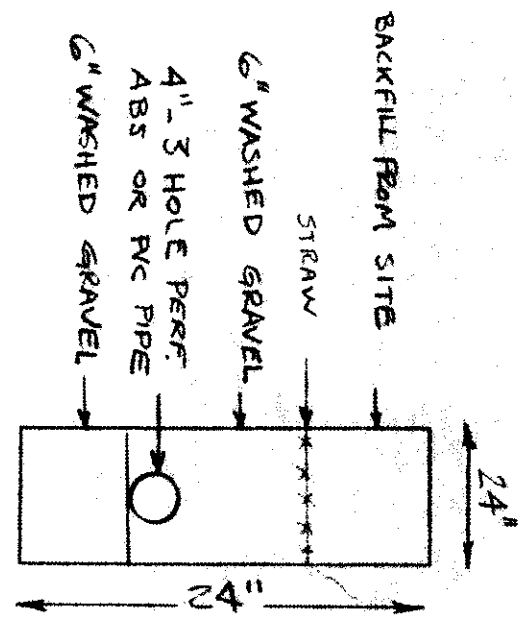

SEPTIC SYSTEM PROFILE

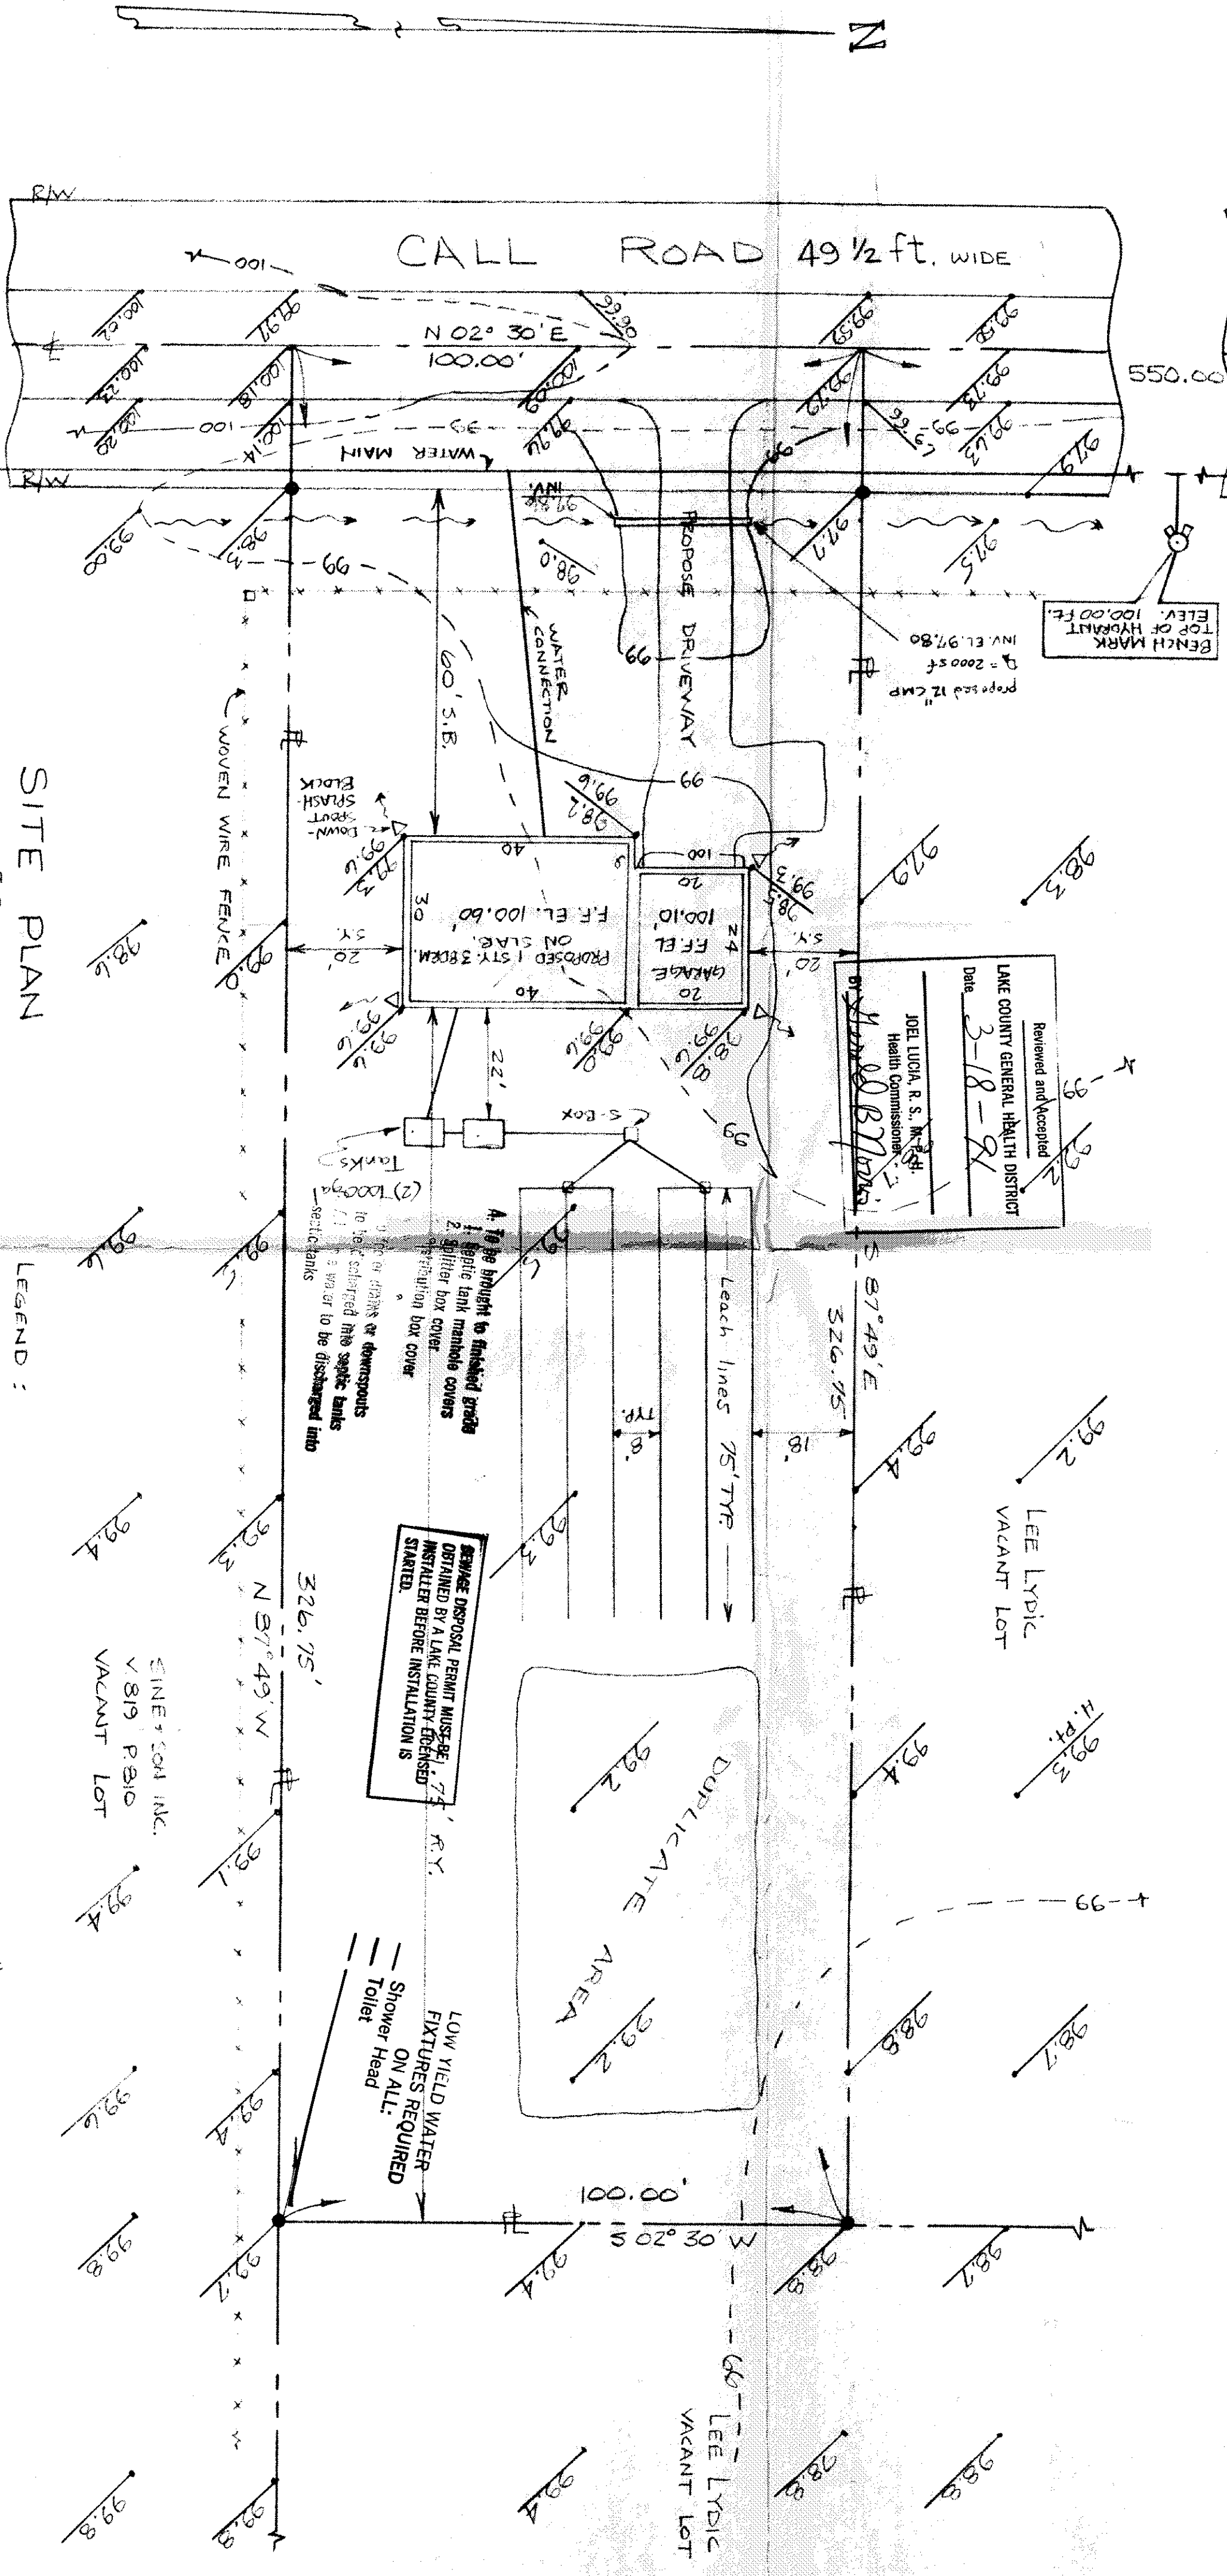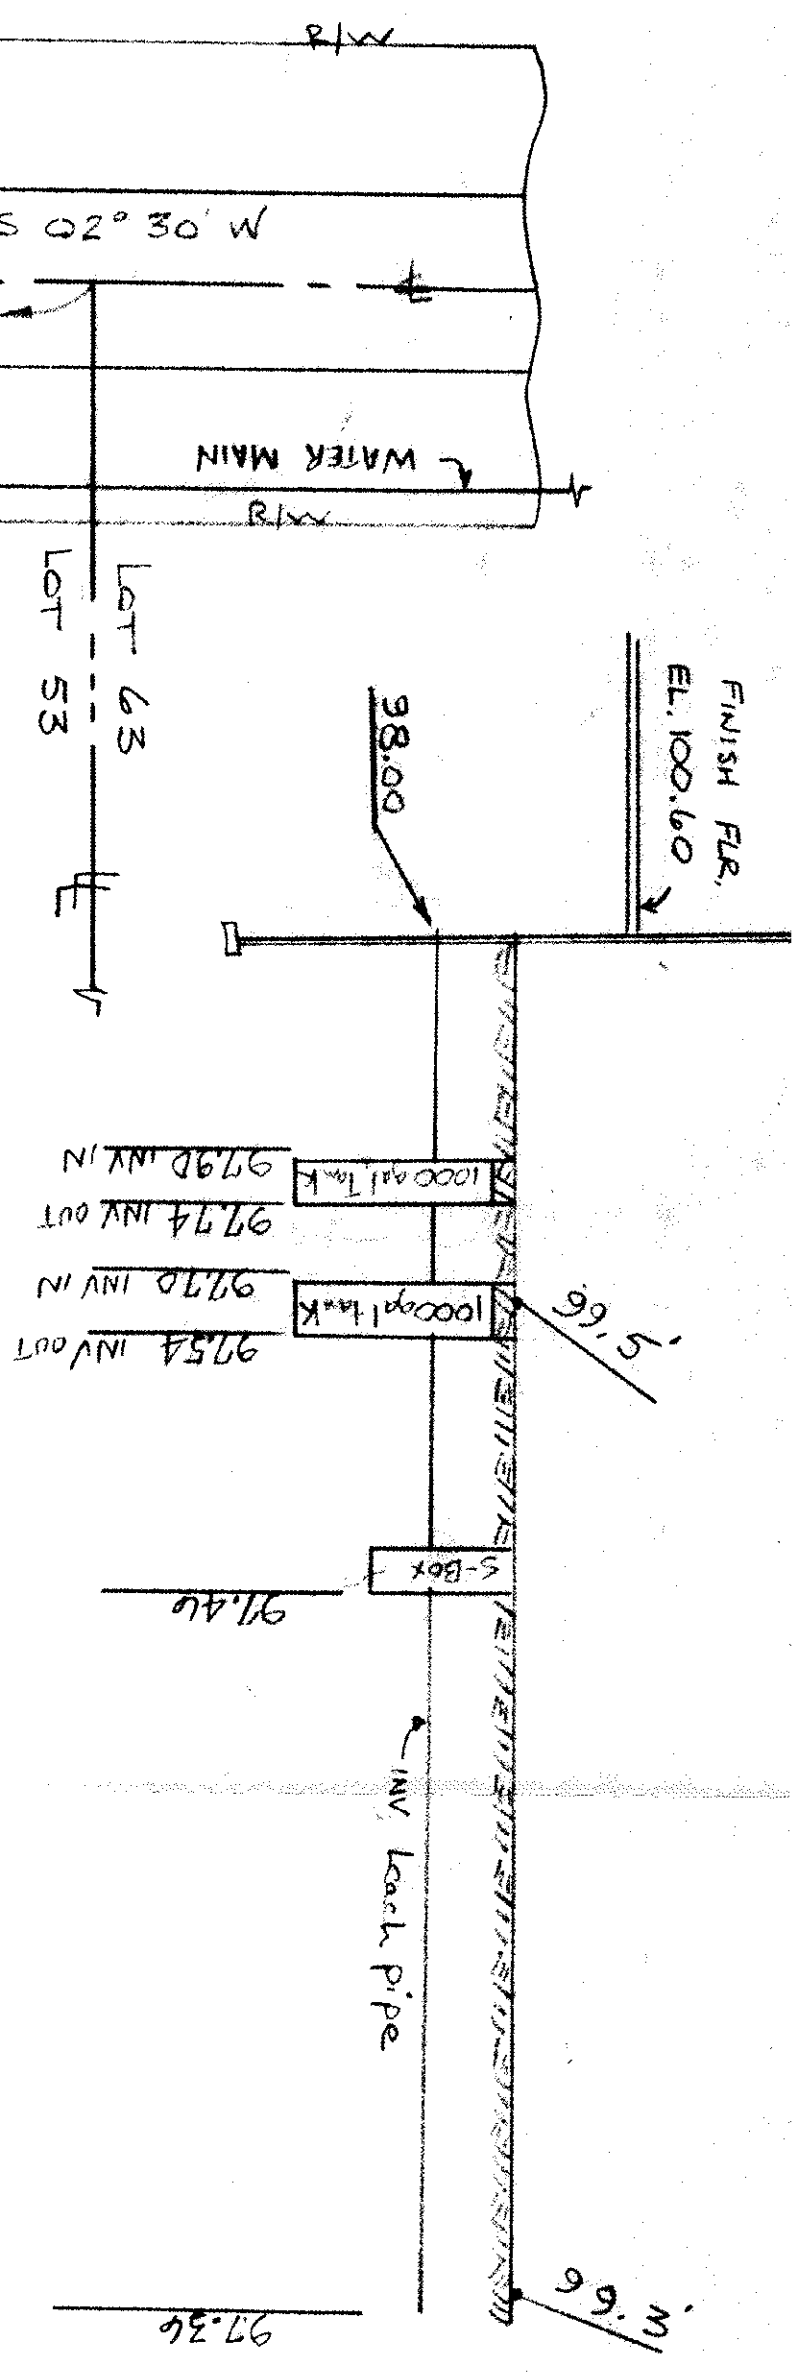

SITE PLAN FOR LEE LYDIC I

LEGEND:

- P PROPERTY LINE
- - - EXISTING CONTOUR
- - - PROPOSED CONTOUR
- 97.1 EXISTING ELEV.
- 98.0 PROPOSED ELEV.

SCALE 1" = 20 FT.

12 MARCH 1991

Grading Plan Approved
as shown and/or noted
THOMAS P. GILLESPIE
Lake County Engineer
By: GJH 3/19/91

APPROVED
SIDE LINES & SET BACK
PERRY TOWNSHIP ZONING
PERMIT NO. 4426
ZONING INSPECTOR: *[Signature]*

JIM PETER LAND SURVEY
4759 CROSBY-COOK RD.
ROME, OHIO 44005

