



SITUATED IN THE TOWNSHIP OF PERRY,
COUNTY OF LAKE AND STATE OF OHIO
AND KNOWN AS BEING SUBLLOT NO. 15
IN THE CANYON RIDGE SUBDIVISION,
PHASE 1, BEING A PART OF LOT NOS.
10 & 20 IN SAID COUNTY.

SCALE: 1" = 30'
March 14, 1996

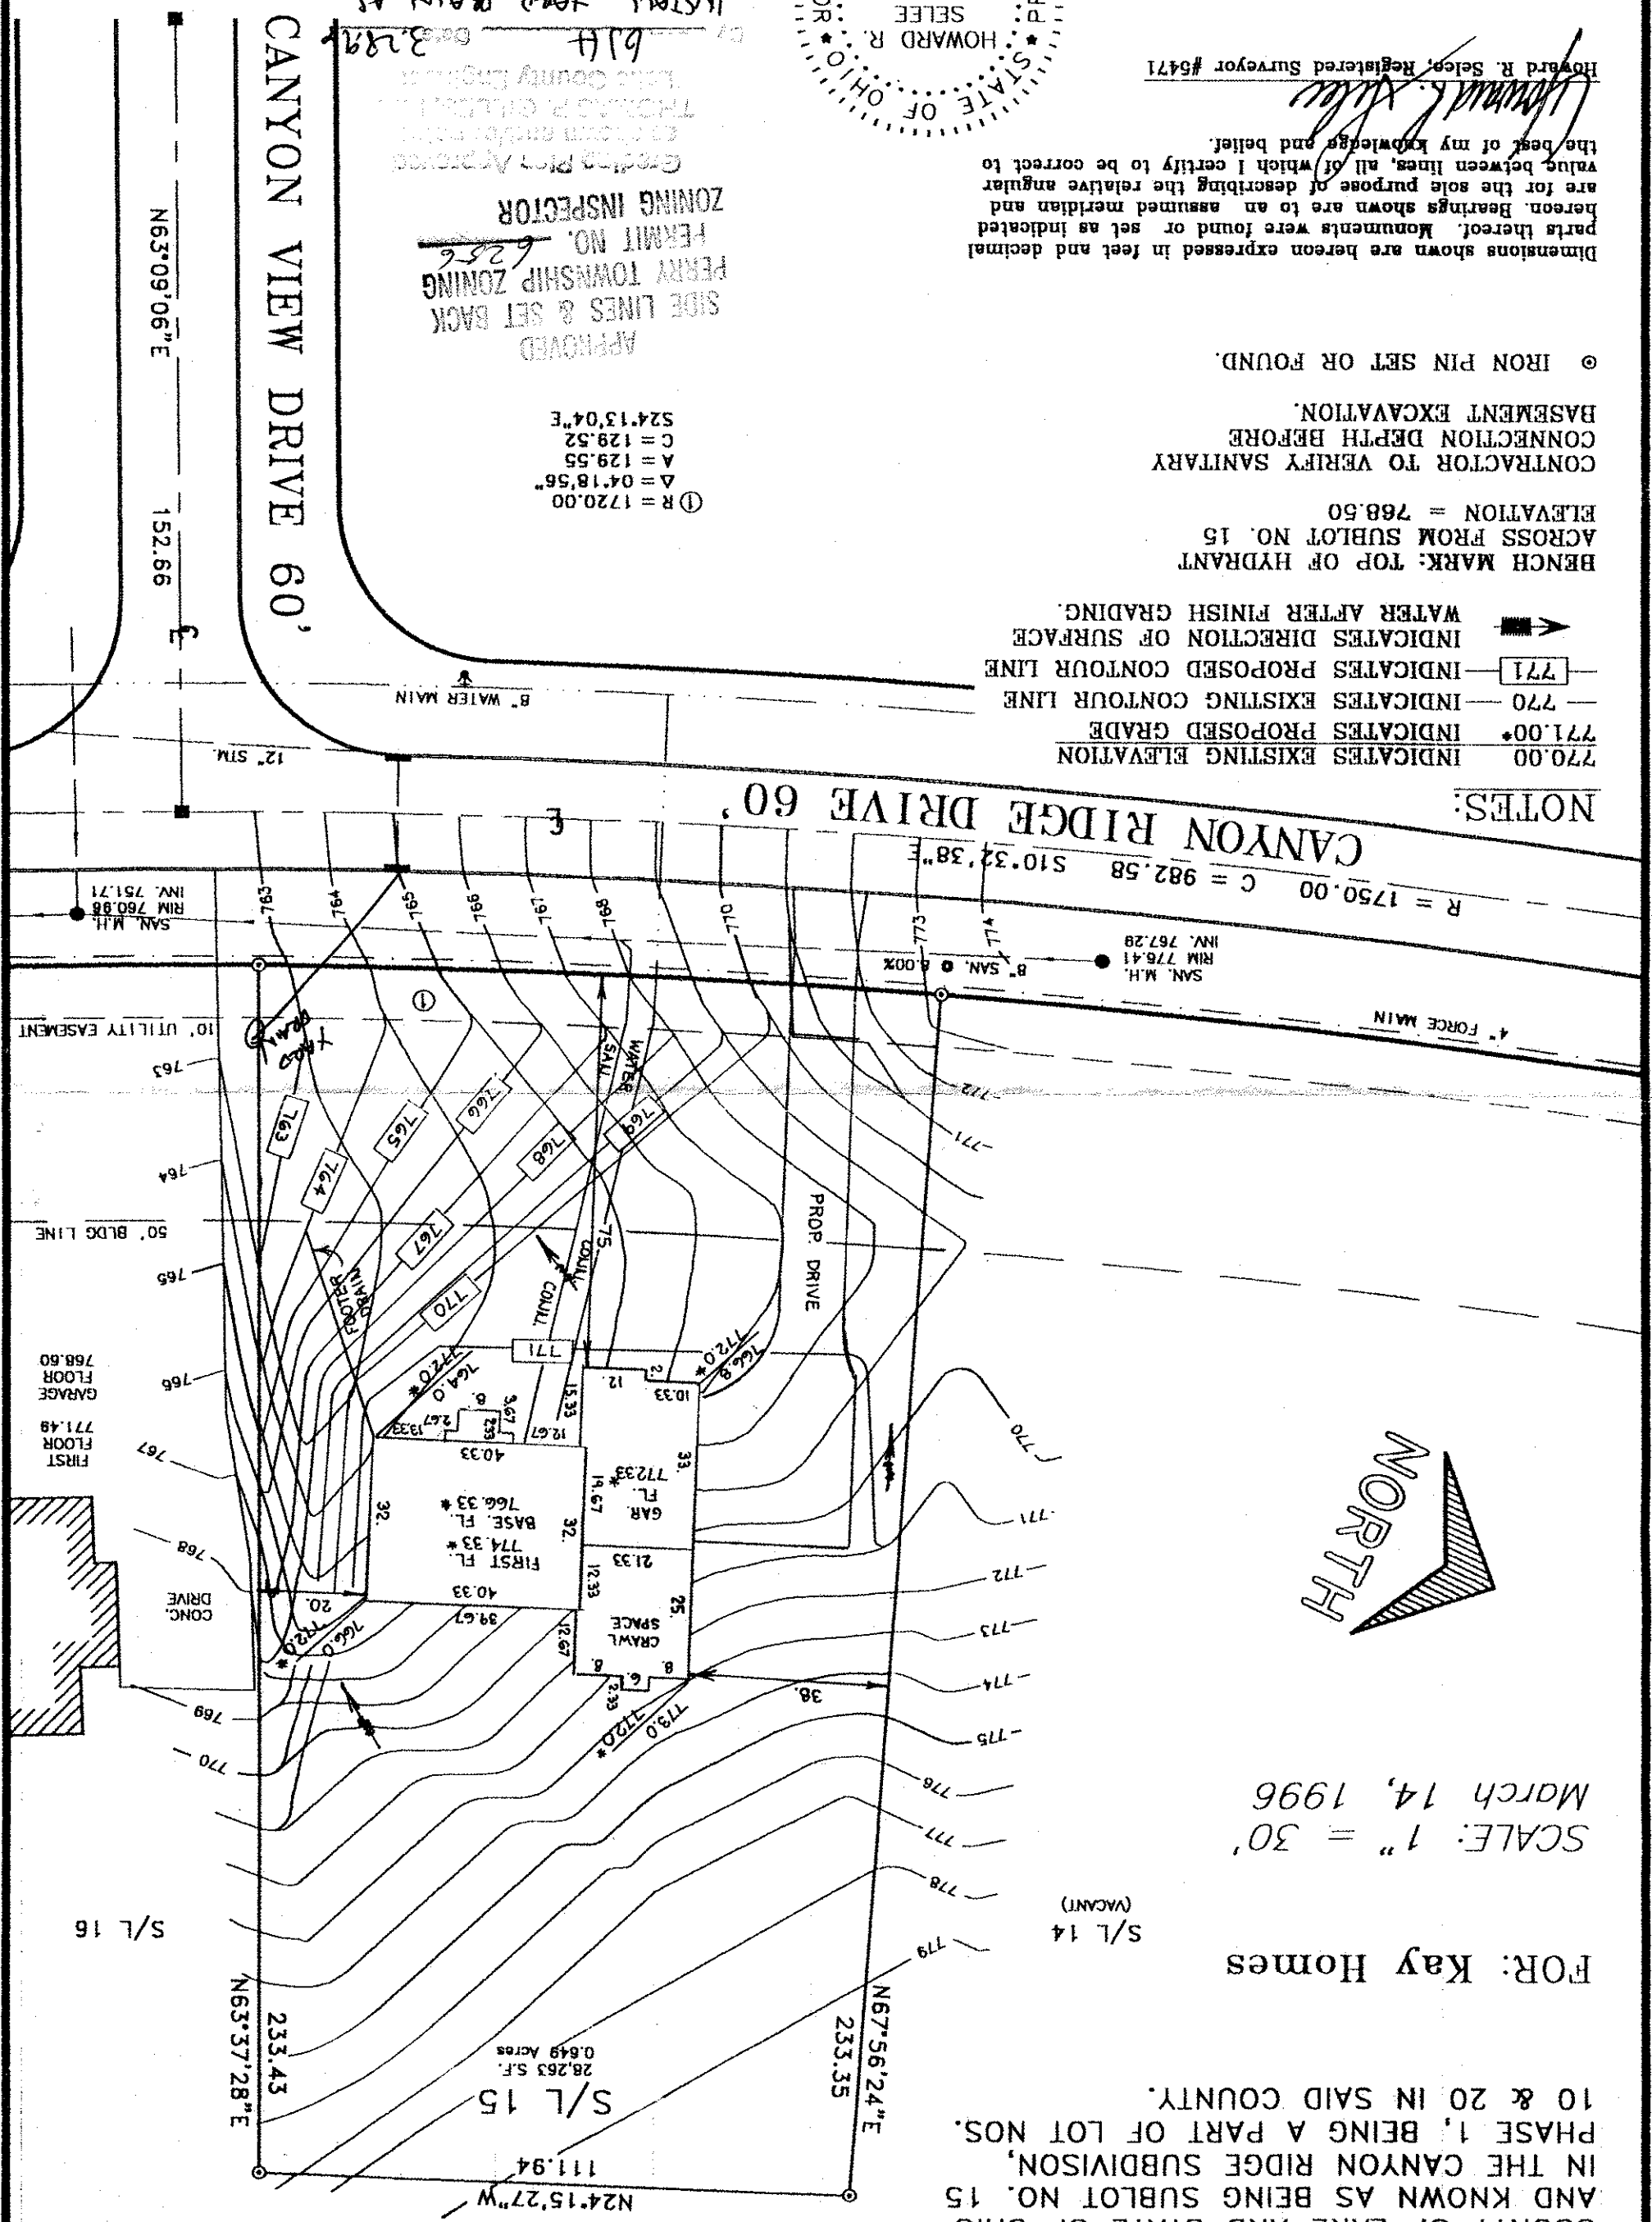

Dimensions shown are hereon expressed in feet and decimal parts thereof. Monuments were found or set as indicated hereon. Bearings shown are to an assumed meridian and are for the sole purpose of describing the relative angular value between lines, all of which I certify to be correct to the best of my knowledge and belief.

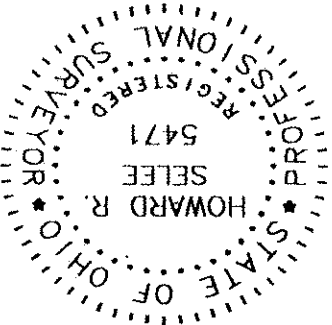

HOWARD R. SELEE & ASSOCIATES, INC.
PROFESSIONAL LAND SURVEYORS
9701 BROOKPARK ROAD * SUITE 251 * CLEVELAND, OH 44129 * (216)398-0280
File No. 96874-15