

SITE PLAN

PERRY TOWNSHIP, LAKE COUNTY, OHIO

for: NORN STEAH CLIENT OWNER 944-8200 (cell) 382-8921 (h)


ADDRESS STREET CITY ZIP

CANYON RIDGE SUB.	LOT	TRACT
SUBDIVISION 18-5	VOLUME	PAGE
VOL. 18-5	PERM. PARCEL NO.	STREET
SUBLOT NO. 10		

LEGEND	
SANITARY MANHOLE	WATER VALVE (GAS)
STORM MANHOLE	WATER METER (GAS)
INLET OR CATCH BASIN	AS BUILT ELEVATION
HYDRANT	INDICATES DIRECTION OF SURFACE DRAINAGE
EXISTING CONTOURS	
PROPOSED CONTOURS	
EXIST. ELEV. 100.0	PROP. ELEV. 100.0

REMARKS  
ALL BOUNDARY DATA SHOWN WAS OBTAINED FROM IDEEDS, RECORDED SUBDIVISION PLAT OR OTHER PUBLIC RECORDS  
LOCATIONS AS SHOWN OF ADJACENT WELLS AND SEPTIC TANKS OBTAINED FROM LAKE COUNTY HEALTH DEPARTMENT

DESIGN CERTIFICATION  
THIS PLAT WAS PREPARED BY ME, AND IS CORRECT TO THE BEST OF MY KNOWLEDGE AND BELIEF.  
NAME SURVEYOR REGISTRATION NO. 56343

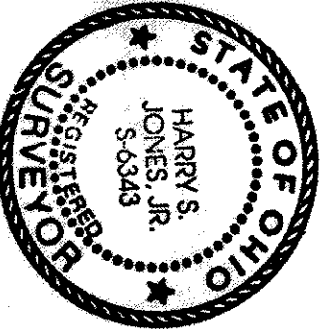

CHECK LIST	
NO. OF BEDROOMS	WATER MAIN SIZE, LOCATION
NO. OF BATHS	SEWER SIZE, % GR. LOC.
NO. OF GARAGES	SEWER, INH. CAST. ELEV., INV. ELEV.
NO. OF PORCHES	SEWER, CORR. SIZE LOC. DEPTH
NO. OF DRIVEWAYS	STORM INH. CAST. ELEV., INV. ELEV.
NO. OF STAIRS	STORM, CORR. SIZE LOC. DEPTH
NO. OF ROOFS	STORM, CORR. SIZE LOC. DEPTH
NO. OF FLOORS	STORM, CORR. SIZE LOC. DEPTH
NO. OF WALLS	STORM, CORR. SIZE LOC. DEPTH
NO. OF CEILINGS	STORM, CORR. SIZE LOC. DEPTH
NO. OF FLOORS	STORM, CORR. SIZE LOC. DEPTH
NO. OF WALLS	STORM, CORR. SIZE LOC. DEPTH
NO. OF CEILINGS	STORM, CORR. SIZE LOC. DEPTH

REVISIONS	
NO.	DATE BY
1	9-14-93 HY
2	
3	
4	
5	

DRAWN BY	SCALE 1" = 20'	PHONE NO.
CHKD.	DATE 6-17-93	DRAWING NO.
CREW	APPD.	91-233-110
CHIEF		

"AS BUILT" CERTIFICATION  
I, HEREBY CERTIFY THAT THE CIRCLED GRADES ARE EXISTING FINISH GRADES CHECKED IN THE FIELD ON 19 761.17 AND ARE CORRECT TO THE BEST OF MY KNOWLEDGE AND BELIEF.

REGISTERED SURVEYOR REG. NO. TEMP. BENCHMARK: 217 SAN M H 9/11/0, ELEV = 761.17

Grading Plan Approved as shown and/or noted THOMAS P. GILLES, P.E. Lake County Engineer By 611 Date 9.23.93

ROOF DRAINS SHALL DISCHARGE TO SPLASH BLOCKS. APPROVED SIDE LINES & SET BACK PERRY TOWNSHIP ZONING PERMIT NO. 4822 ZONING INSPECTOR

