



Grading Plan Approved
as Shown and/or noted
THOMAS P. GILLES, P.E.
Lake County Engineer

By 6/1/17 Date 5/19/16

ROOF DRAINS
SHALL DISCHARGE
TO SPLASH BLOCKS.


The topography, indicated by 1' contours, and elevations shown herein represent an actual field survey made by Foresight Engineering Group, Inc. on March 26, 1996. The elevations were taken at appropriate intervals and as of the above date they existed as indicated thereon.

Robert H. Wood
 Foresight Engineering Group, Inc.

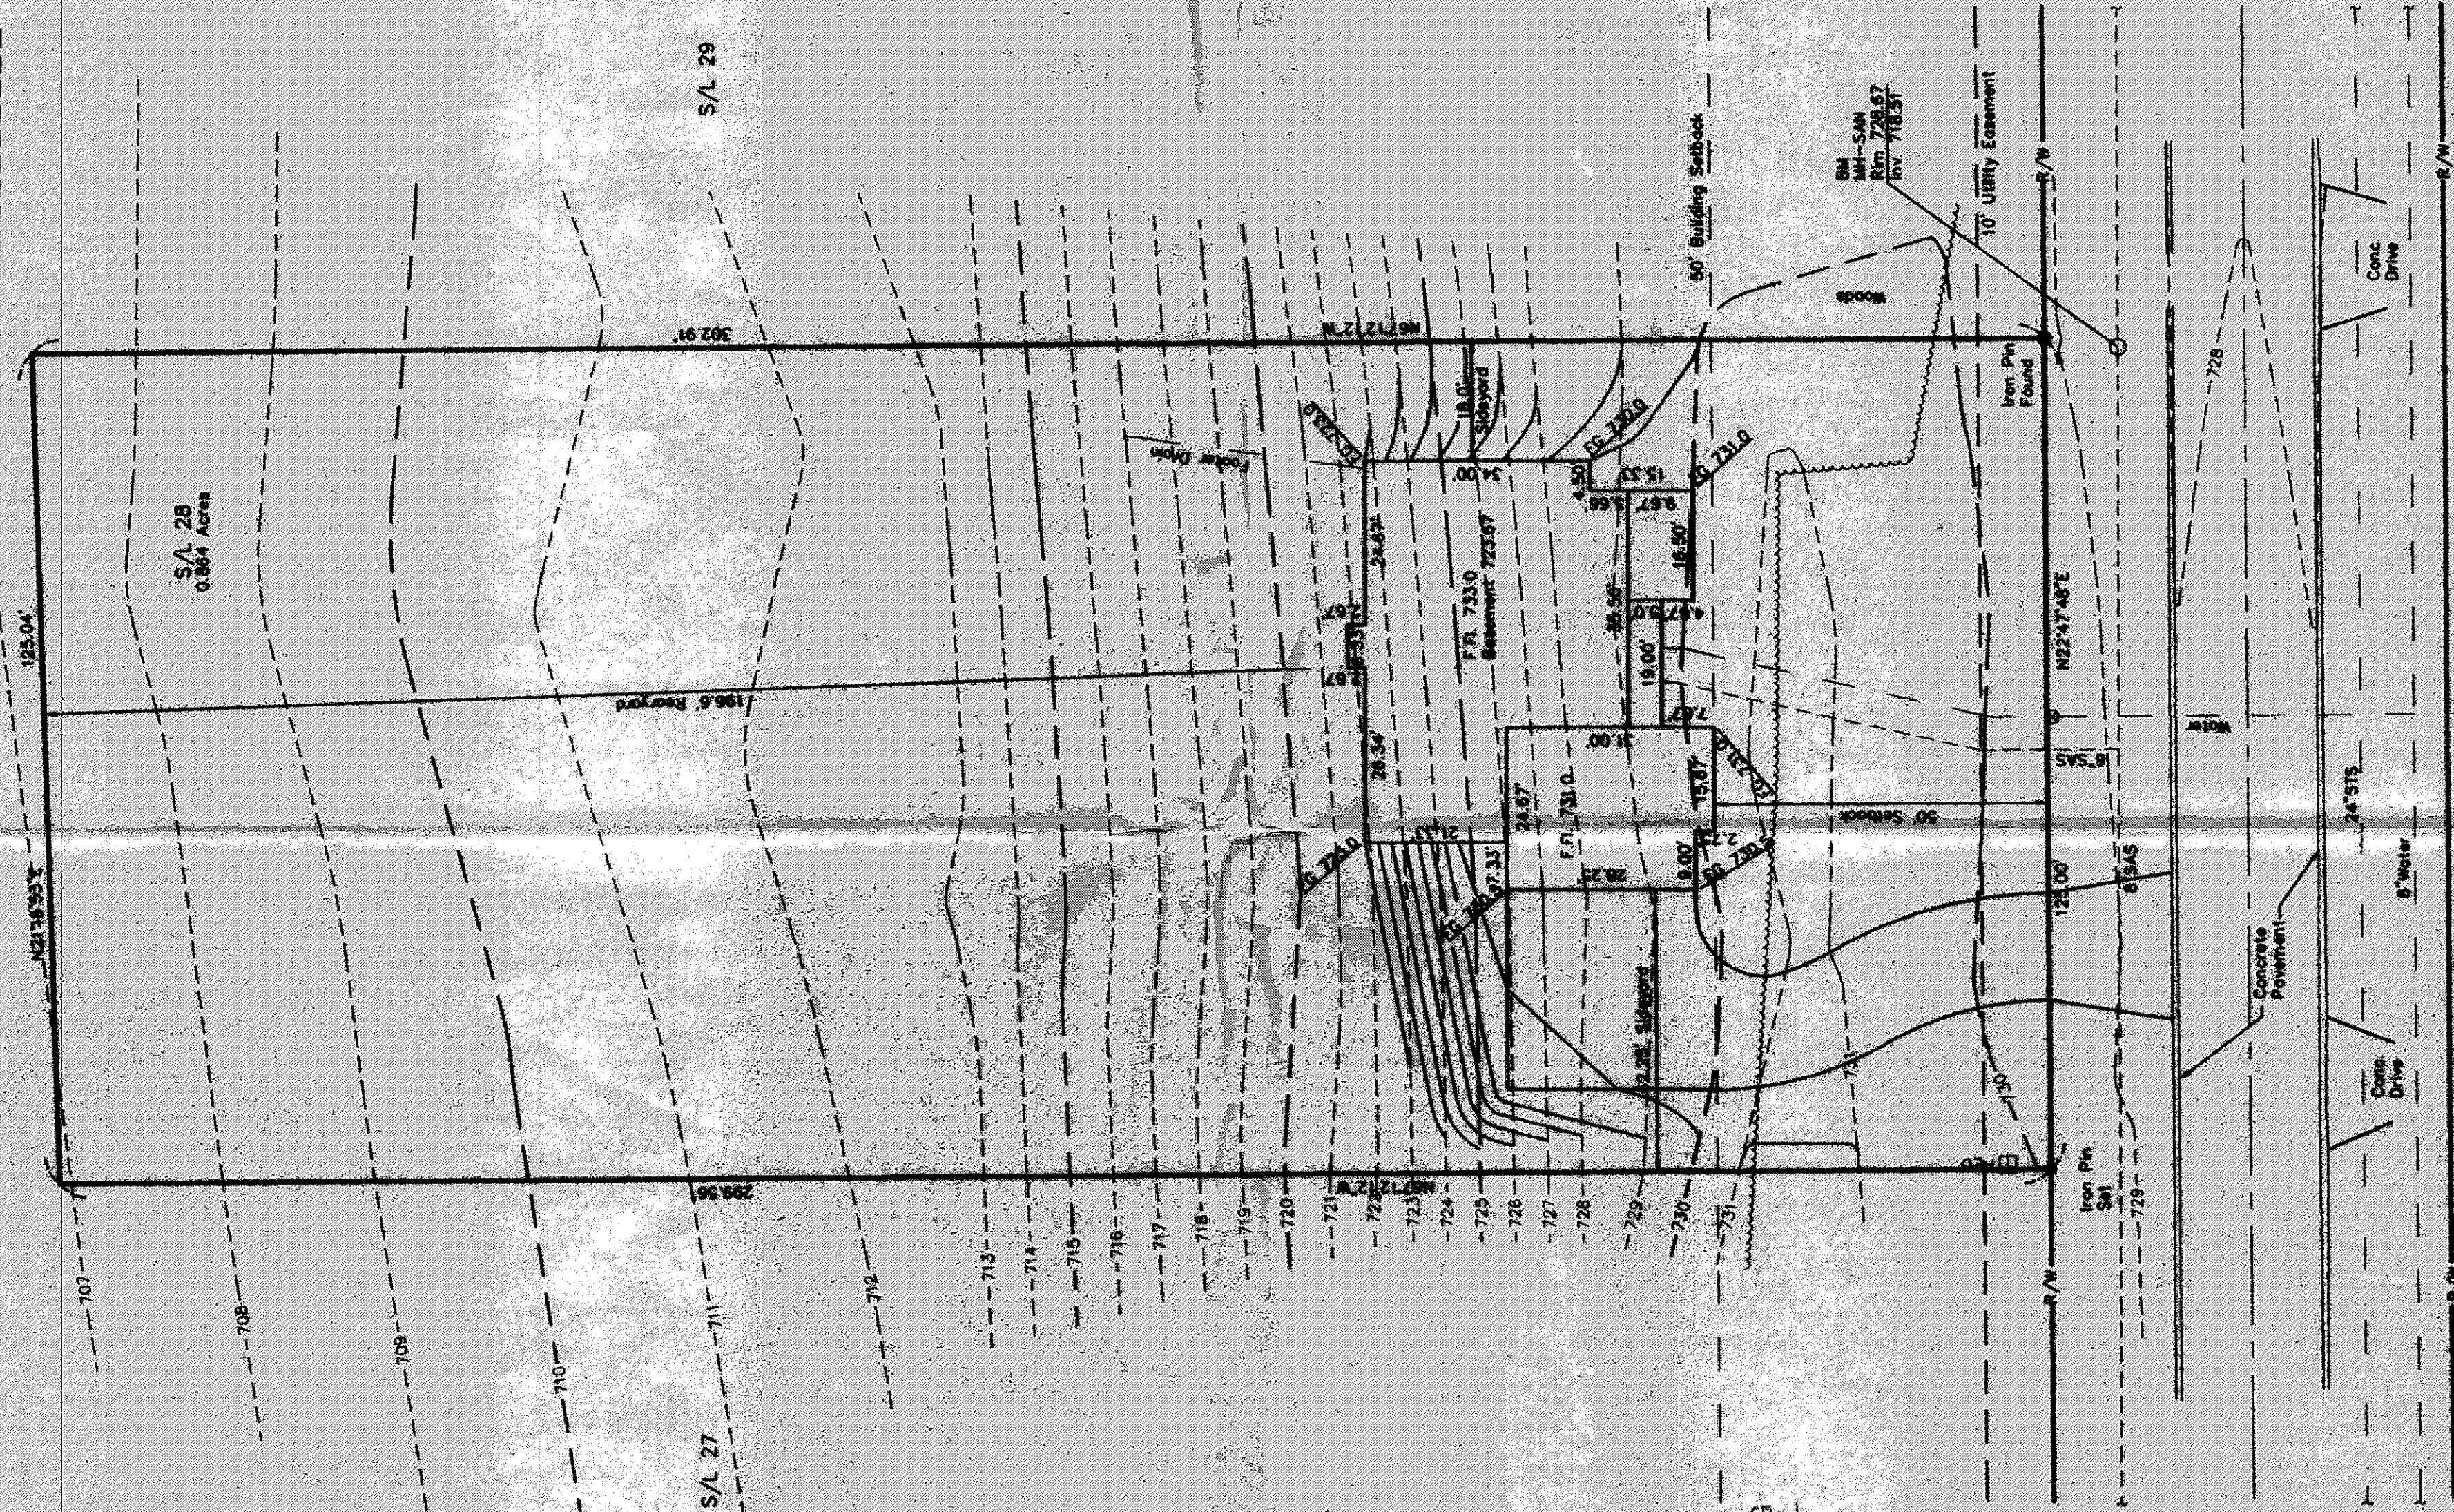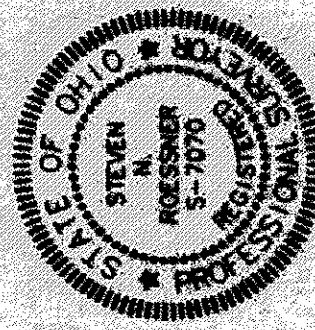

APPROVED
SIDE LINES & SET BACK
PERRY TOWNSHIP ZONING
PERMIT NO. 6280
ZONING INSPECTOR

SYMBOL LEGEND	
○	Manhole
●	Iron Pin Found
●	Water Service Valve
●	Telephone Service Box
●	Iron Pin Set

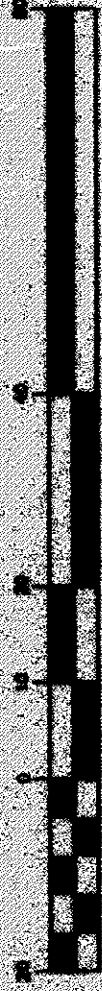

(IN FEET)
: inch = 20 ft.