

NOTE:
SPLASHBLOCK ALL DOWNSPOUTS




SAN. M.H.
RIM 776.41
INV. 767.29

BENCHMARK
TOP STEM OF HYD.
ELY. 768.57

APPROVED
SIDE LINES & SET BACK
PERRY TOWNSHIP ZONING
PERMIT NO. 6638
ZONING INSPECTOR

SAN. M.H.
RIM 760.96
INV. 749.67 8" OUT
Grading Plan Approved
as shown and/or noted
THOMAS P. GILLES, P.E.
Lago County Engineer

--- EXISTING GRADES
--- PROPOSED GRADES
--- SWALE
By W.H. Date 6.1.98

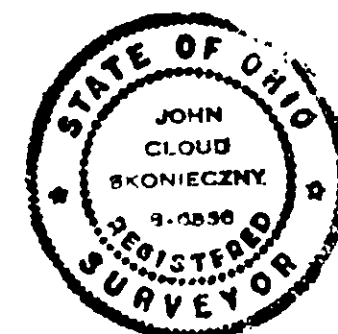

I CERTIFY THAT THIS PLAN
WAS PREPARED BY ME AND
IS CORRECT TO THE BEST OF
MY KNOWLEDGE AND BELIEF
John Skonieczny
REGISTERED SURVEYOR

JOHN SKONIECZNY
171 COLUMBIAN DR.
MADEIRA, OHIO 44033
714-277-7712

SITE PLAN FOR: WALTER ACKLEY INC.		
SCALE 1"=30'	APPROVED BY	DRAWN BY J.C.S.
DATE APR-08		REVISED
BEING SUBLOT 65 IN CANYON RIDGE SUBDIVISION No 1 AS RECORDED IN VOL. 18-5-3 OF THE L.C.R.P. TOWNSHIP OF PERRY COUNTY OF LAKE STATE OF OHIO		
JOB# 98-2587		DRAWING NUMBER 98-1665