


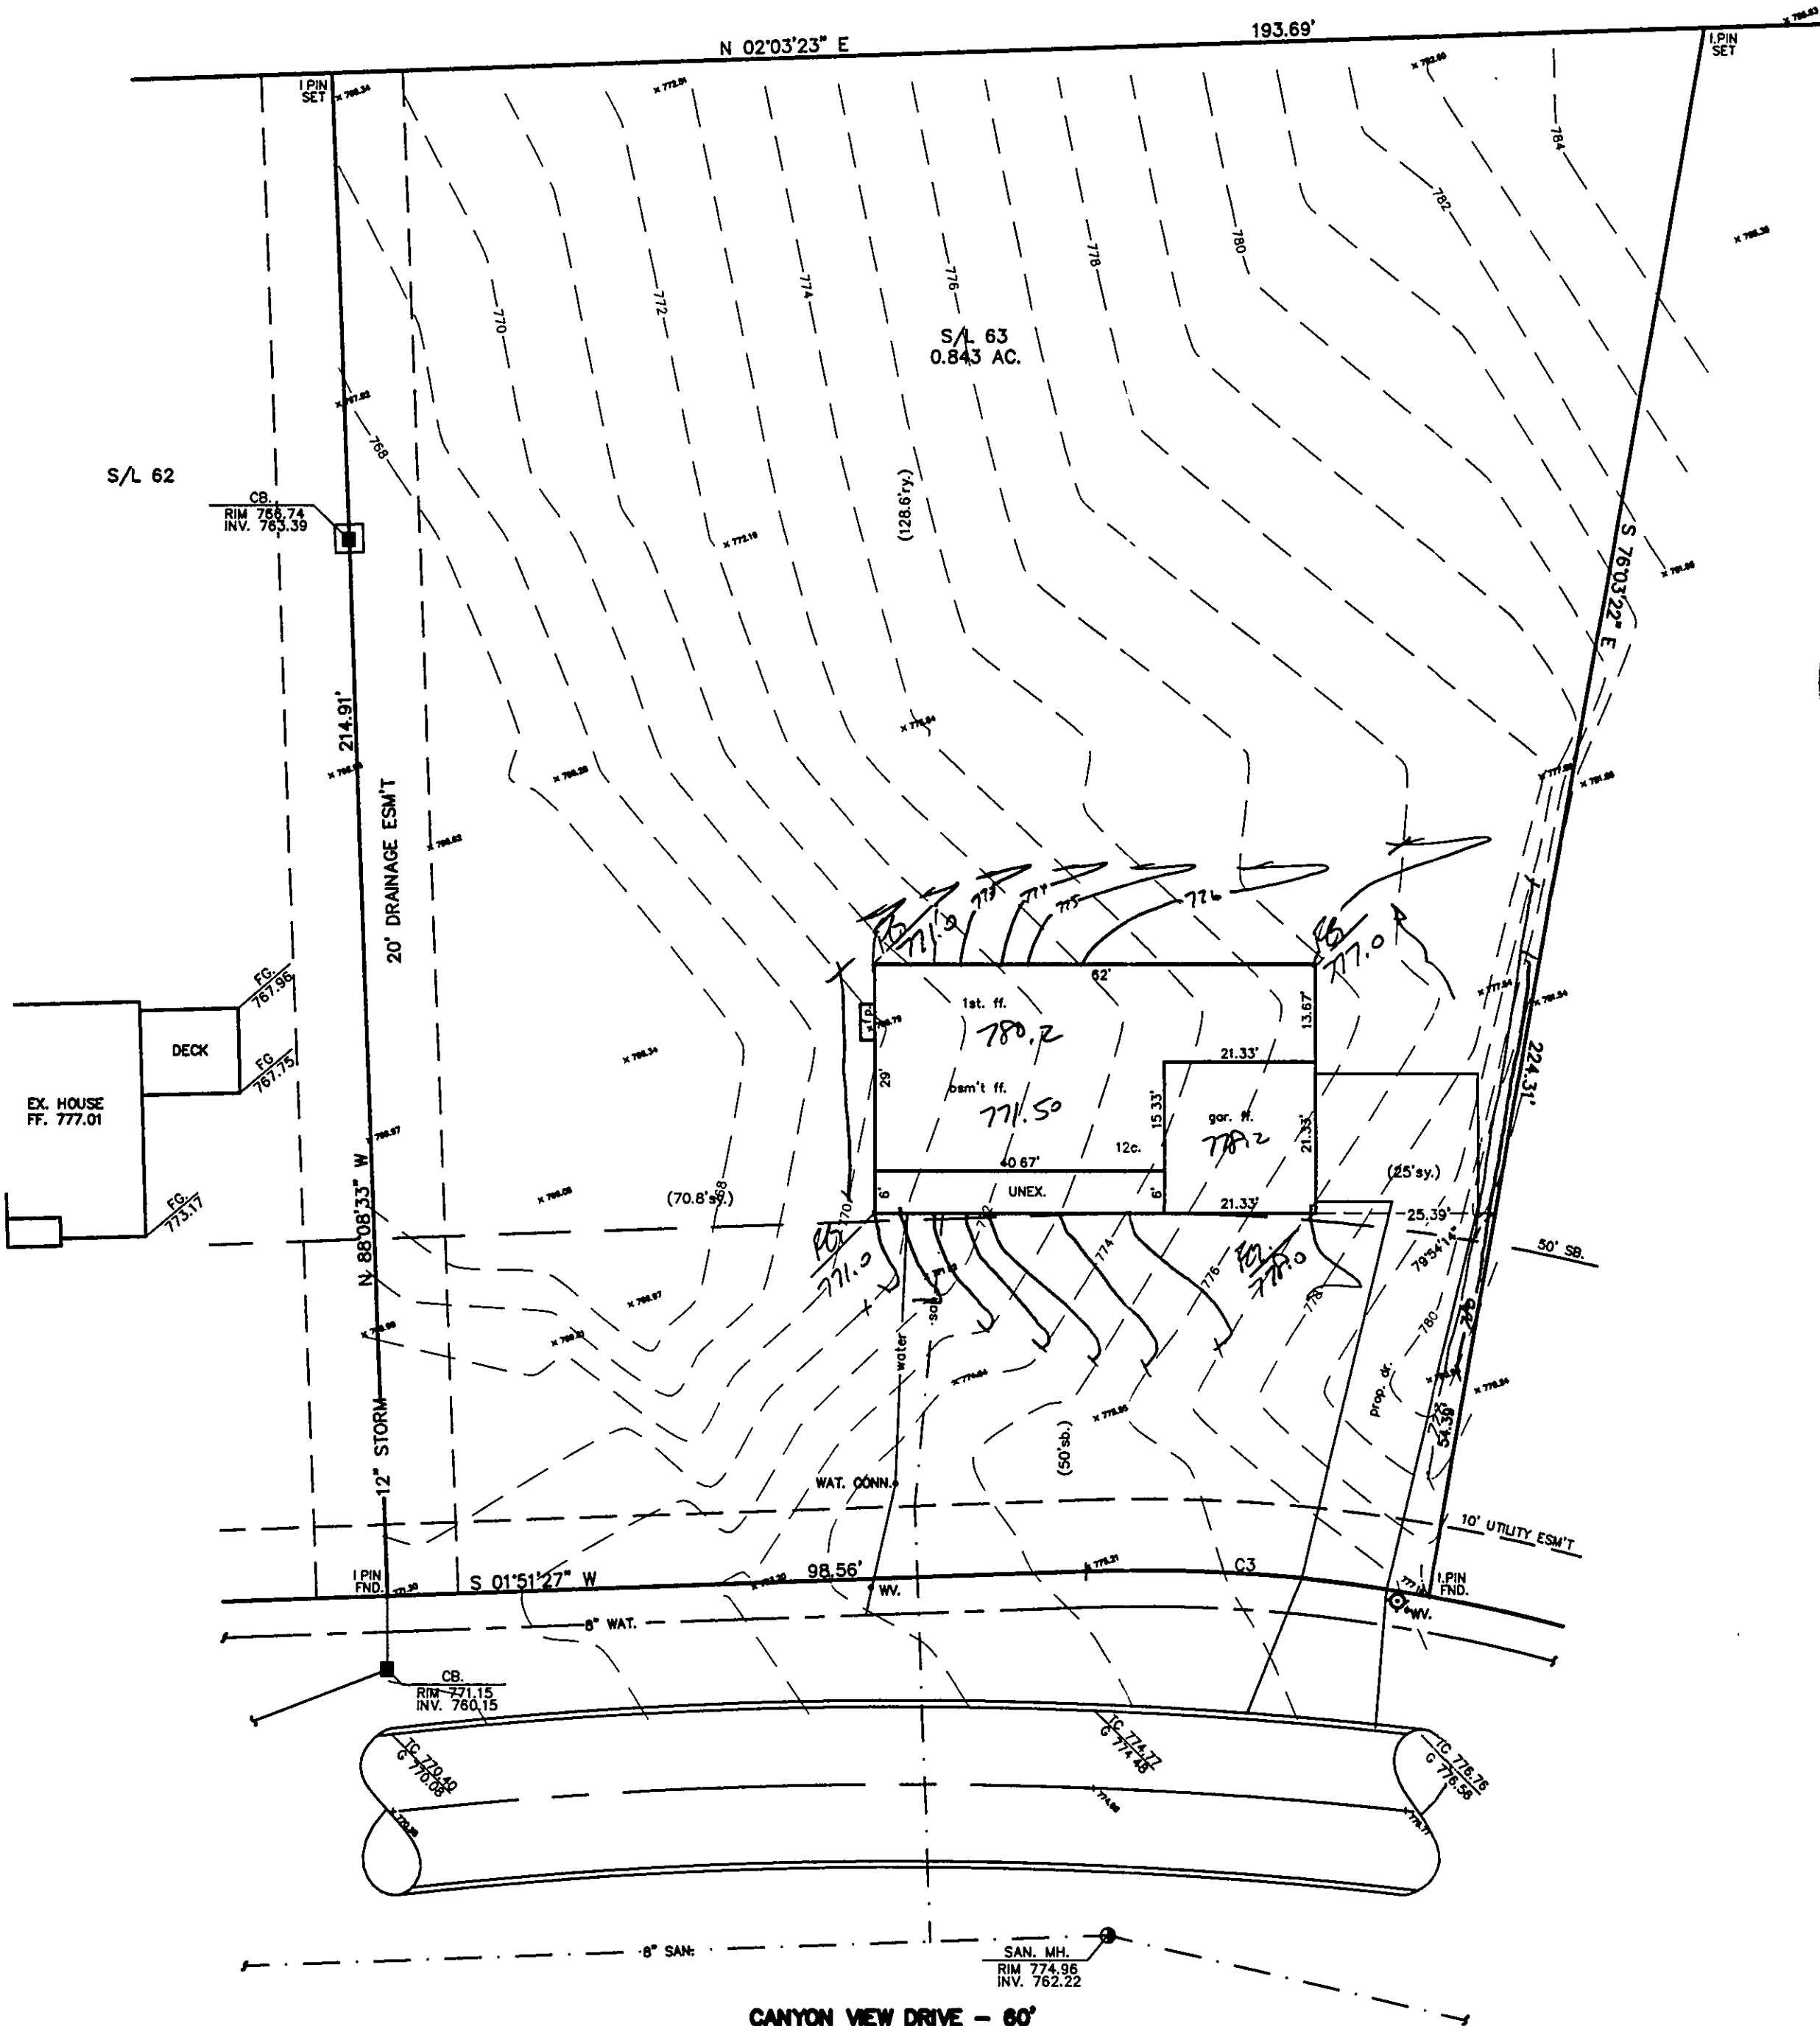

SITE PLAN
PERRY TOWNSHIP, LAKE COUNTY, OHIO
for: PAVLISIN BUILDERS, INC.

CLIENT		OWNER	
ADDRESS	STREET	CITY	ZIP
CANYON RIDGE		NAME	TRACT
SUBDIVISION	26-10	LOT	STREET
63	VOL-PG.	CANYON VIEW	VOL-PG.
SUBLOT NO.	STREET	PERM. PARCEL NO.	

LEGEND

SANITARY MANHOLE	---○---
STORM MANHOLE	---●---
INLET OR CATCH BASIN	---■---
HYDRANT	---○---
EXISTING CONTOURS	---○---
PROPOSED CONTOURS	---○---

AS BUILT ELEVATION
INDICATES DIRECTION OF SURFACE DRAINAGE

REMARKS
ALL BOUNDARY DATA SHOWN WAS OBTAINED FROM (DEEDS, RECORDED SUBDIVISION PLAT OR OTHER PUBLIC RECORDS)
LOCATIONS AS SHOWN OF ADJACENT WELLS AND SEPTIC TANKS OBTAINED FROM LAKE COUNTY HEALTH DEPARTMENT

DESIGN CERTIFICATION
THIS PLAT WAS PREPARED BY ME, AND IS CORRECT TO THE BEST OF MY KNOWLEDGE AND BELIEF.
NAME: Harry S. Jones, Jr. SURVEYOR REGISTRATION NO. 6343

CHECK LIST	
NO. OF BEDROOMS	WATER MAIN SIZE, LOCATION
DIMENSIONS	SAN. SEWER SIZE & GR. LOC.
BEARINGS	SAN. MH. CAST. ELEV. INV. ELEV.
TIE TO NEAREST STREET	SAN. CONN. SIZE, LOC. DEPTH
SUBLOT NO. PARCEL NO.	STORM SEWER SIZE & GR. LOC.
SURROUNDING OWNERS	STORM MH. CAST ELEV. INV. ELEV.
BLDG. DIMENSIONS FIN GR.	PAVT TYPE GRADE CURBS
BLDG. TIES FLTR. GRADES	GAS LINE LOC. SIZE PRESSURE
APRON TYPE WIDTH THICKNESS	SEPTIC TANK LOCATION & DUPLICATION AREA
SIDEWALK TYPE WIDTH THICKNESS	WELL LOCATION
CULVERT TYPE DIA., LENGTH	ISOLATION RADIUS FROM WELL
ROCK OUTCROPPINGS	

REVISIONS			PLAN PREPARED BY:	
NO.	DATE	BY	BABCOCK JONES & ASSOCIATES, INC.	
			PAINESVILLE, OHIO	
1			DRAWN BY T.R.	SCALE 1"=20'
2			CHK'D. H.J.	DATE 7/21/98
3			CREW CHIEF K.J.	APP'D H.J.
4				PHONE NO. 440-357-1811
5				DRAWING NO. 91-233-63

"AS BUILT" CERTIFICATION
I, HEREBY CERTIFY THAT THE CIRCLED GRADES ARE EXISTING FINISH GRADES CHECKED IN THE FIELD ON _____, 19____ AND ARE CORRECT TO THE BEST OF MY KNOWLEDGE AND BELIEF.

REGISTERED SURVEYOR REG. NO.

TBM-TOP HYDRANT S/L 61
ELEV. = 775.40

C3: R=230.00'
L=48.52'
T=24.35'
C=48.43'
D=12'05"11"
S07°54'03"W

APPROVED
SIDE LINES & SET BACK
PERRY TOWNSHIP ZONING
PERMIT NO. 6685
ZONING INSPECTOR

Grading Plan Approved
as shown and/or not
THOMAS P. GILLES, P.E.
Lake County Engineer

By GJH Date 8.5.98